


No. 5L-458
 POTTSVILLE'S
 VETERAN'S
 MEMORIAL
 STADIUM

0.6 L.
 B.M.S.
 S.W.M.

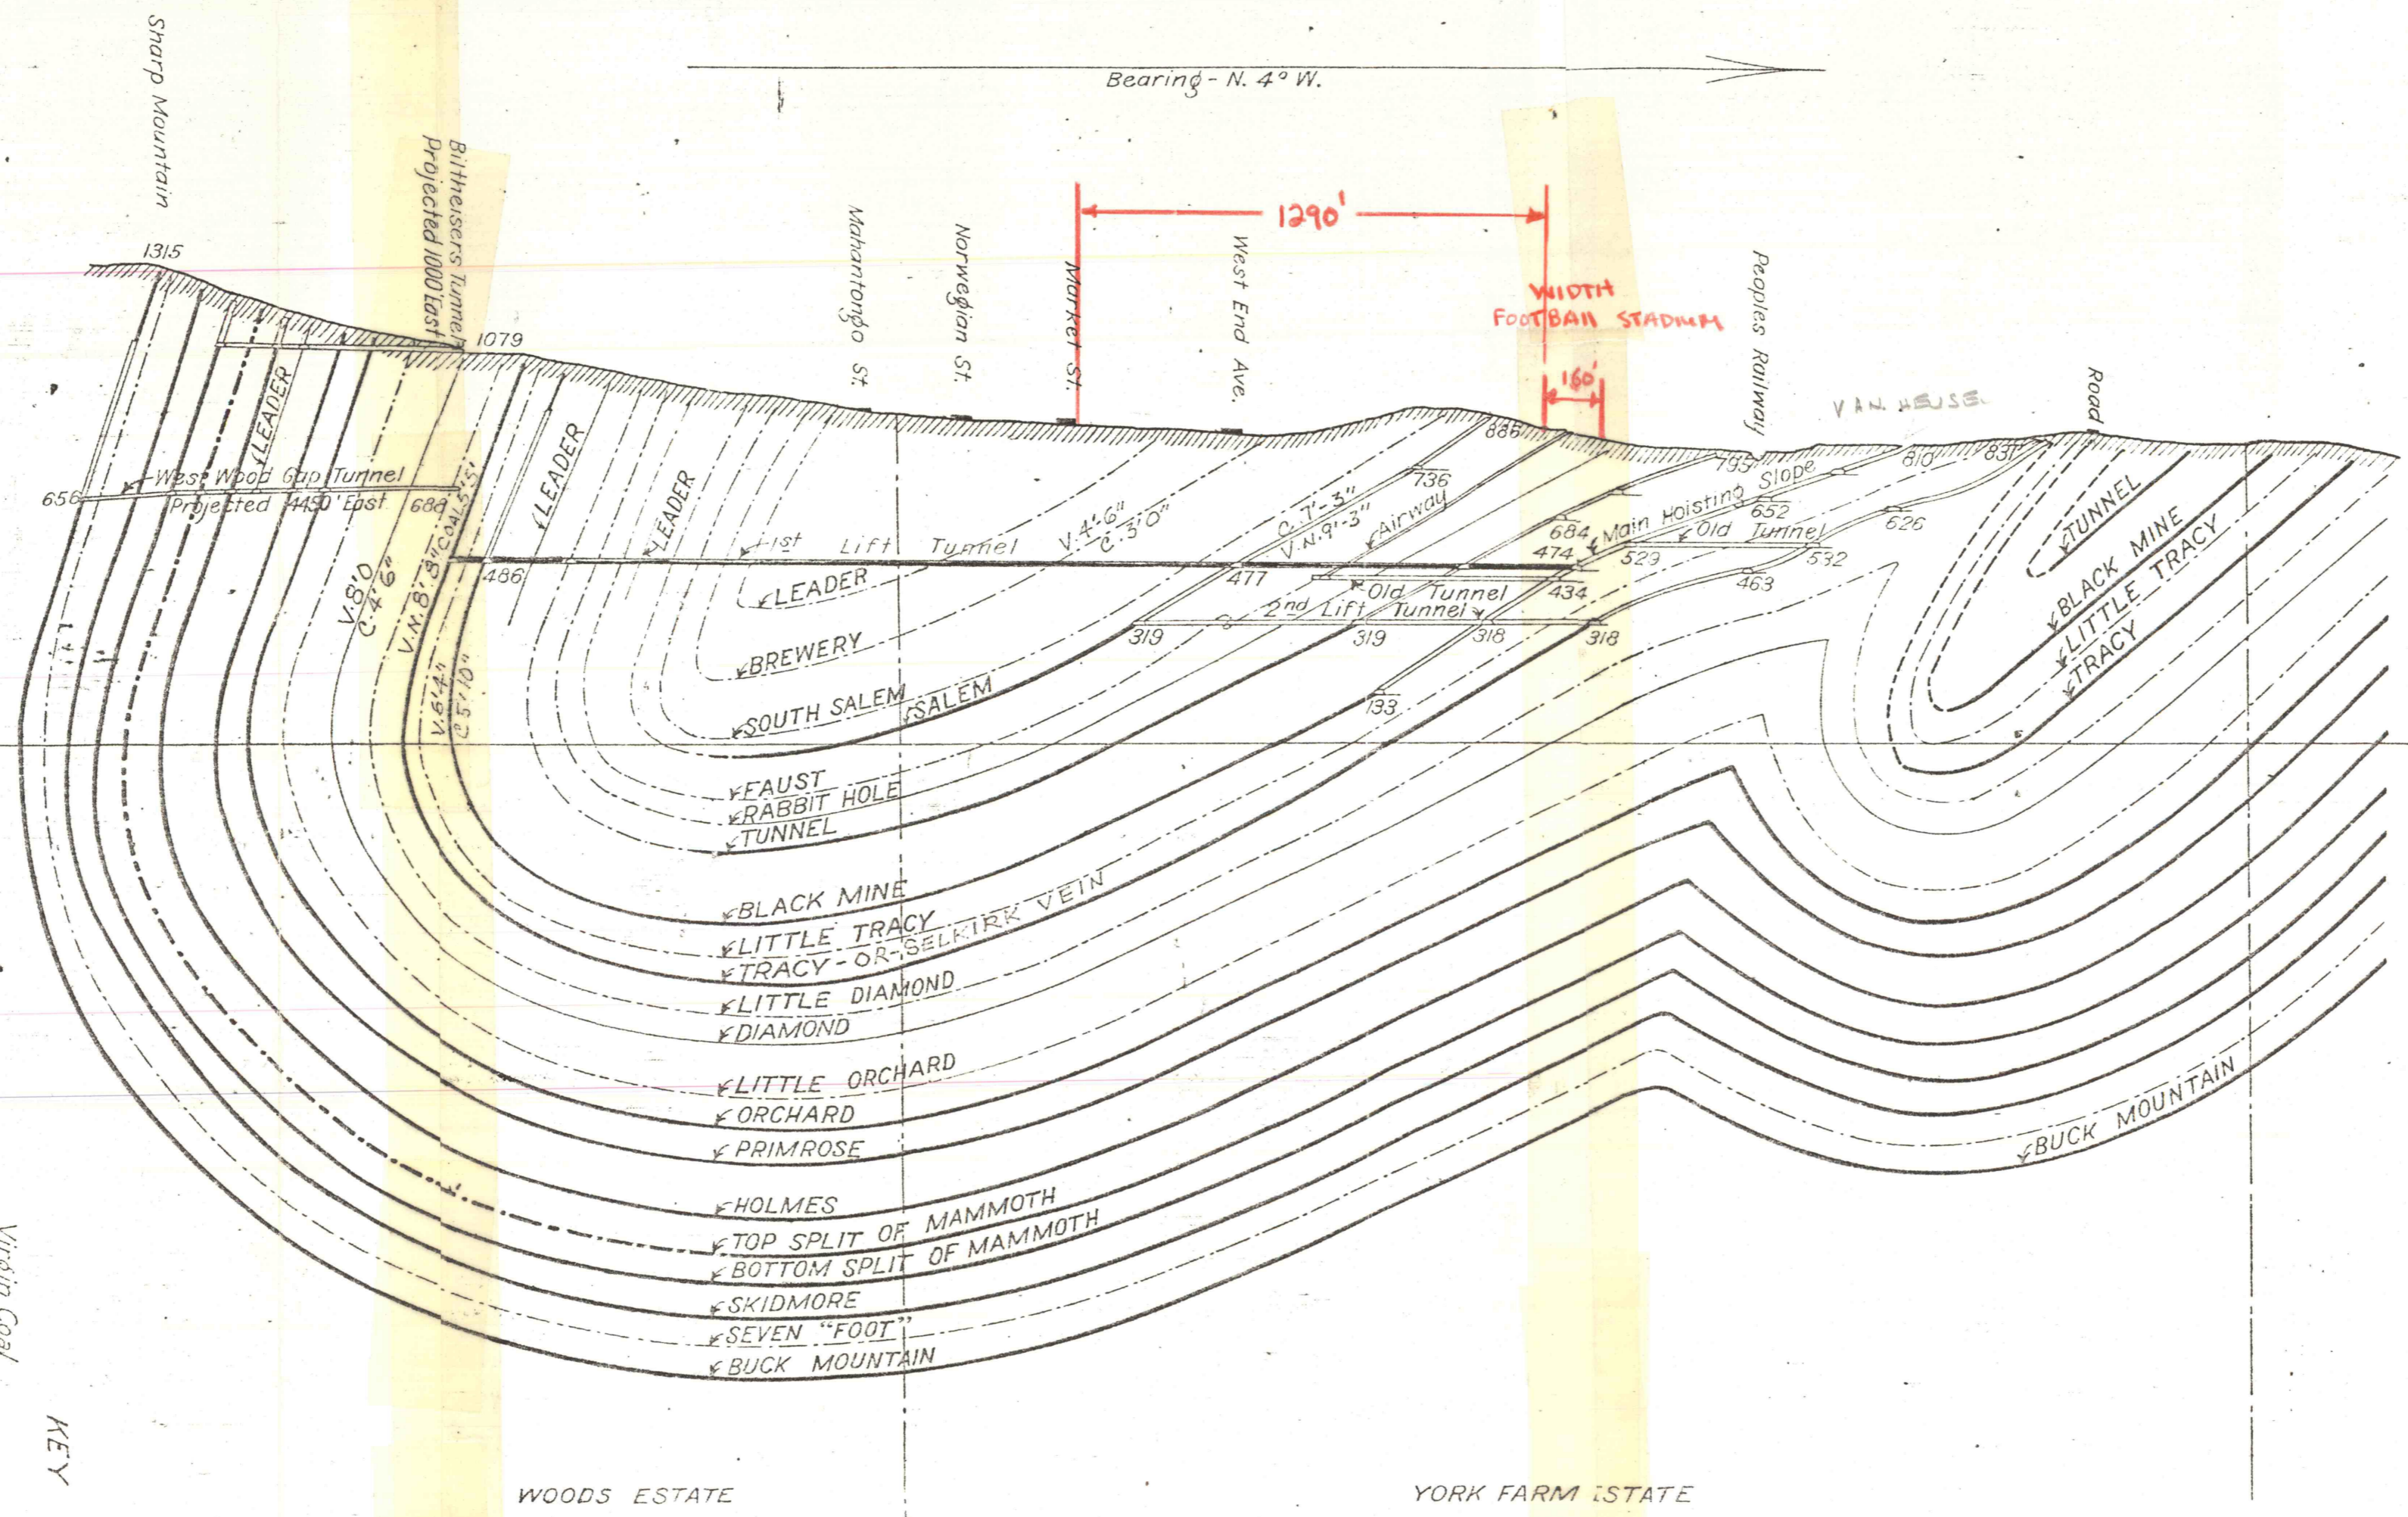

DATUM LINE = MID-TIDE.

P. & R. C. & I. CO.

NOTE:-
 Traced from drawings furnished by
 W. A. Cochran, dated June 27, 1916.

KEY
 Virgin Coal
 Partly or Entirely Exhausted
 Unworkable

LEHIGH VALLEY COAL CO.
 VALUATION JUNE 30, 1915.

CROSS SECTIONS AT
 YORKVILLE PROPERTY

SCALE IN FEET
 0 400 800 1200

July 3, 1916.

Direction of
 J. Williams
 Engineer
 New York