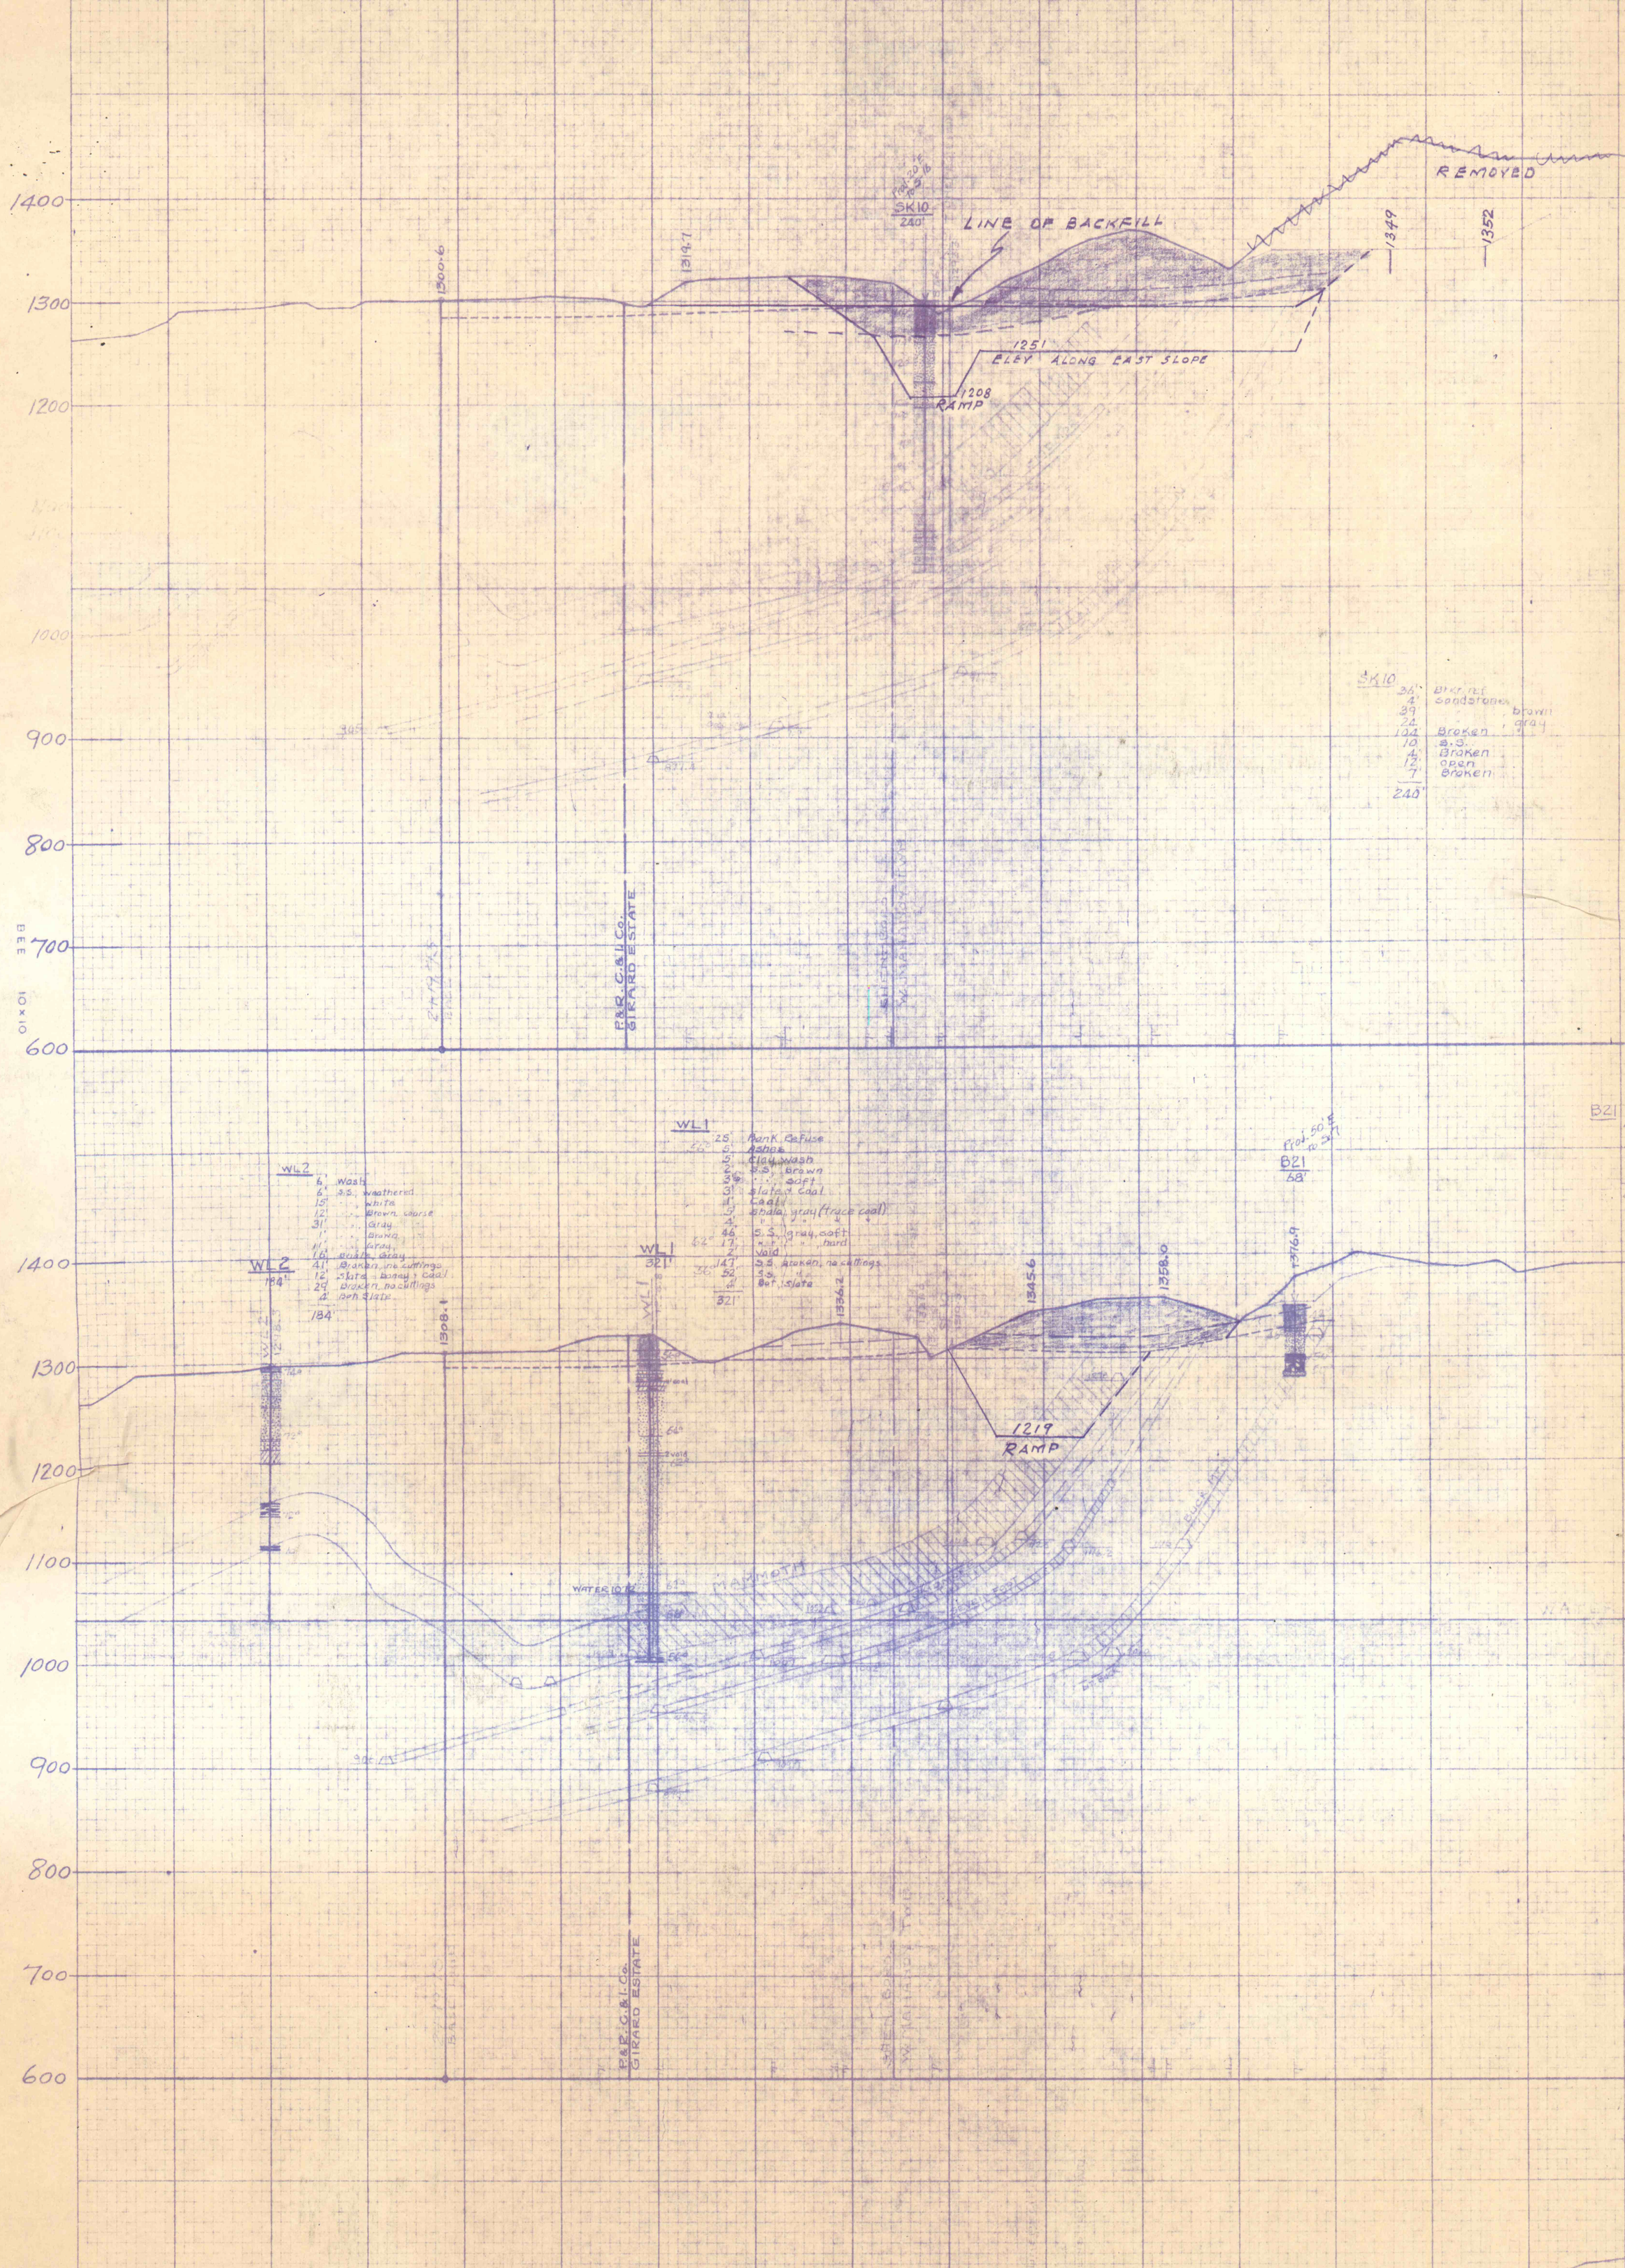
1400
1300
1200
1000
900
800
700
600
1100
1300.6
1314.7
SK10
240'
LINE OF BACKFILL
1349
1352
REMOVED
1251
ELEV ALONG EAST SLOPE
1208
RAMP
SK10
36' Brkn. rock
4' sandstone
39 " brown
24 " gray
104 Broken
10 S.S.
4' Broken
12' open
7' Broken
240'
P&R. C&I Co.
GIRARD ESTATE
WL2
6' Wash
6' S.S. weathered
15' " white
12' " Brown, coarse
31' " Gray
1' " Brown
11' " Gray
16' Slate, Gray
41' Broken, no cuttings
12' Slate, Bony + Coal
29' Broken, no cuttings
4' Bet. Slate
184'
WL2
184'
1308.1
WL1
321'
WL1
25' Bank Refuse
5' Ashes
5' Clay, wash
2' S.S. brown
3' " soft
3' Slate + Coal
1' Coal
5' Shale, gray (trace coal)
4' " " "
46' S.S. gray, soft
17' " " " hard
2' Void
147' S.S. broken, no cuttings
52' S.S.
Bet. Slate
321'
1336.2
1345.6
1358.0
1376.9
1219
RAMP
B21
68'
WATER LOT 2
MAMMOTH
P&R.C.&I.Co.
GIRARD ESTATE