



CHANNEL "O"
Scale: 1 in. = 5 ft.

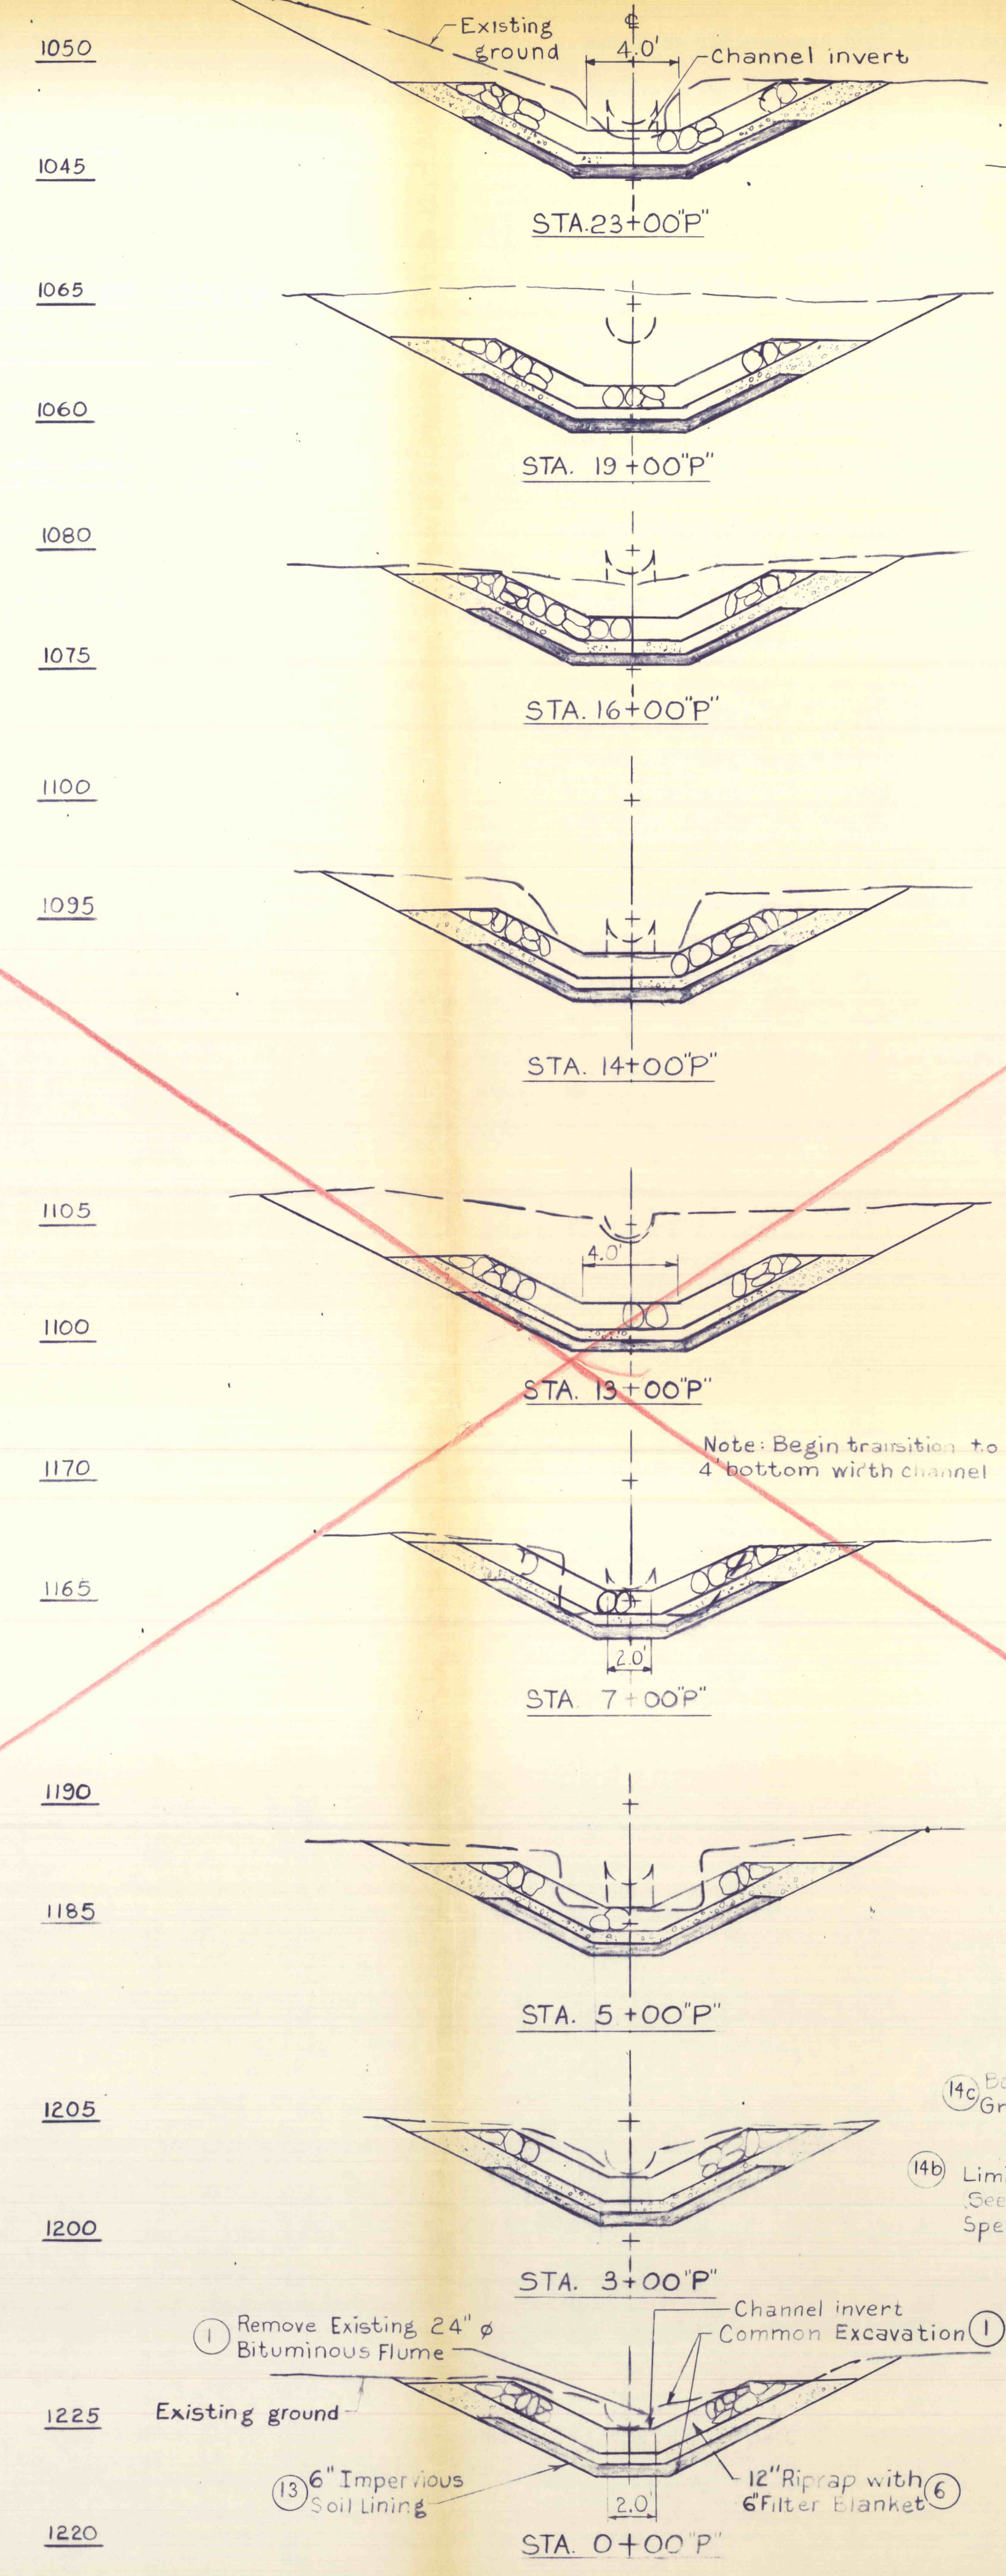


CHANNEL "P"
Scale: 1 in. = 5 ft.

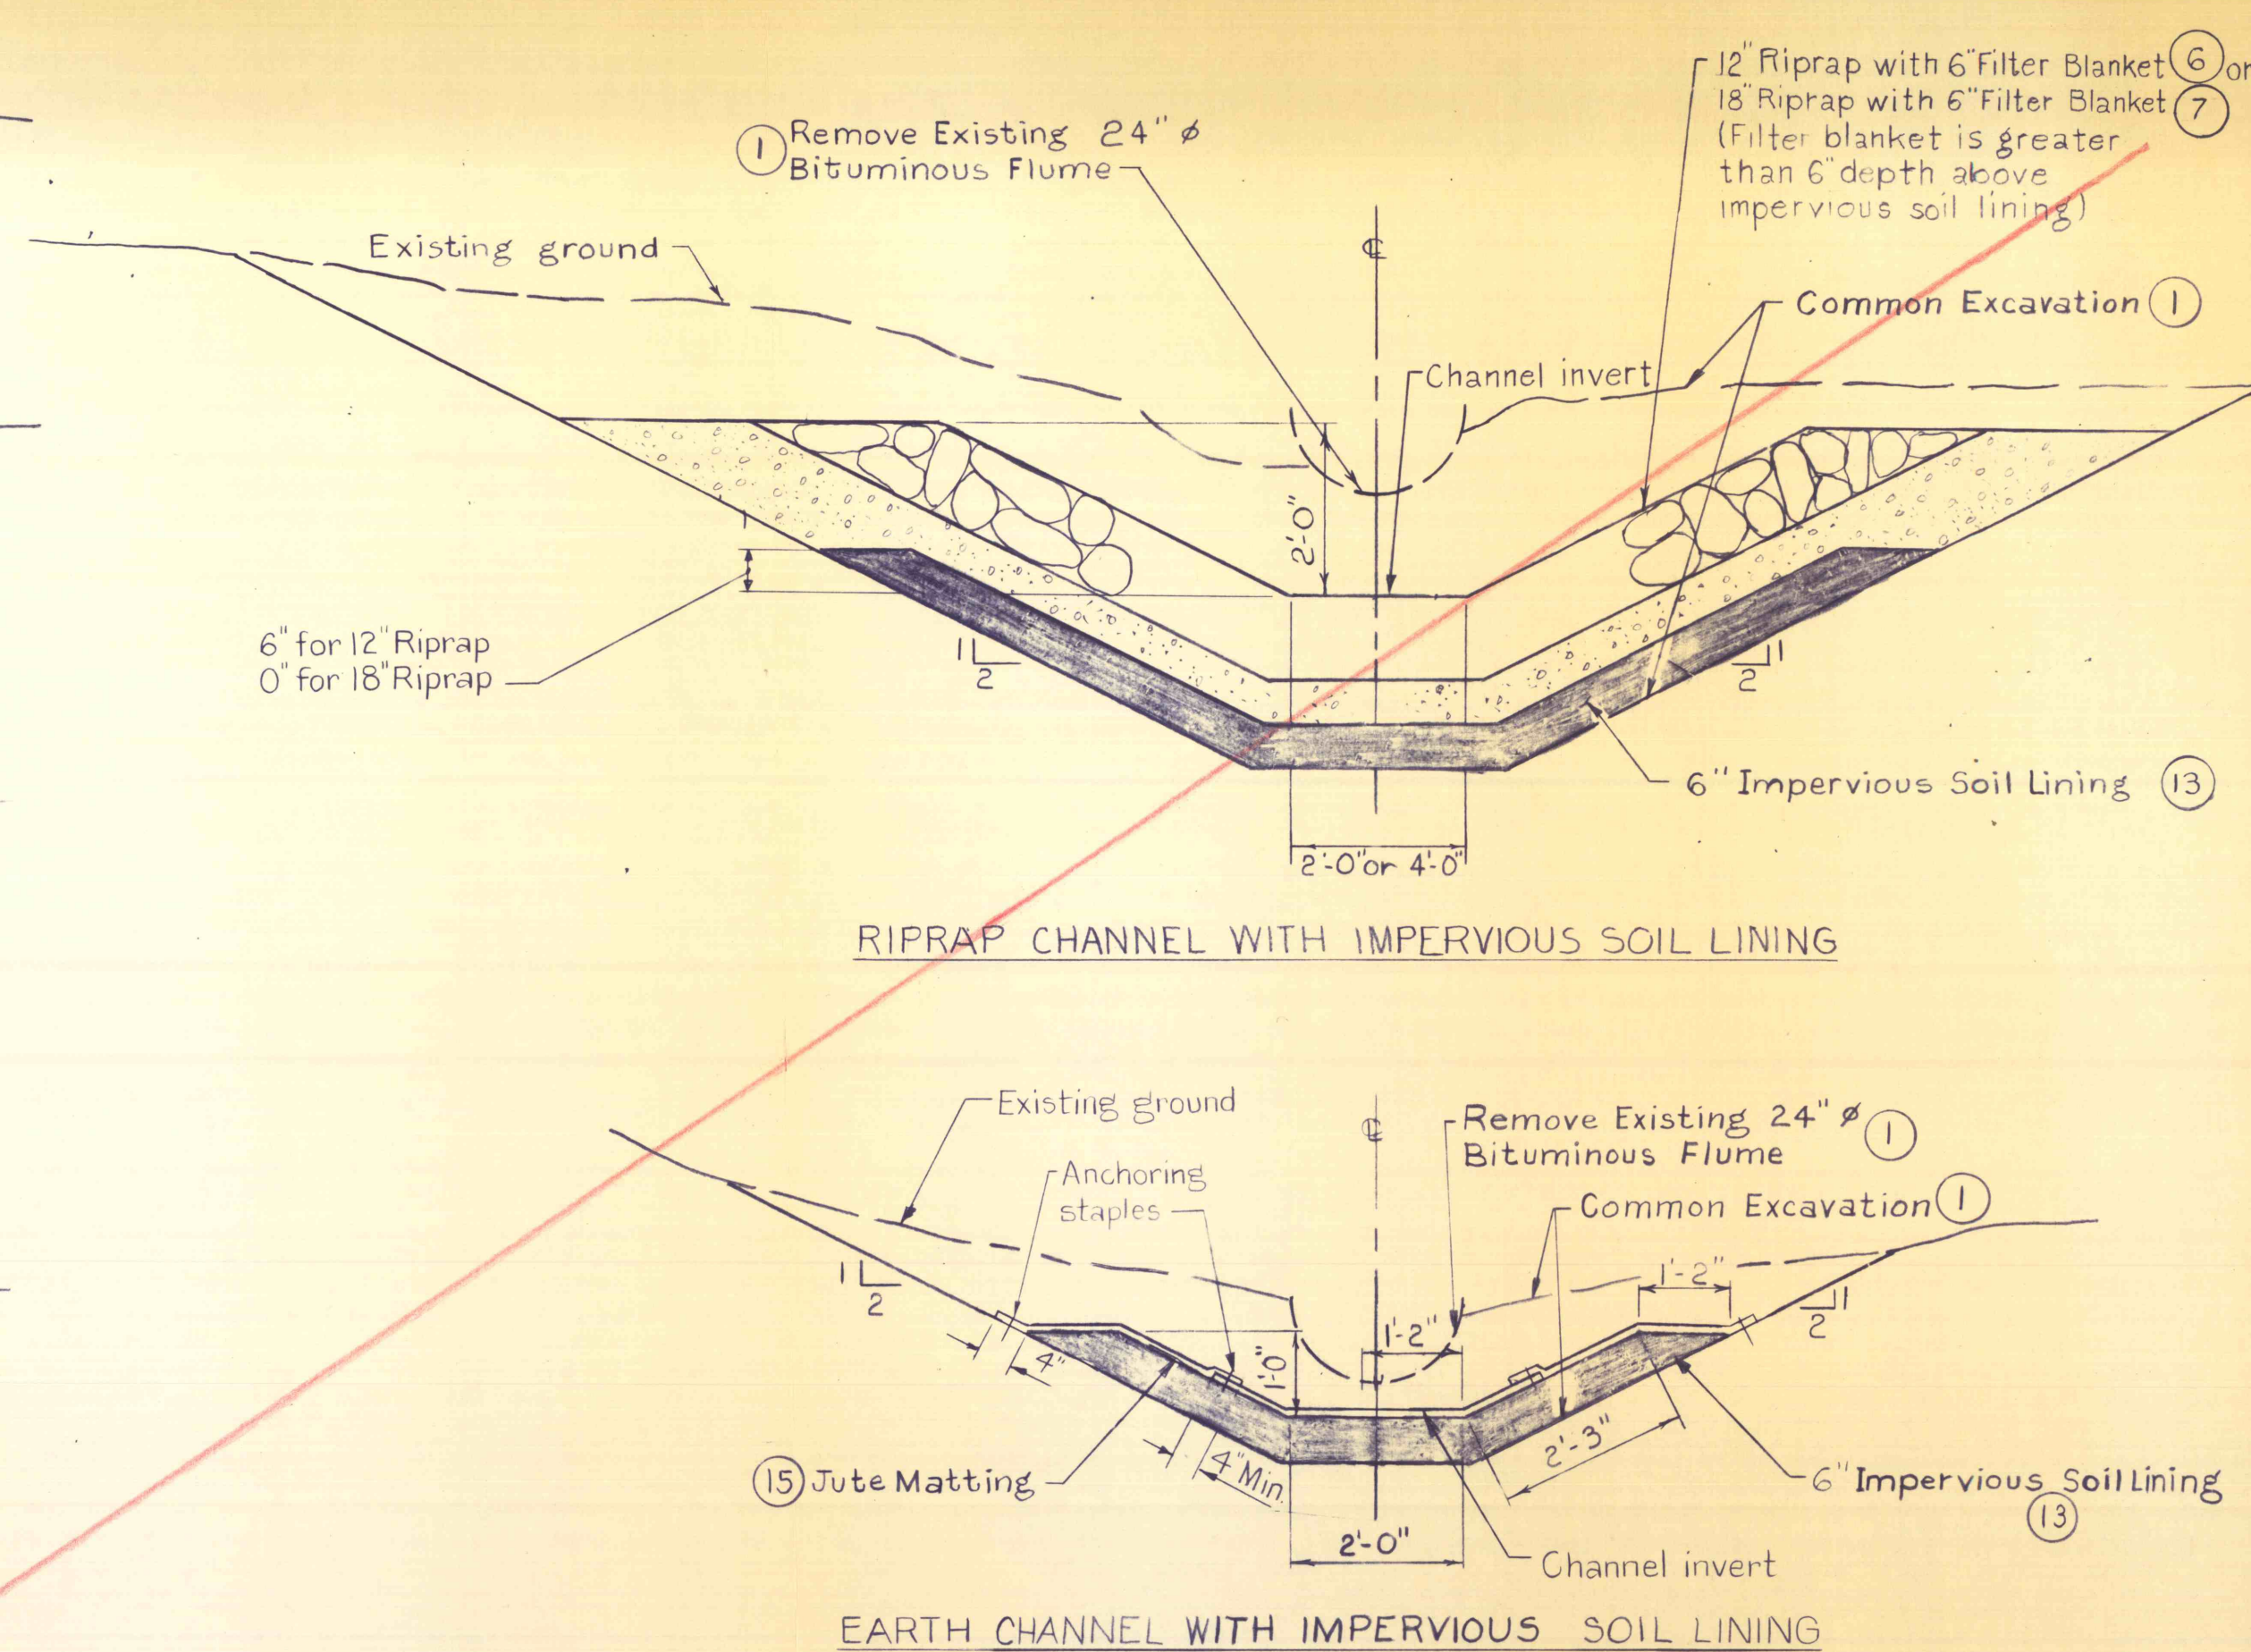

TYPICAL SECTIONS
Scale: 1/2 in. = 1 ft.

NOTES:
1. For General Notes, see Dwg. No. 2

REFERENCES:
1. Plan and Profiles - Dwg. No. 6

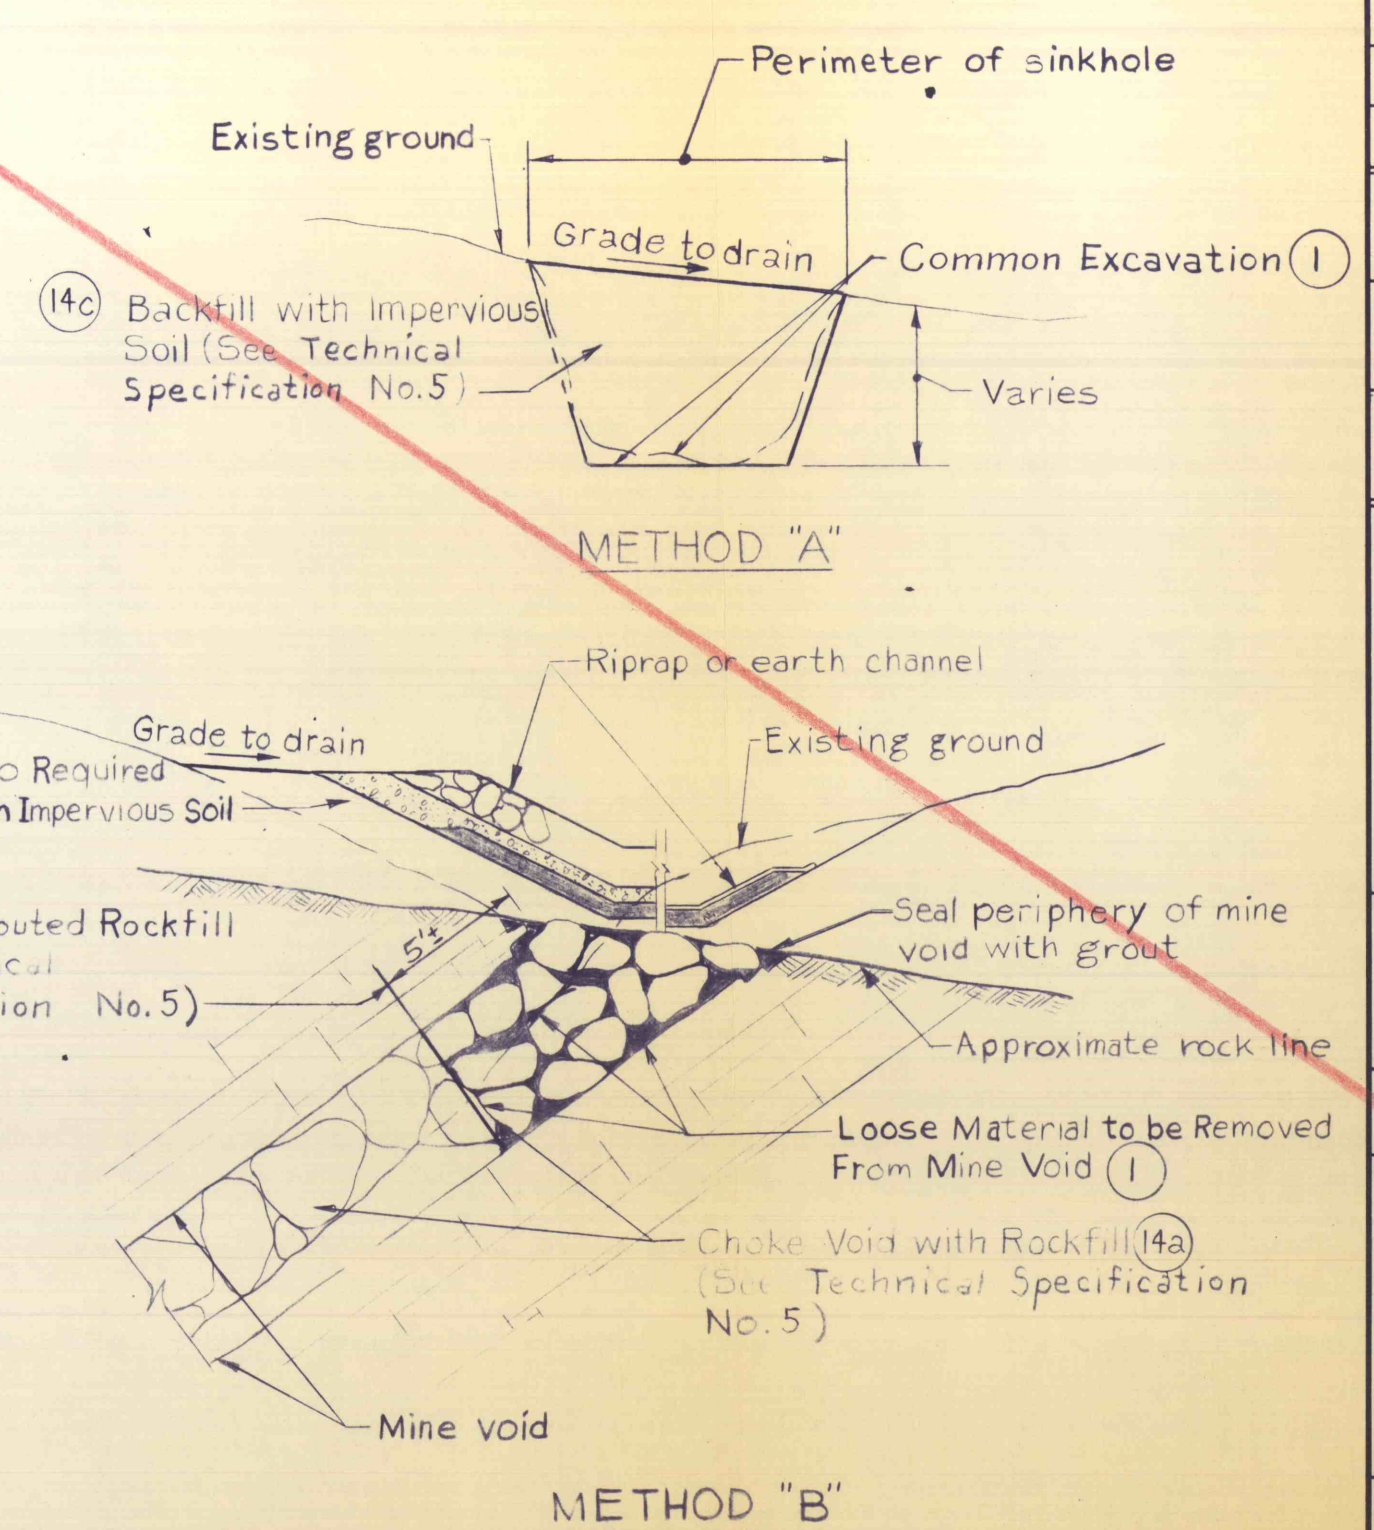

SINKHOLE GRADING DETAILS
No Scale

NO.	DATE	REVISION	APPR.
SUBMITTED <i>By Ras</i> PROJECT CO-ORDINATOR			
APPROVED <i>Albert A. Panini</i> CHIEF-DIVISION OF MINE RECLAMATION			
APPROVED <i>Ad Perry</i> DIRECTOR-BUREAU OF DESIGN			
COMMONWEALTH OF PENNSYLVANIA DEPARTMENT OF ENVIRONMENTAL RESOURCES OFFICE OF RESOURCES MANAGEMENT			
CONTRACT NO. SL 126-2-7/9 F			
MINE DRAINAGE POLLUTION ABATEMENT REMEDIAL WORK SWATARA CREEK WATERSHED			
REILLY TOWNSHIP		SCHUYLKILL CO., PA.	
CHANNELS "O" AND "P" CROSS SECTIONS			