


**LOCATION MAP**  
Scale: 1 in. = 9 mi.

▲ Work deleted on channels "O" and "P" per Addendum No. 2.

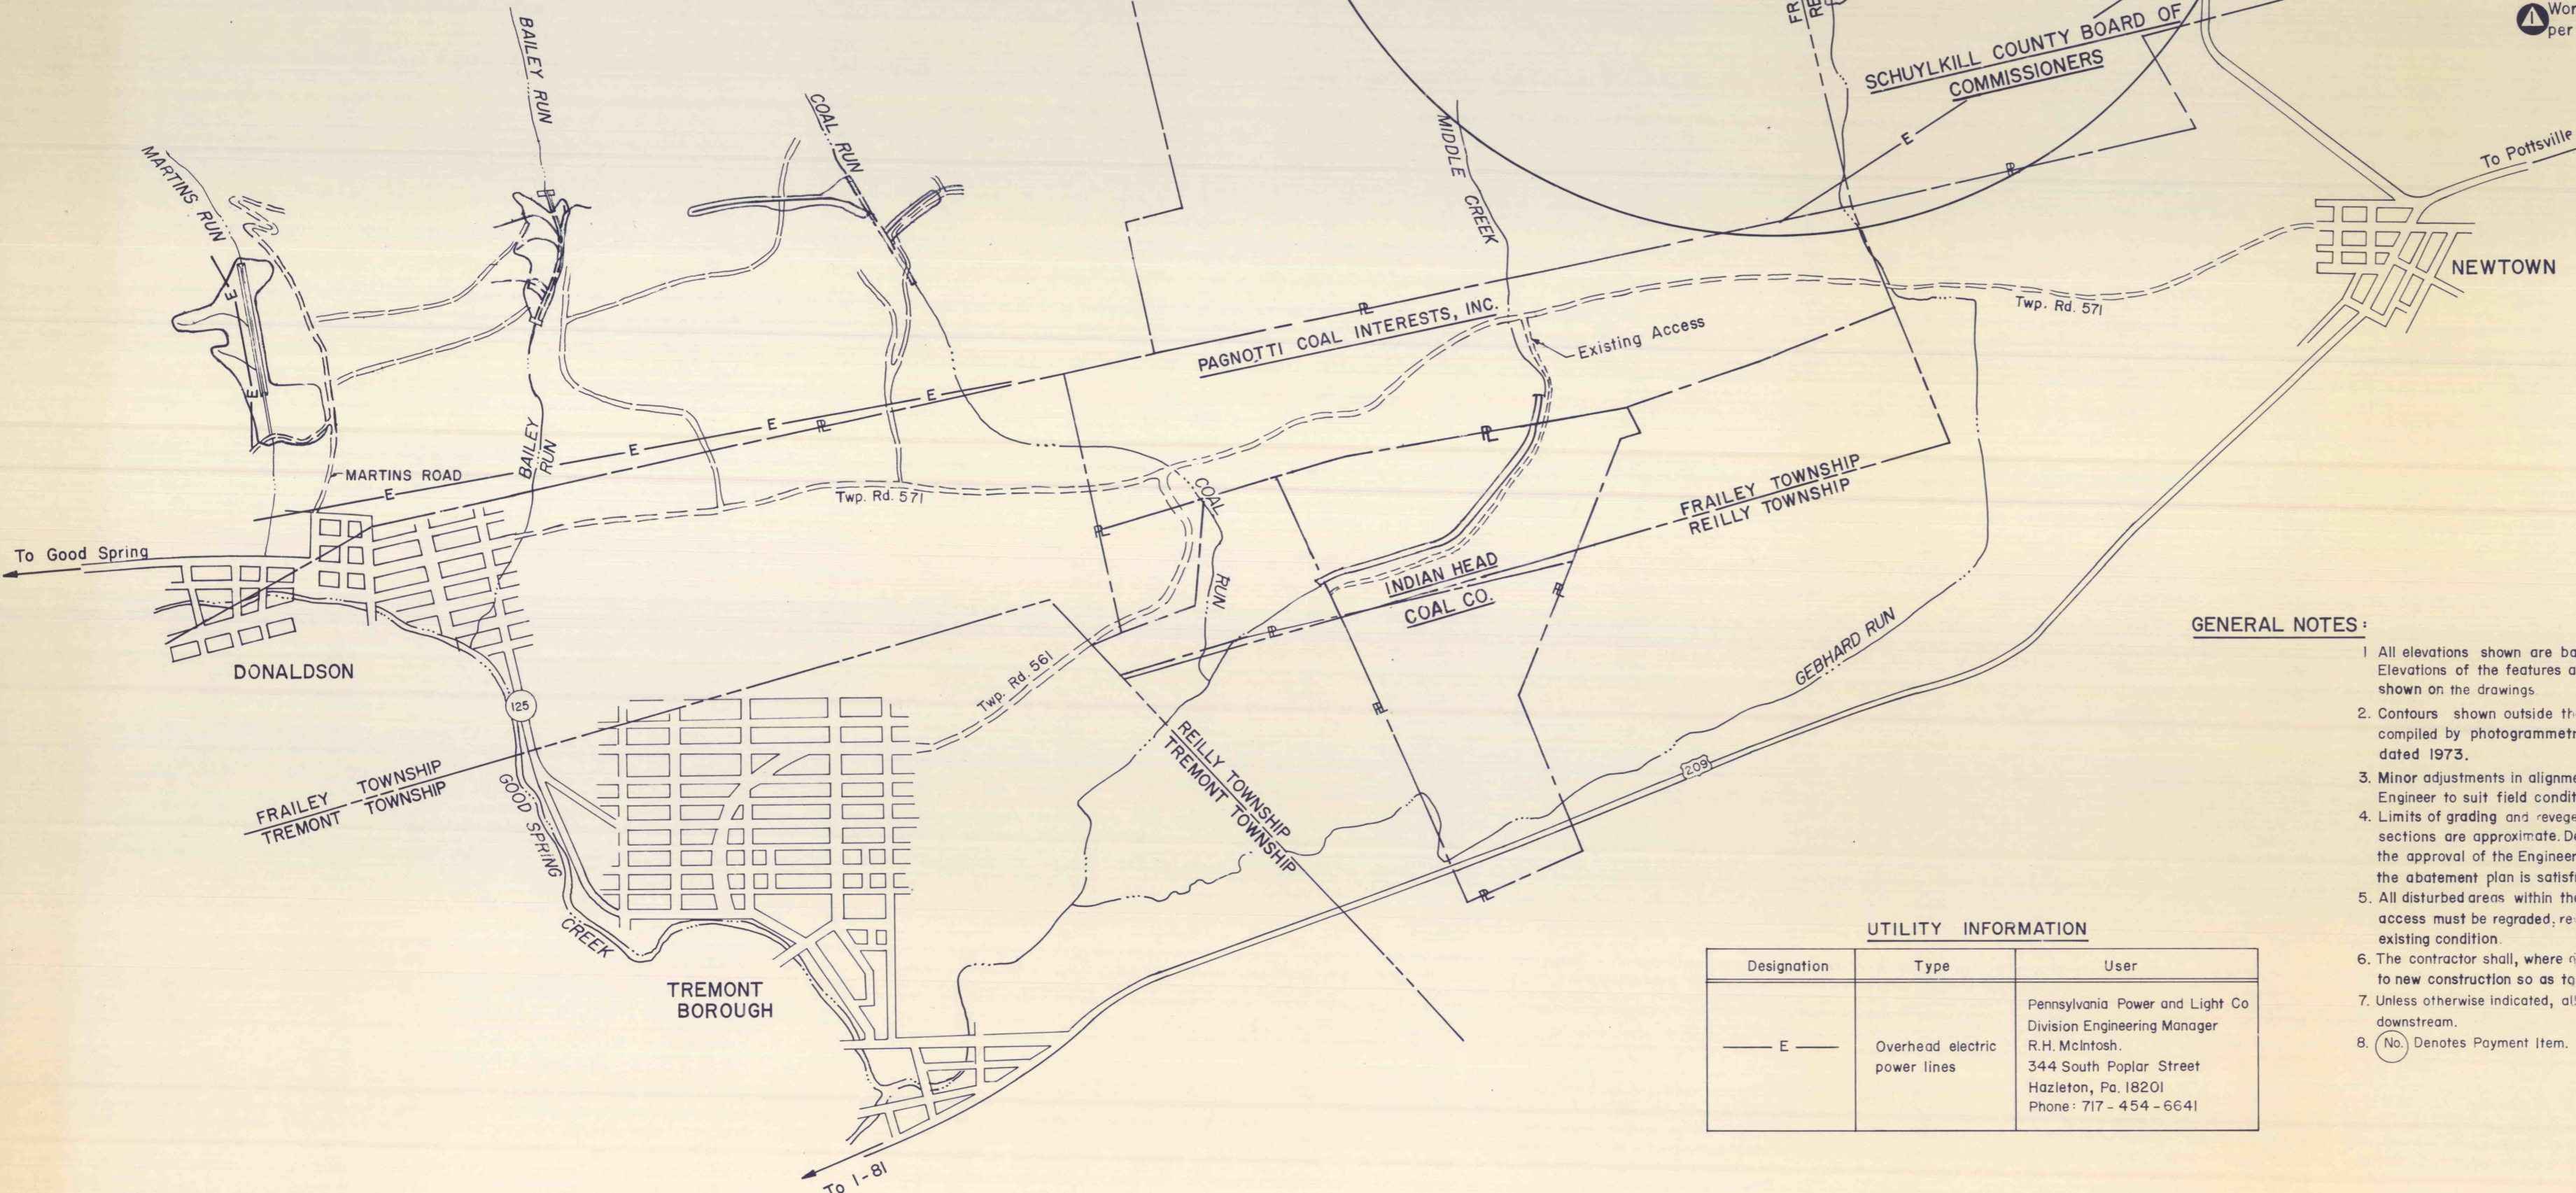

**VICINITY MAP**  
Scale: 1 in. = 800 ft.

**GENERAL NOTES:**

1. All elevations shown are based on current U.S.G.S Datum. Elevations of the features are to be taken from the Bench Marks shown on the drawings.
2. Contours shown outside the existing grading limits have been compiled by photogrammetric methods from aerial photographs dated 1973.
3. Minor adjustments in alignment and grade may be made by the Engineer to suit field conditions.
4. Limits of grading and revegetation as shown on the plans and cross sections are approximate. Deviations may be permitted subject to the approval of the Engineer and provided that the full intent of the abatement plan is satisfied.
5. All disturbed areas within the Contractors Working Area and access must be graded, revegetated and restored to at least the existing condition.
6. The contractor shall, where directed, fill and grade areas adjacent to new construction so as to provide positive surface runoff.
7. Unless otherwise indicated, all cross sections are shown looking downstream.
8. (No.) Denotes Payment Item.

**UTILITY INFORMATION**


Designation	Type	User
— E —	Overhead electric power lines	Pennsylvania Power and Light Co Division Engineering Manager R.H. McIntosh 344 South Poplar Street Hazleton, Pa. 18201 Phone: 717 - 454 - 6641

NO.	DATE	REVISION	APPR.
▲ 62078		Work deleted per Addendum No. 2	

SUBMITTED: *B.Rao*  
PROJECT CO-ORDINATOR

APPROVED: *Robert A. Pinner*  
CHIEF - DIVISION OF MINE RECLAMATION

APPROVED: *W. J. ...*  
DIRECTOR - BUREAU OF DESIGN

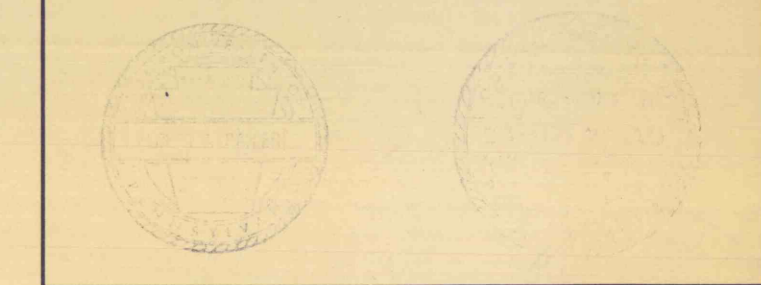

COMMONWEALTH OF PENNSYLVANIA  
DEPARTMENT OF ENVIRONMENTAL RESOURCES  
OFFICE OF RESOURCES MANAGEMENT

CONTRACT NO. SL 126 - 2 - 7/9 F  
MINE DRAINAGE POLLUTION ABATEMENT  
REMEDIAL WORK  
SWATARA CREEK WATERSHED  
FRAYLEY AND REILLY TOWNSHIPS SCHUYLKILL CO., PA.

**LOCATION AND VICINITY MAPS**

DRAWN BY: <i>B.Rao</i>	DATE: 25 May 78	DRAWING NO. 2 of 7
CHECKED BY: <i>B.Rao</i>	SCALE: AS SHOWN	