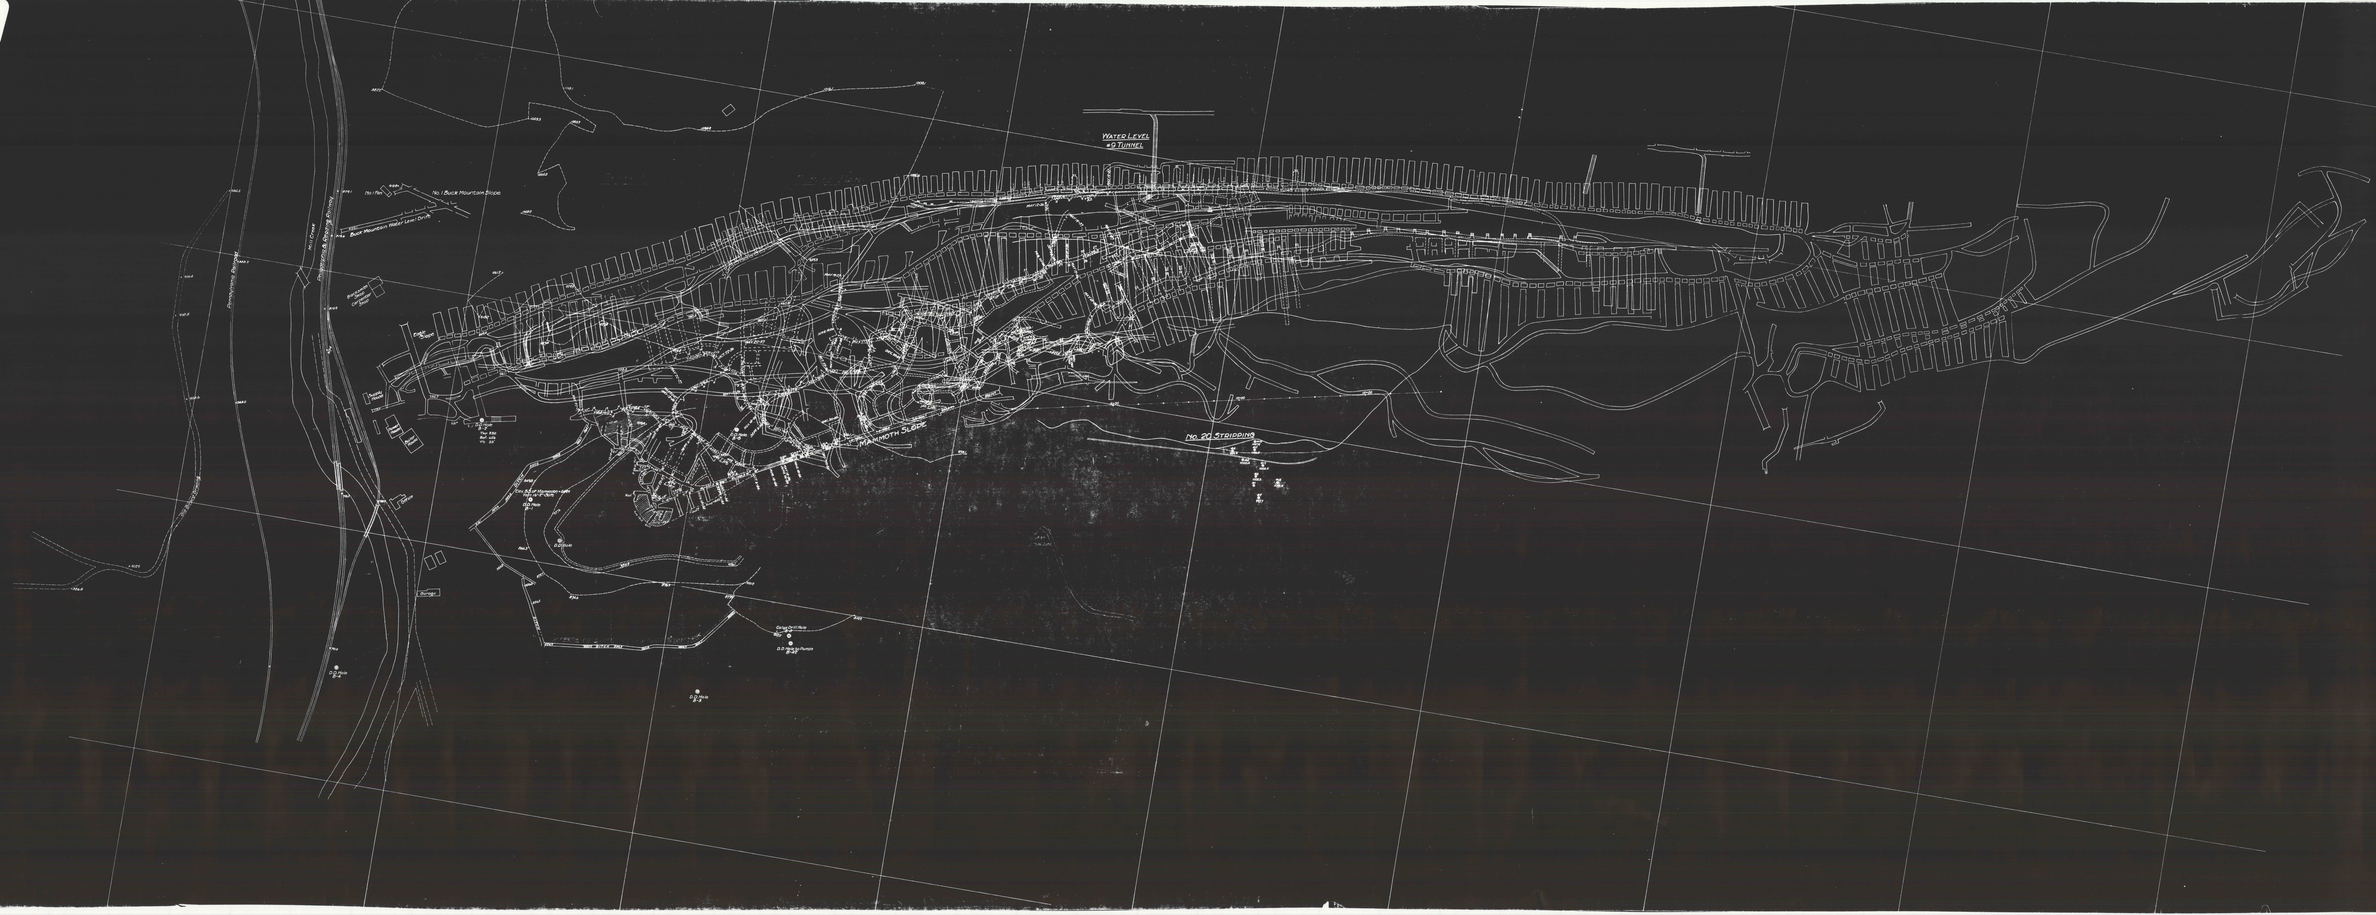
WATER LEVEL
#6 TUNNEL
No. 1 Buck Mountain Slope
Buck Mountain Water Level Drift
MAMMOTH SLOPE
No. 20 STRIDDING