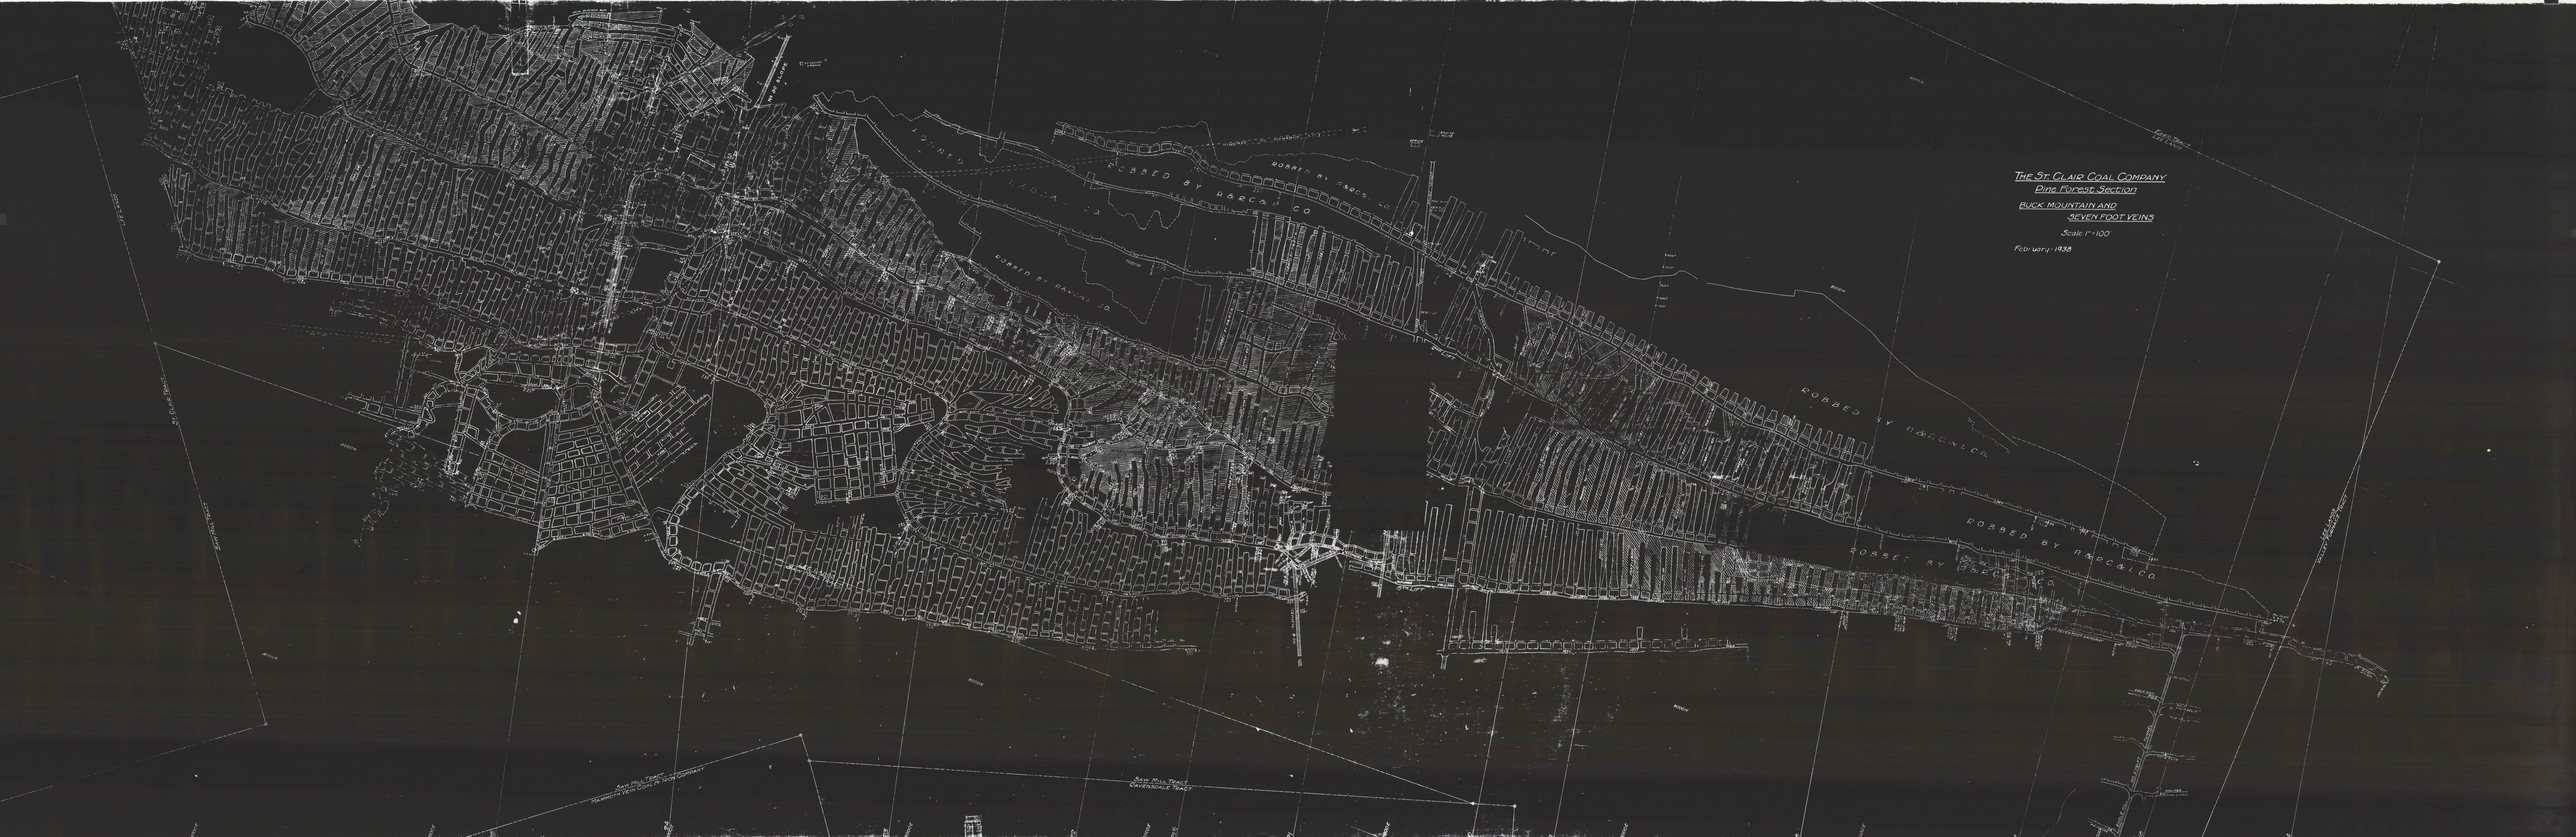
ROBBED BY R&C&A CO
ROBBED BY R&C&A CO
ROBBED BY R&C&A CO
ROBBED BY R&C&A CO
ROBBED BY R&C&A CO
ROBBED BY R&C&A CO
THE ST. CLAIR COAL COMPANY
Pine Forest Section
BUCK MOUNTAIN AND
SEVEN FOOT VEINS
Scale 1" = 100
February 1938