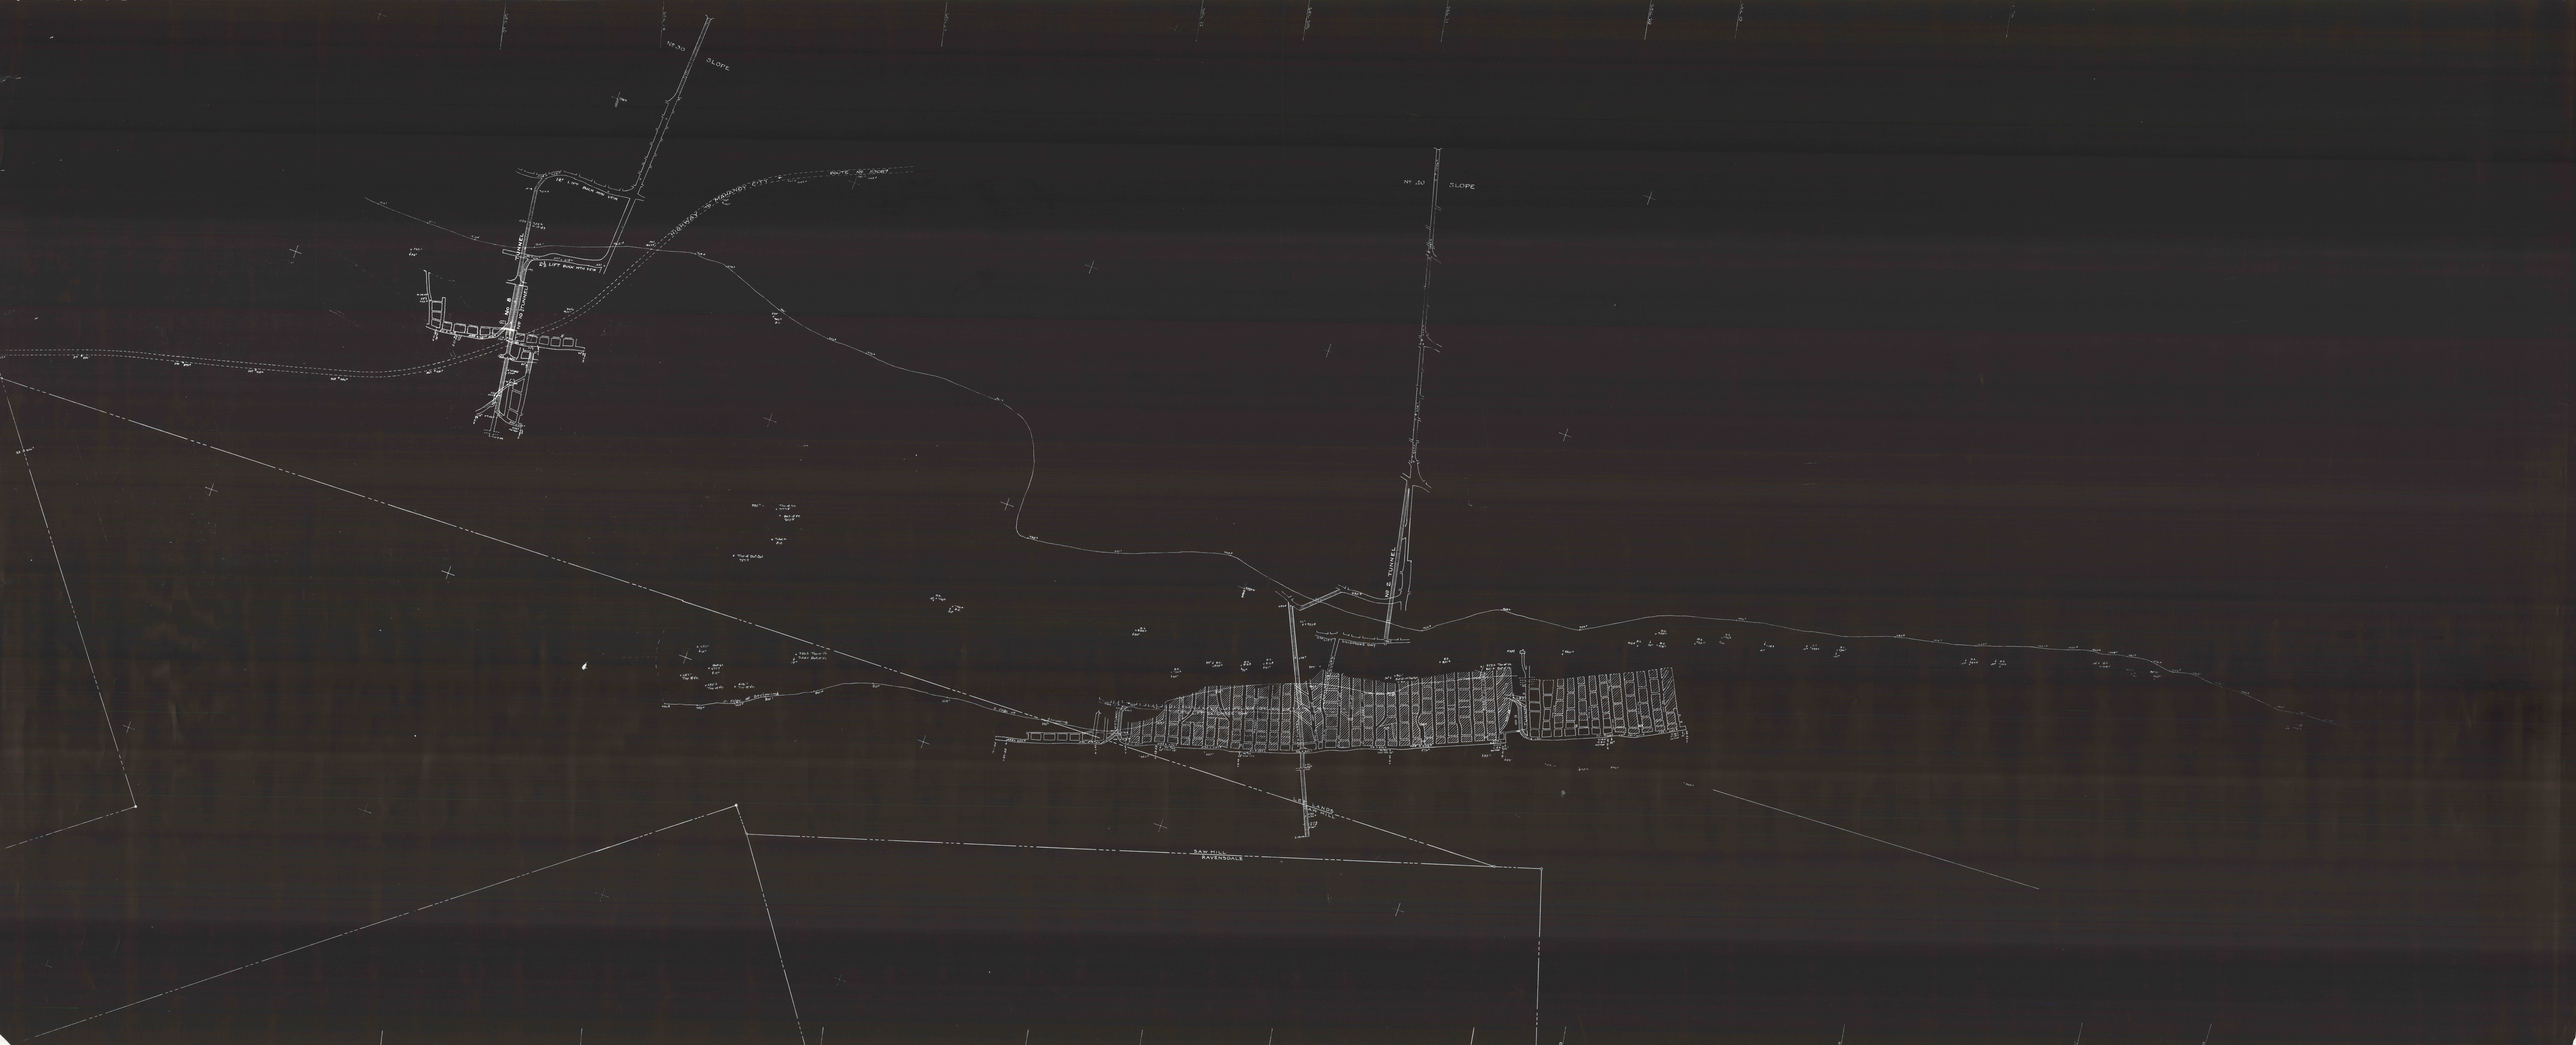
No. 30 SLOPE
No. 2 TUNNEL
No. 30 SLOPE
SAW MILL
RAVENDALE