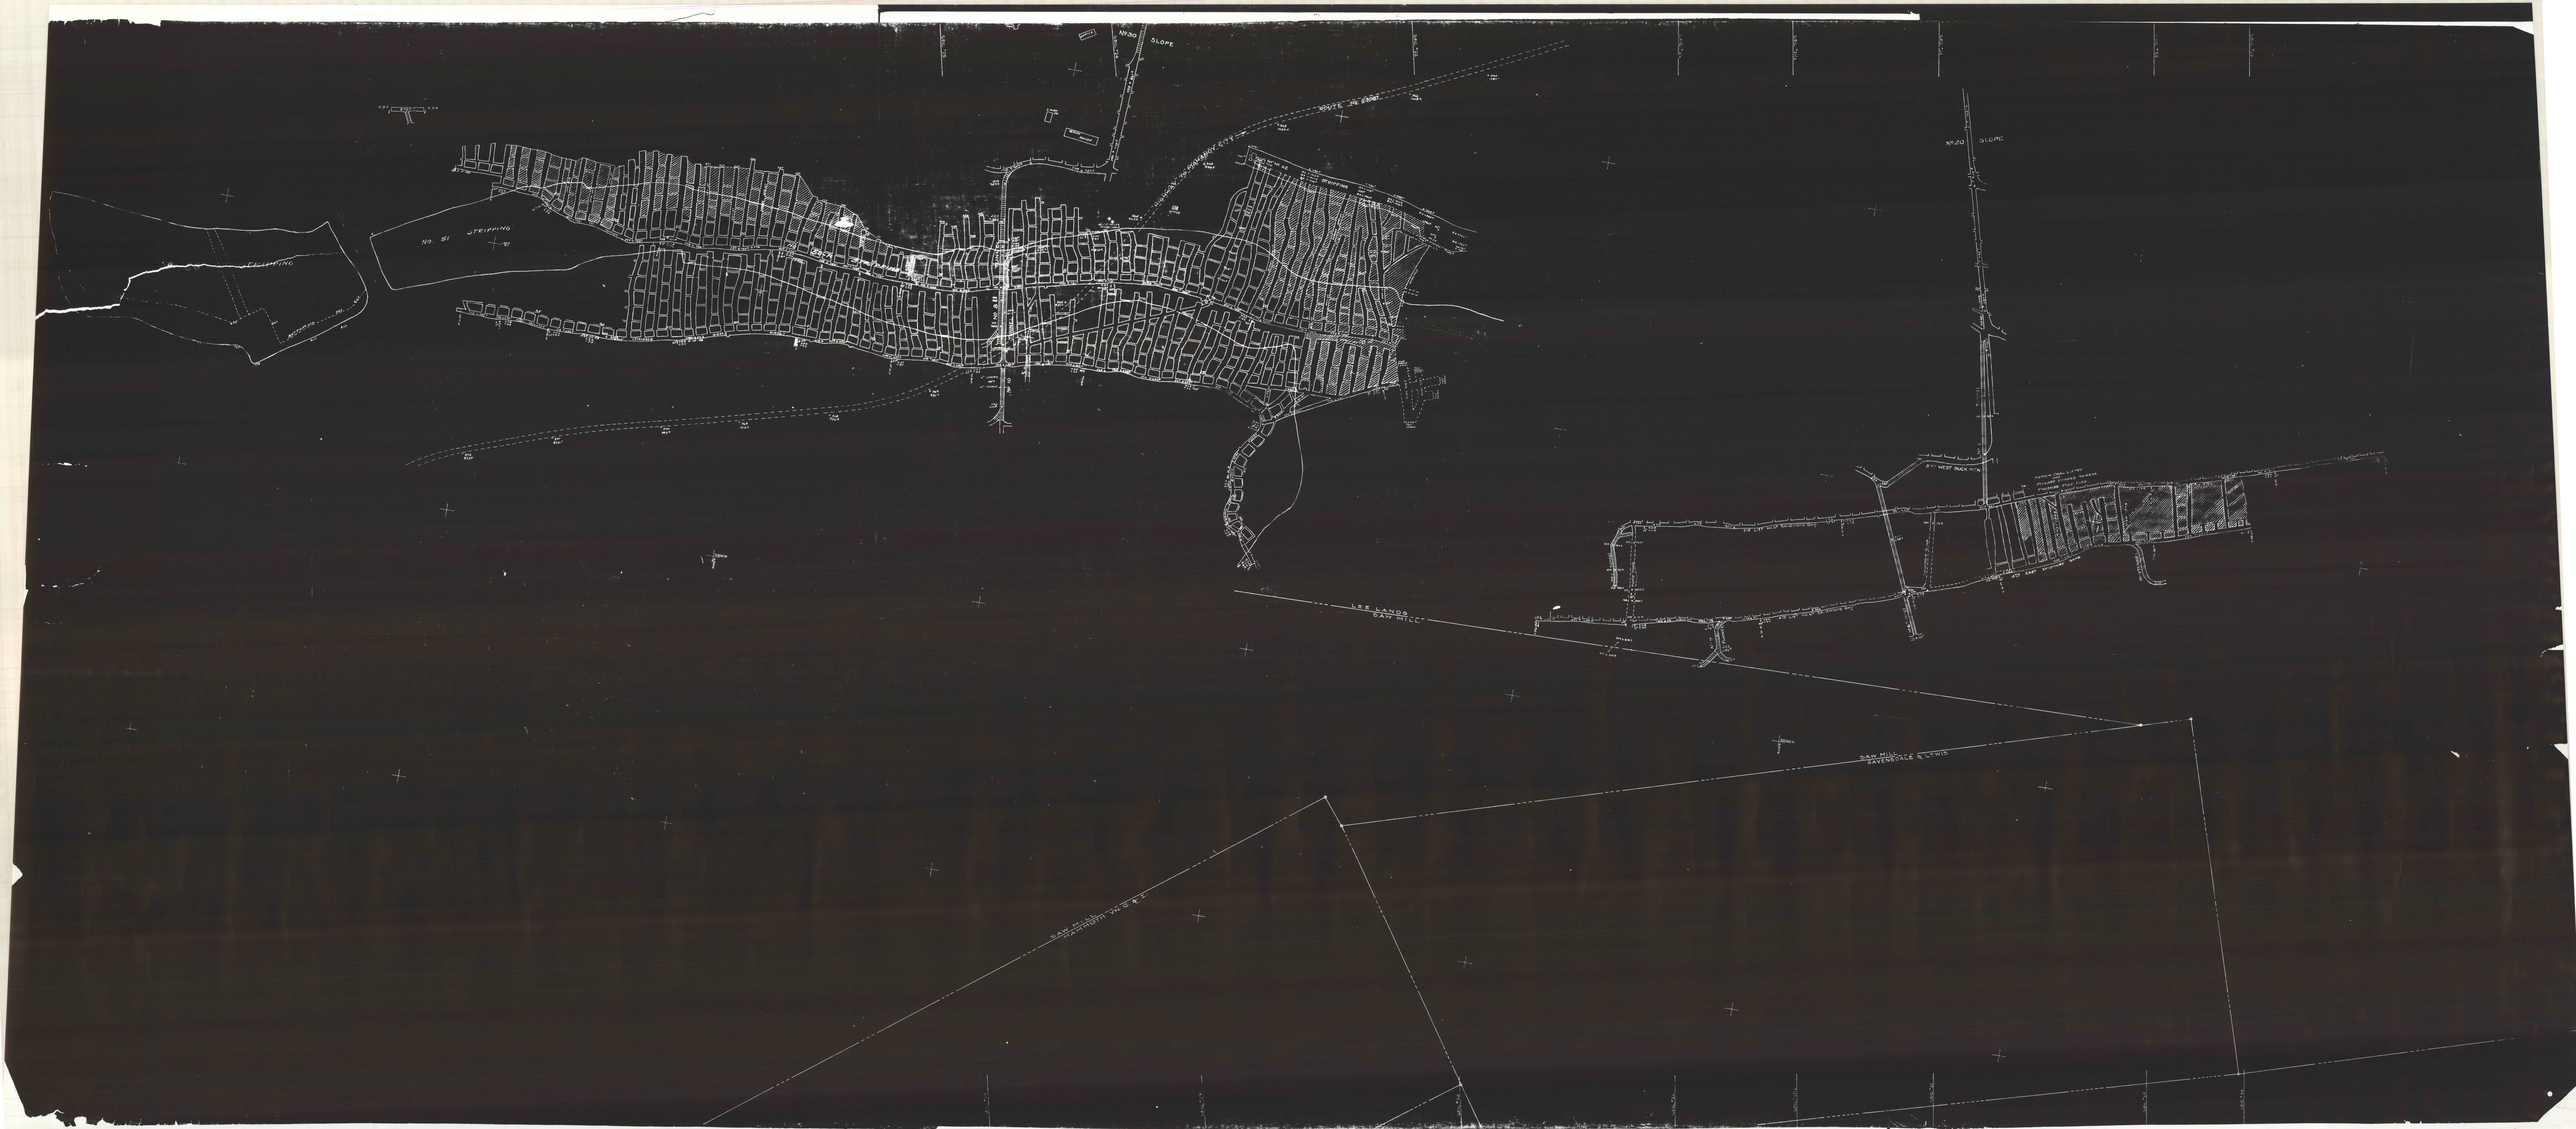
No. 30 SLOPE
No. 20 SLOPE
No. 51 STRIPPING
SAW MILL
SAW MILL
SAW MILL
SAW MILL