



PARTIAL PLAN FROM DWG C-20

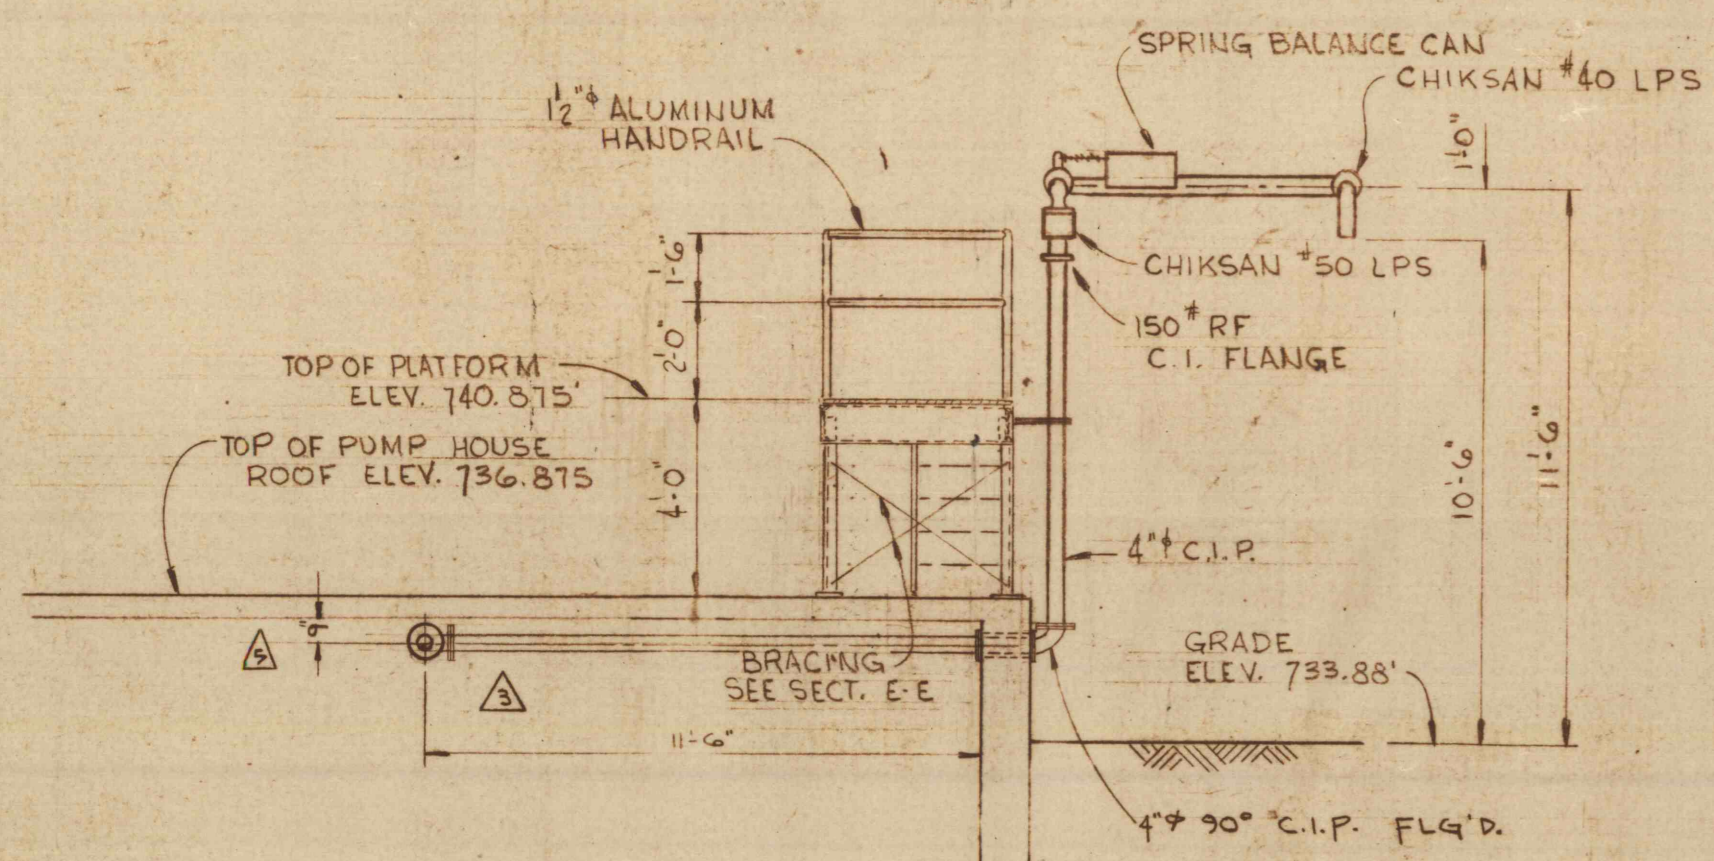


SECTION G-G

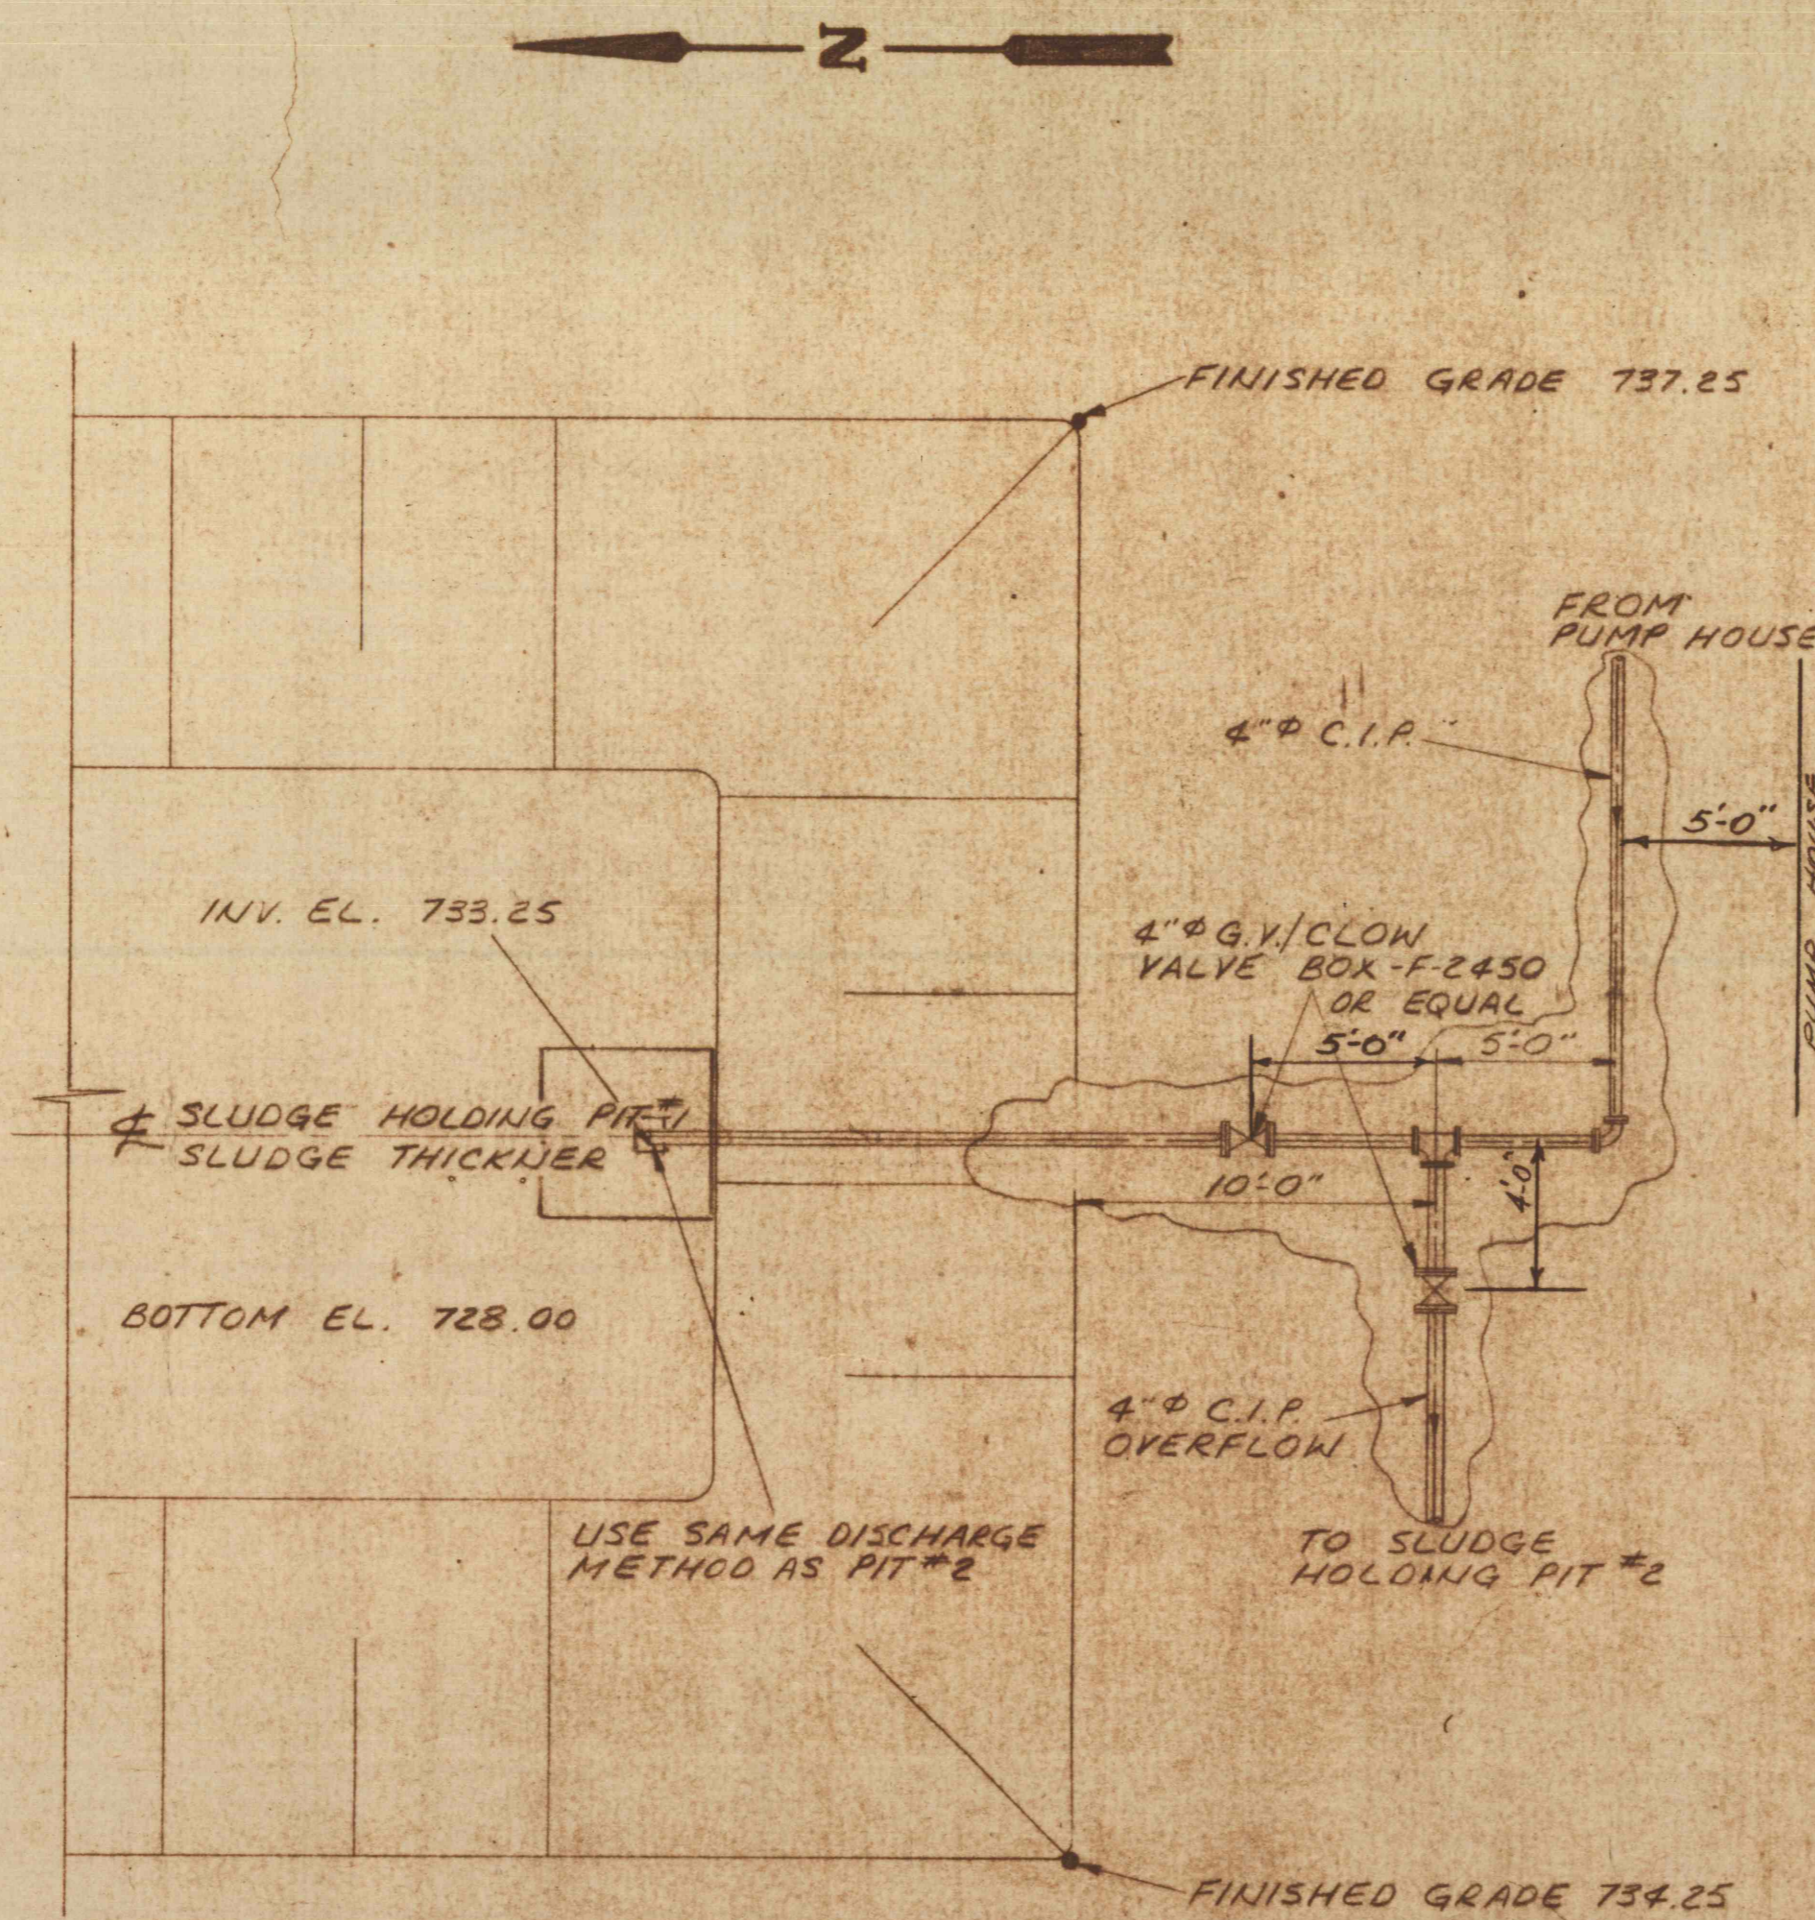


PARTIAL PLAN FROM DWG C-5
SCALE 3/4" = 1'-0"


SPECIAL NOTES:
ALL CHANGES OF DIRECTION (BENDS, FITTINGS, ETC) OF PRESSURE PIPE LINES SHALL BE PROPERLY ANCHORED BY CONCRETE THRUST BLOCKS OR APPROVED TIE RODS.

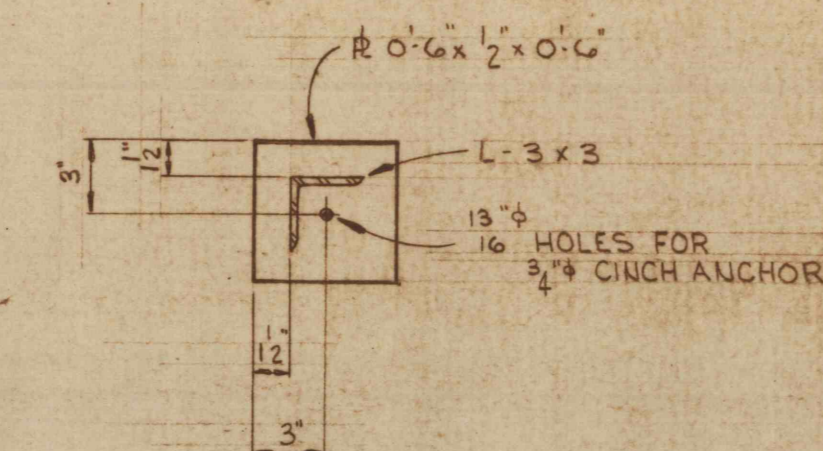


SECTIONAL PLAN F-F

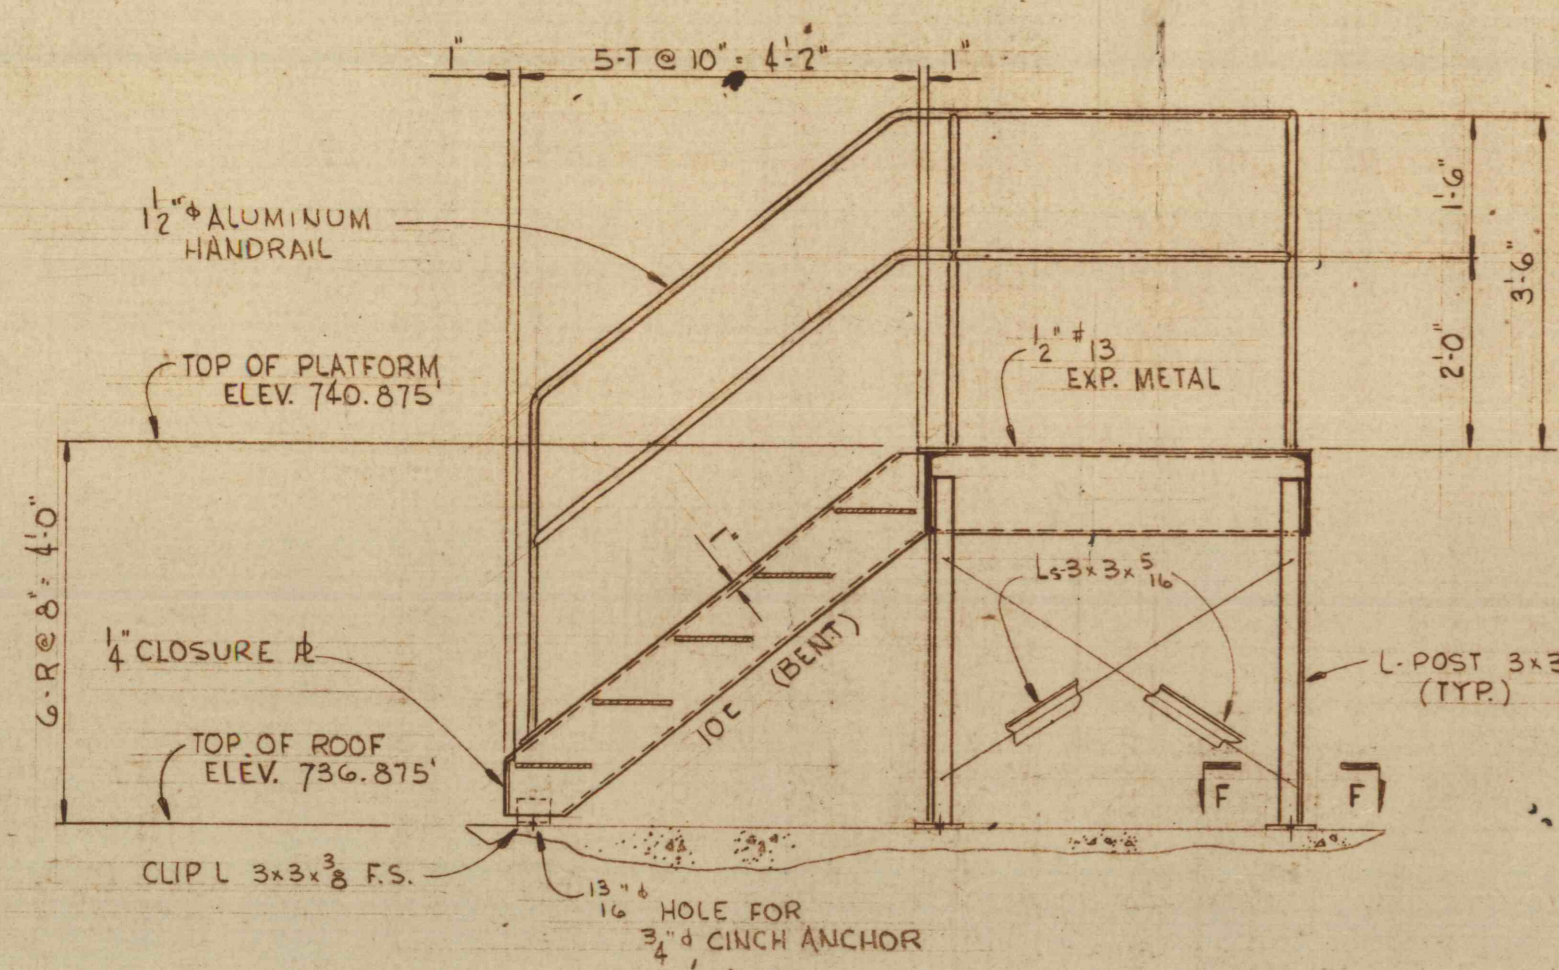


SECTION E-E

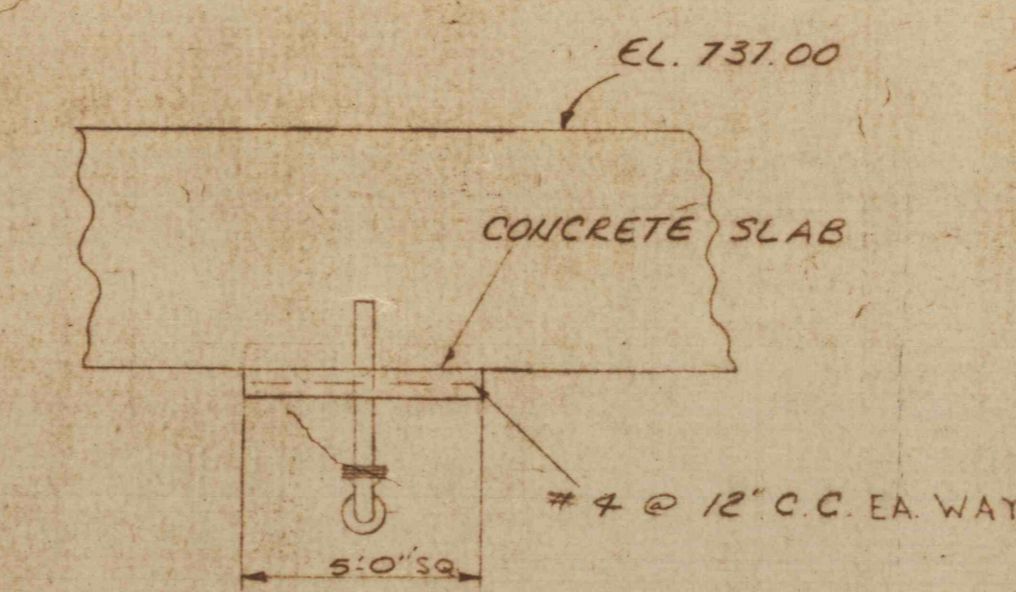

SECTION D-D
SCALE 1/2" = 1'-0"

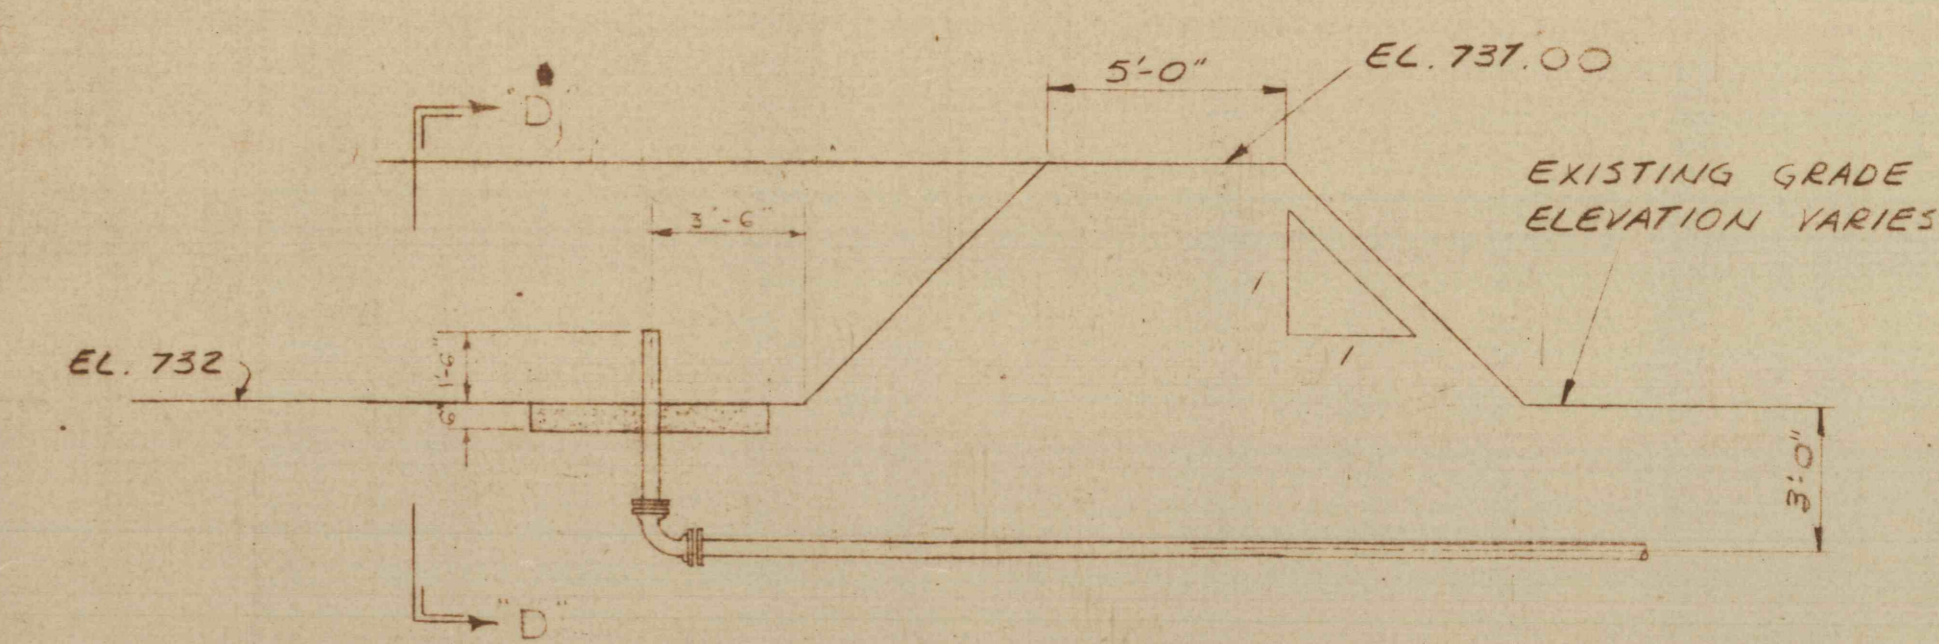

SECTION C-C
SCALE 1/2" = 1'-0"

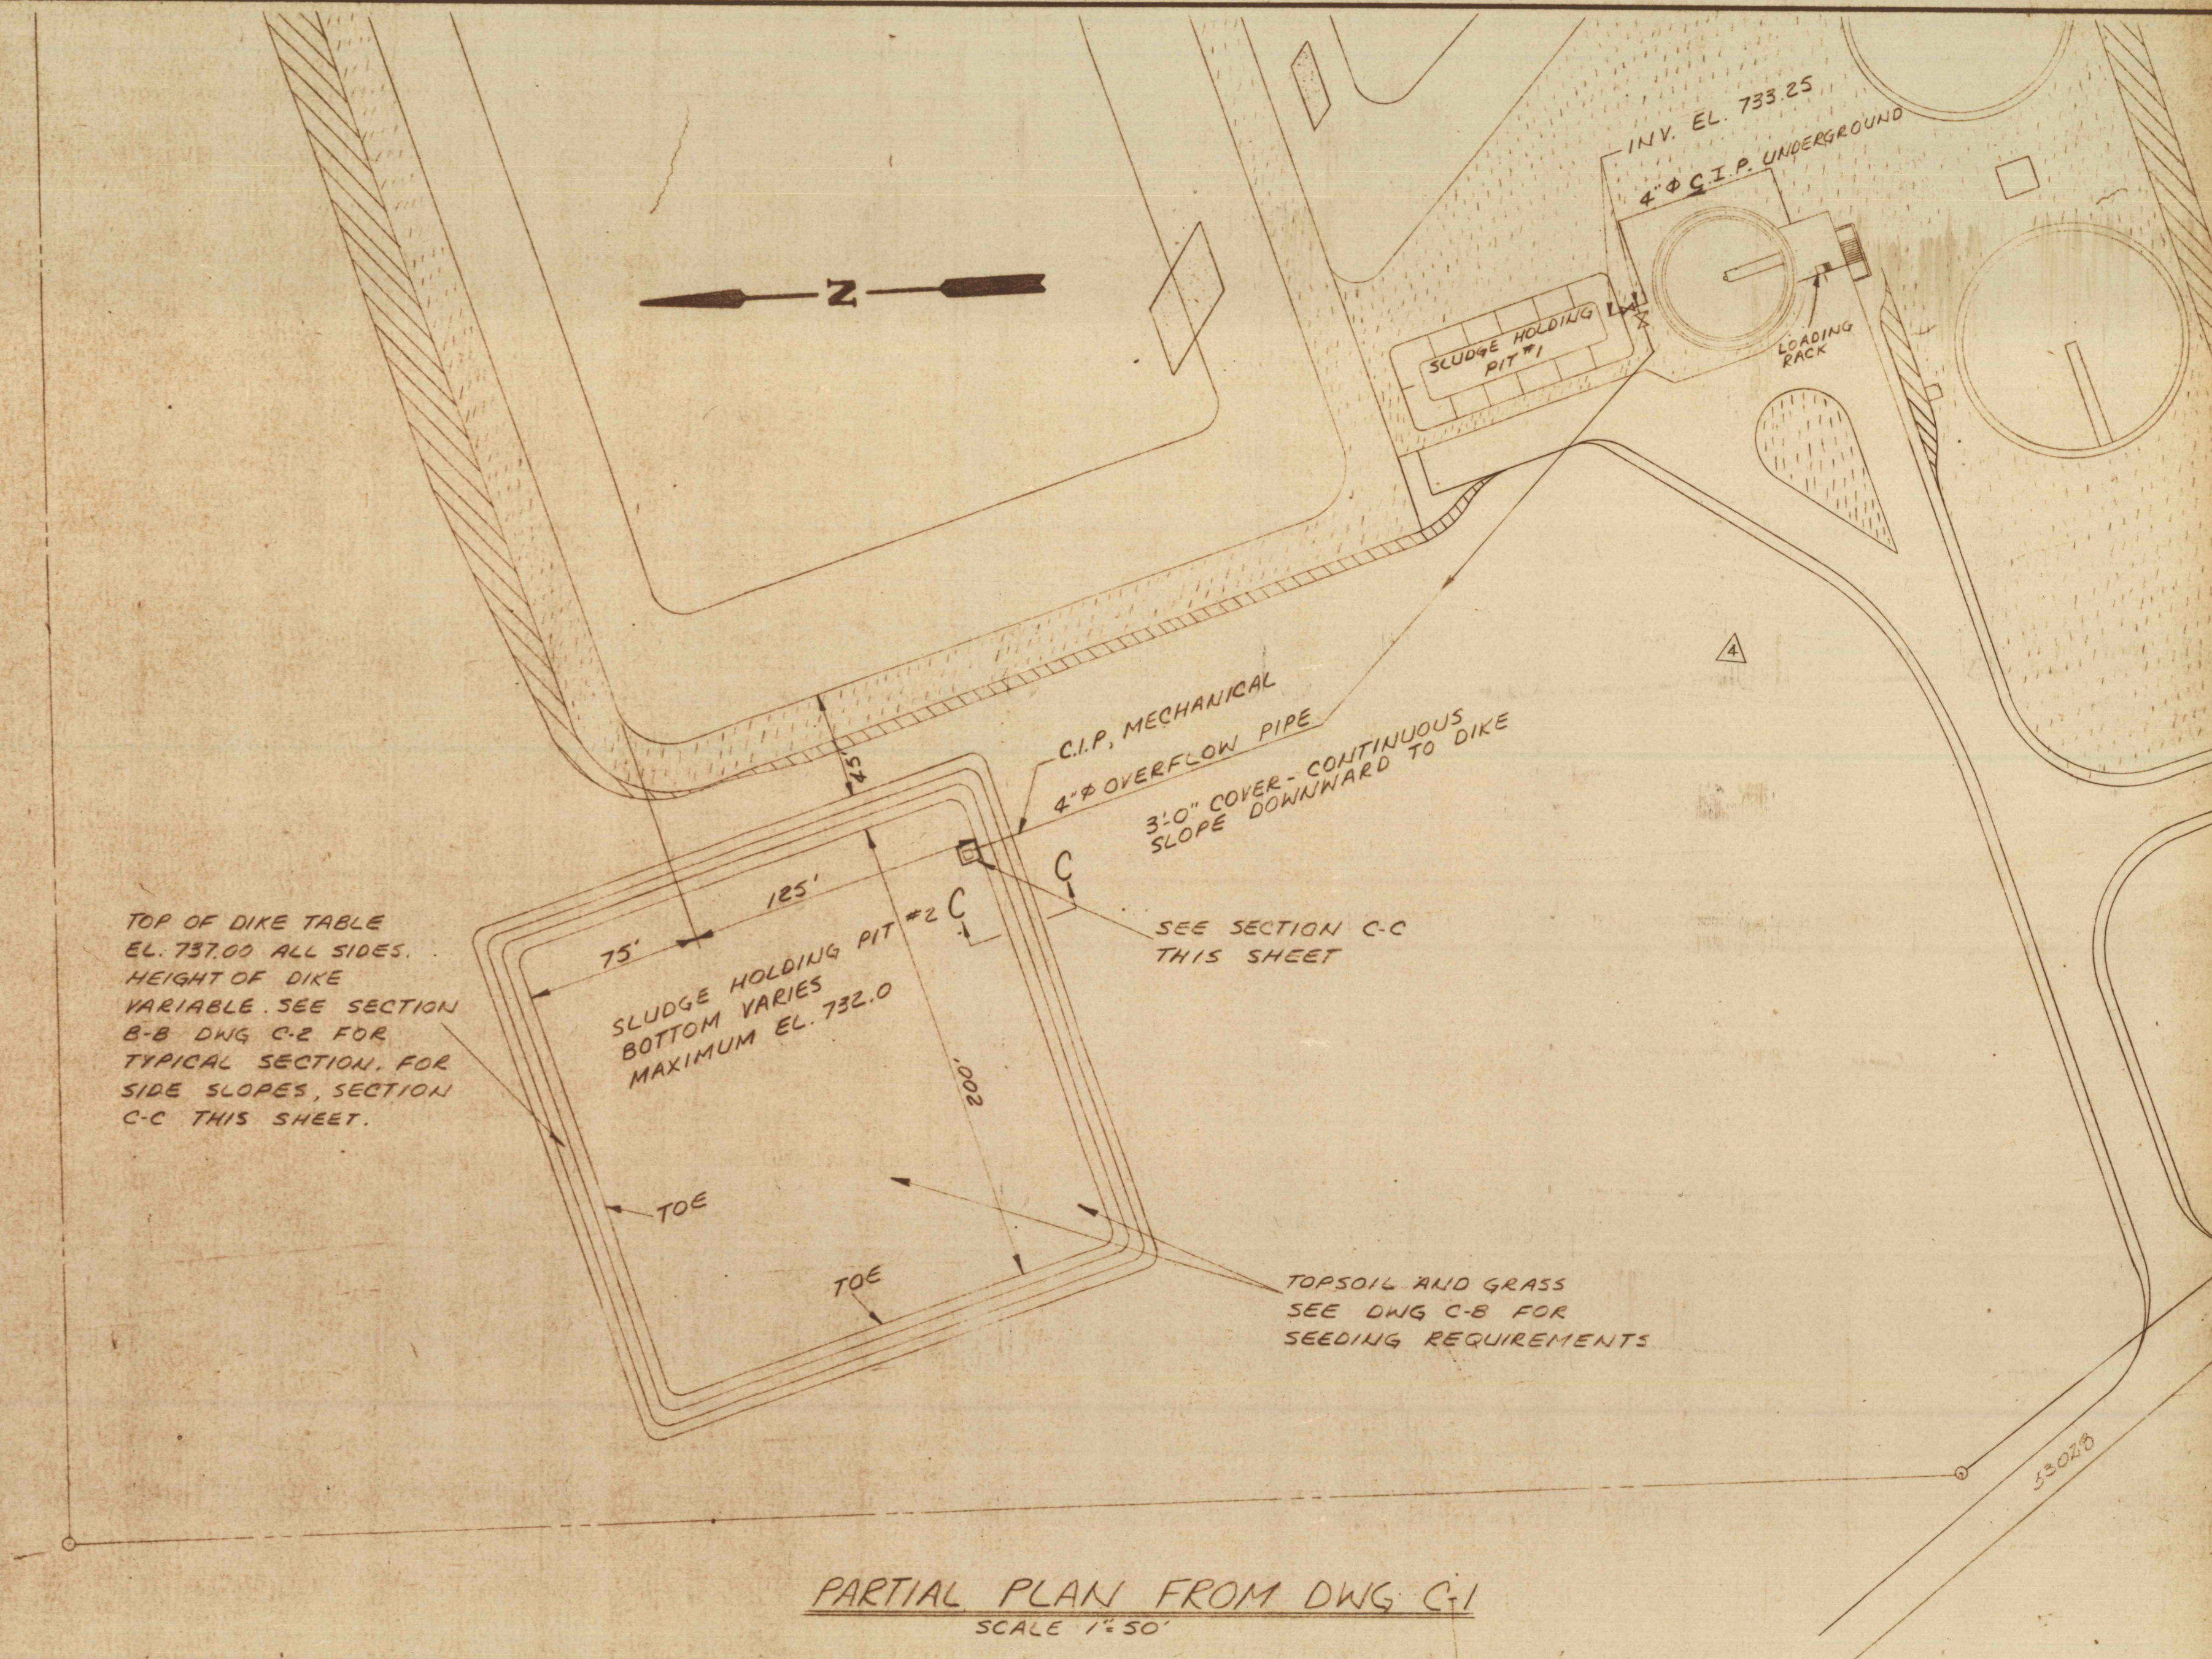

PARTIAL PLAN FROM DWG C-1
SCALE 1/4" = 50'

NO.	DATE	DESCRIPTION	BY
5	4-27-71	CHANGED PIPE DIMENSION FROM 6" TO 9"	(F.D.S.)
4	3-22-71	CHANGED ENTRANCE ROAD	(F.D.S.)
3	3-19-71	CHANGED PIPE LOCATION	(F.D.S.)
2	11-29-70	REV. LOCATION OF PLATFORM	
1	6-18-70	REVISED SLUDGE DISCHARGE LEG	

SLUDGE HANDLING DETAILS

CONSTRUCTION OF TREATMENT FACILITIES FOR ACID MINE DRAINAGE
RAUSCH CREEK WATERSHED
SCHUYLKILL COUNTY, PENNSYLVANIA

ANTHRACITE RESEARCH & DEVELOPMENT CO. INC.
CONSULTING ENGINEERS
POTTSVILLE, PENNSYLVANIA TAMAQUA

JOB NO: 6805
DATE: 2-23-70
SCALE: AS NOTED
DRAWN: AS NOTED
APPROVED: [Signature]

DRAWING NO. **C-29**