


"LOOKING WEST."

CAIN'S COLLY.

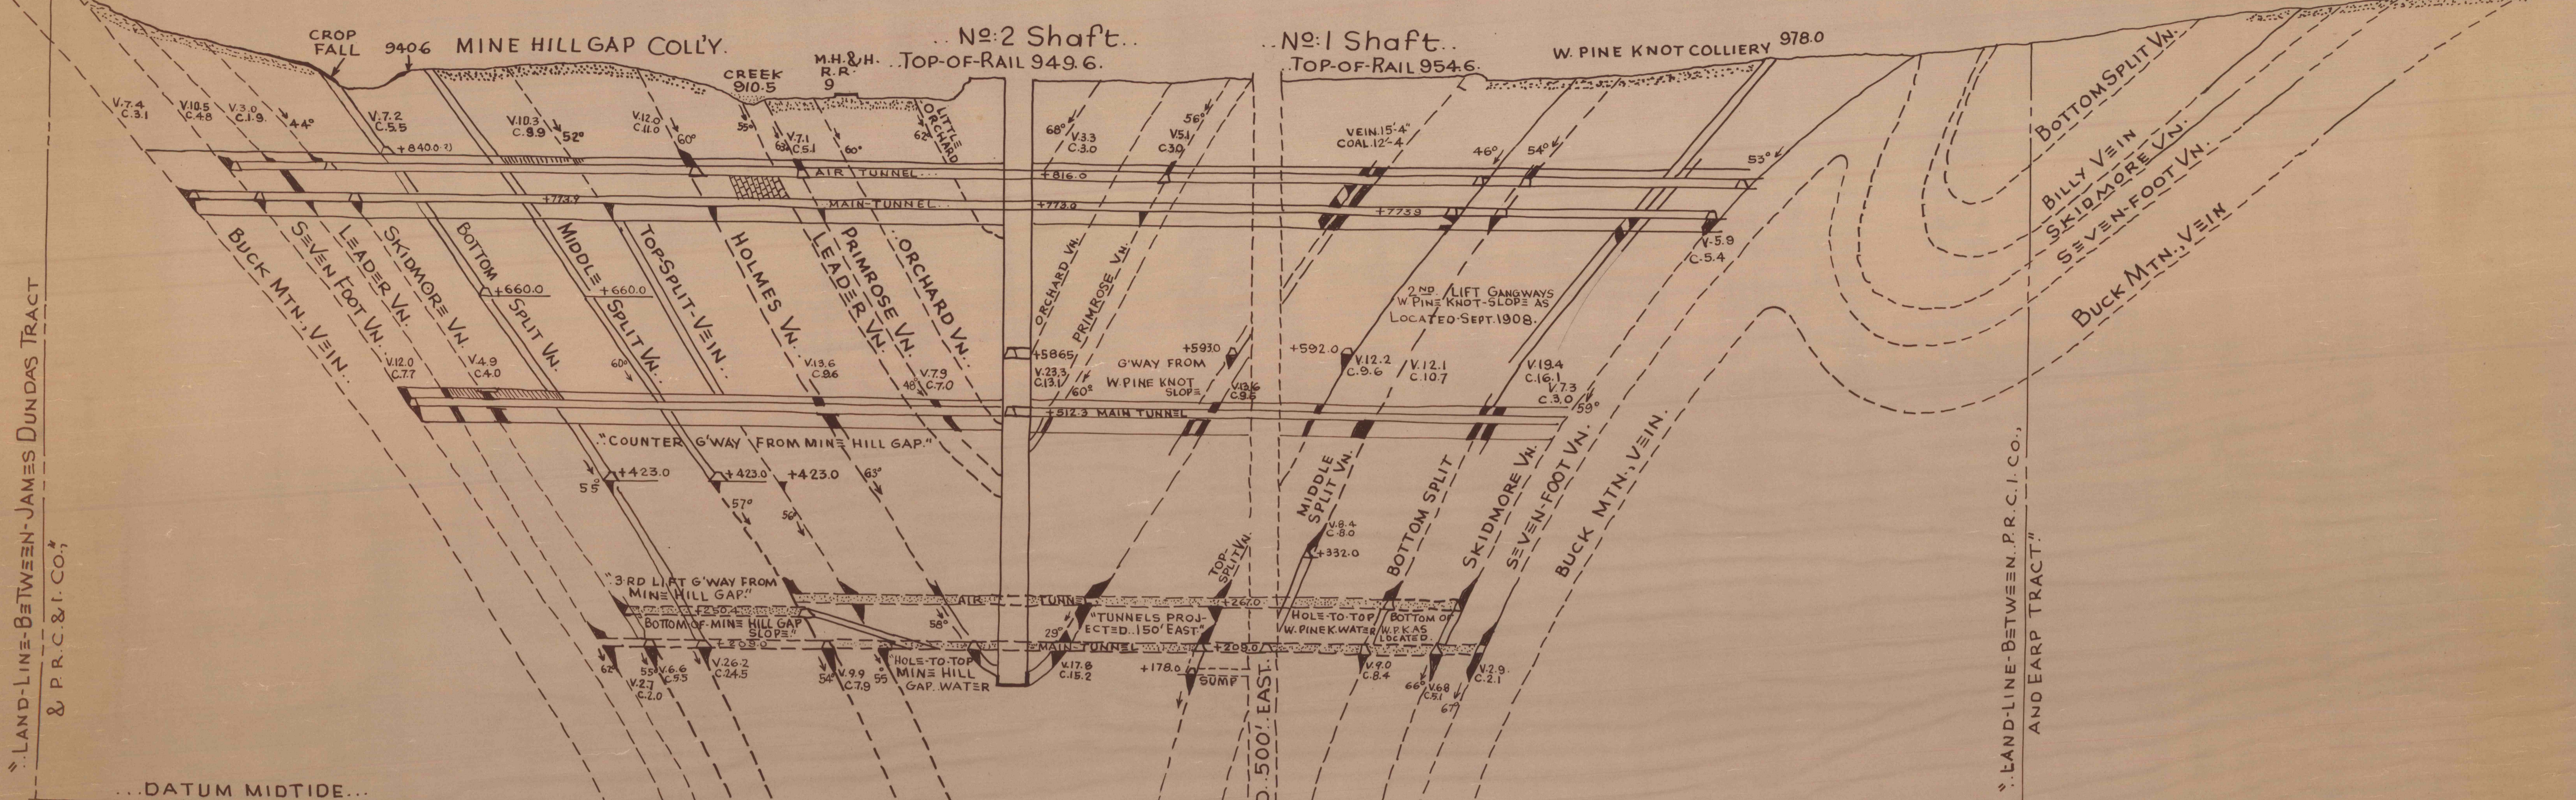

SOUTHERN FIELD
PINE KNOT COLLIERY

CASS Twp., SCHUYLKILL
 @unty, 15 W. SCHUYLKILL
 DISTRICT. READING ANTHRACITE COLLIERIES.
 CROSS SECTION-THRU-NO. 2-SHAFT. 1"=100' POTTSVILLE, PA., 28 DEC., 1910.
 RETRACED; 15 FEB., 1978. DEEP MINE SAFETY. REVISED: 7 JUNE 1912.
 ALEXANDER DROZDA E. F. WEIMER, DIVISION ENGINEER.