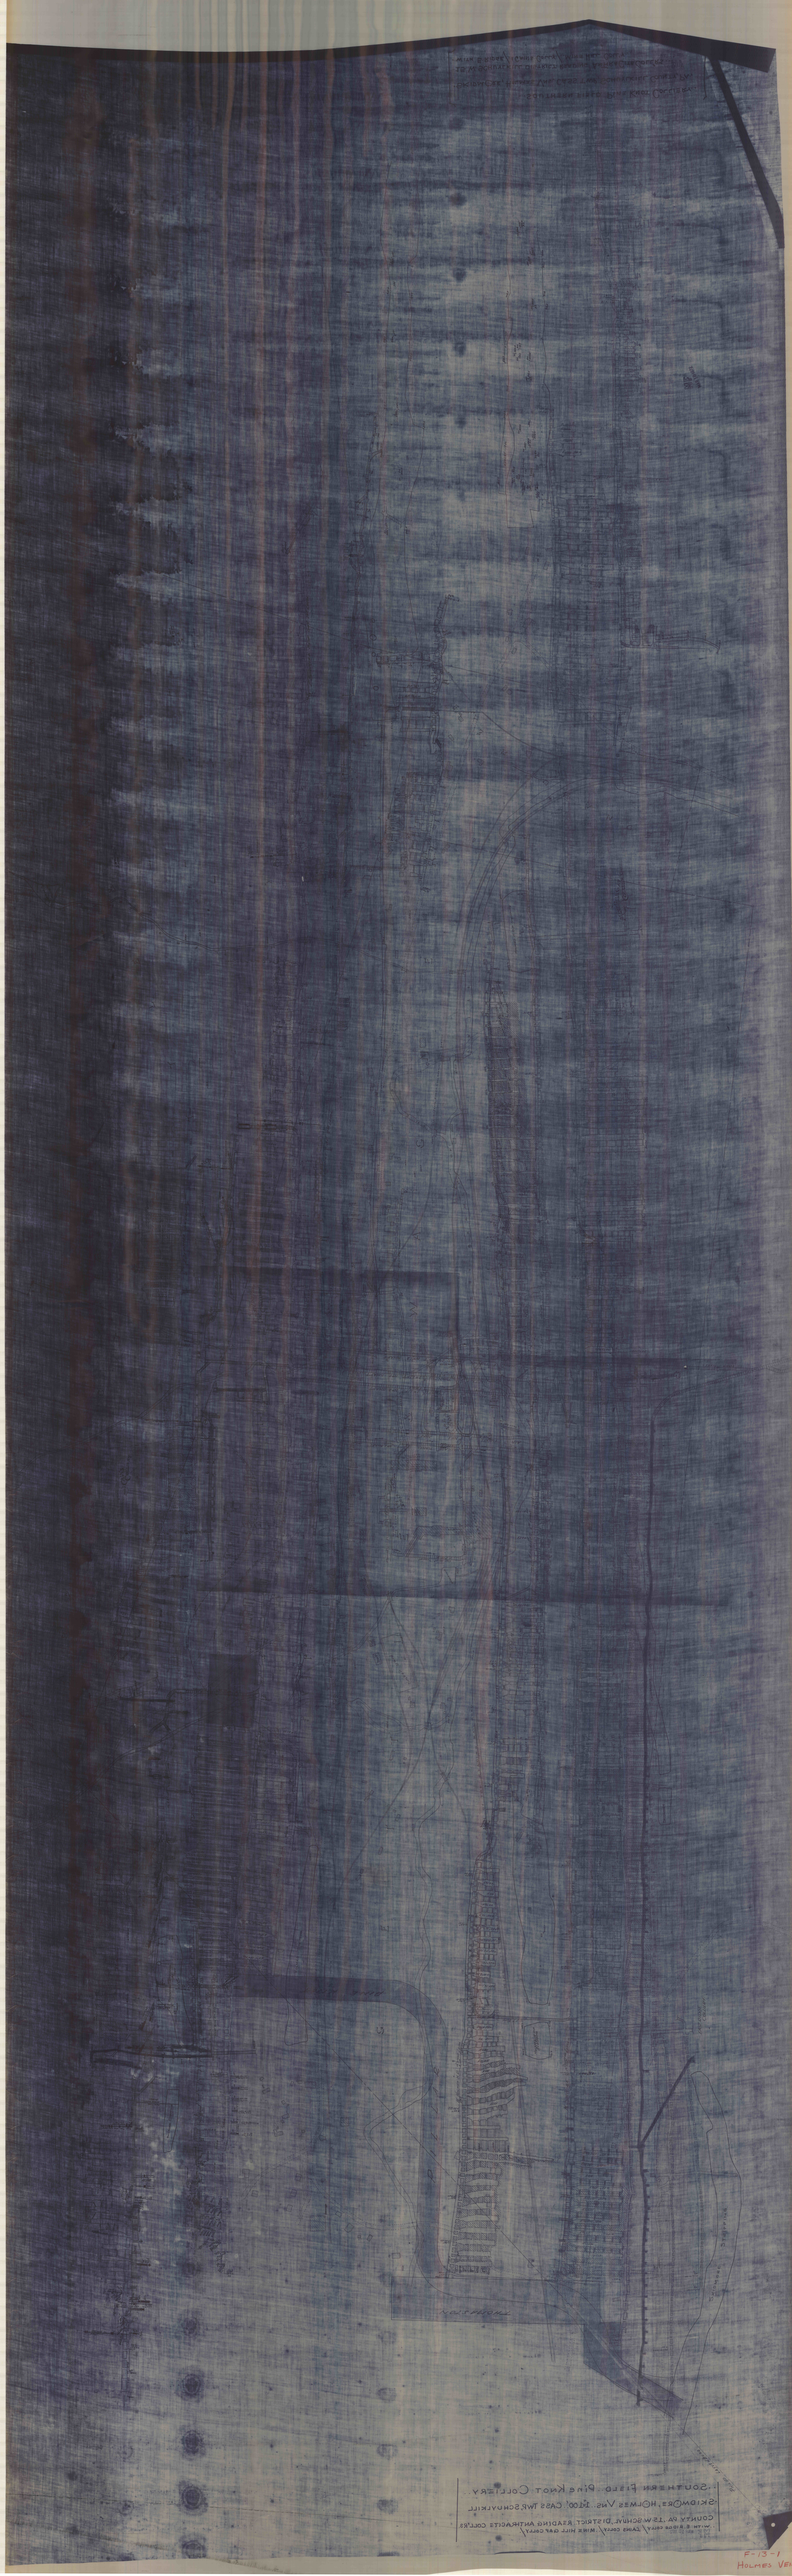

F-13-1
HOLMES VE