F.13.10

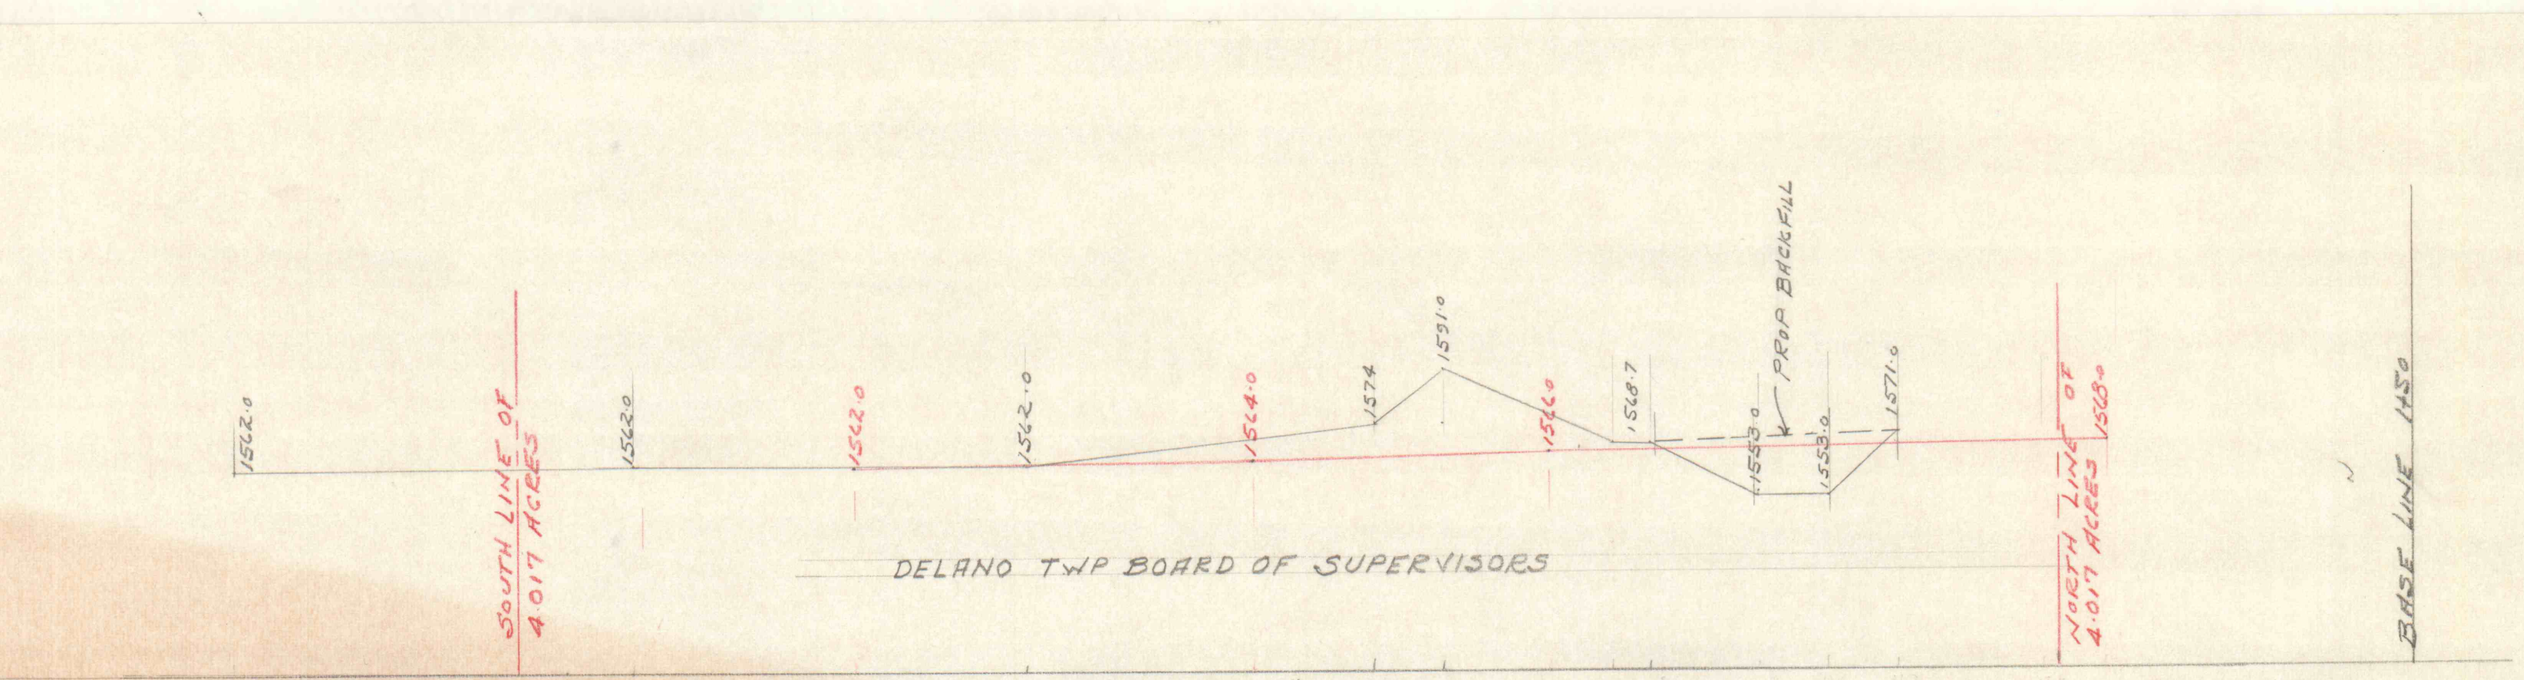

SECTION "B"
LOOKING WEST
SCALE 1" = 50'

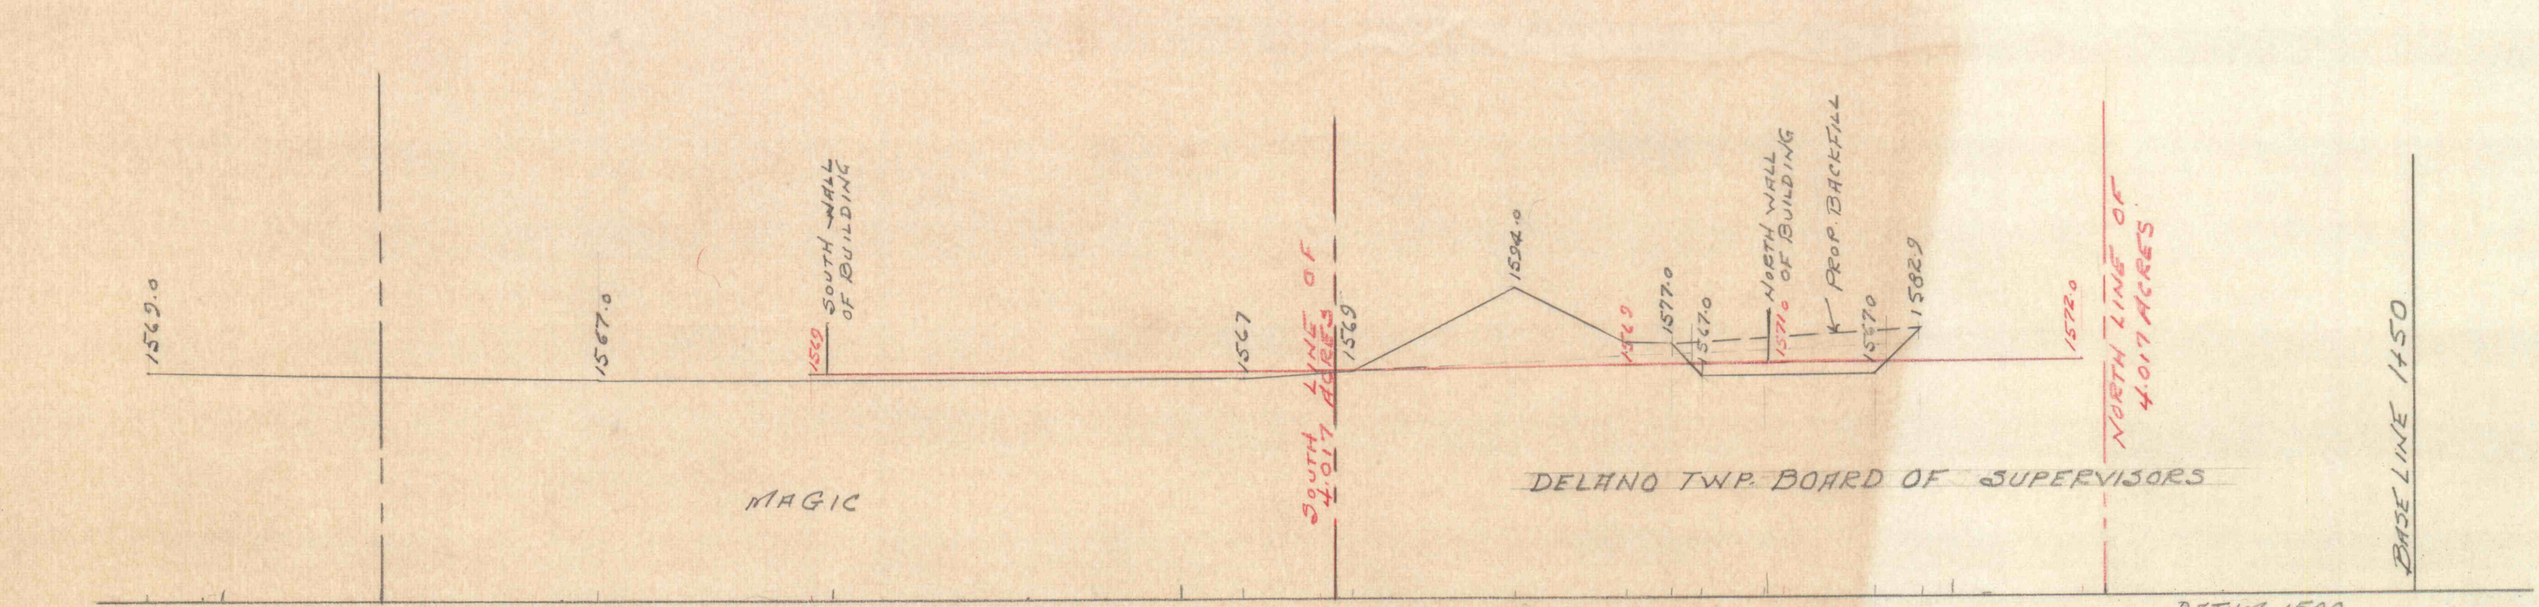

SECTION "A"
LOOKING WEST
SCALE 1" = 50'