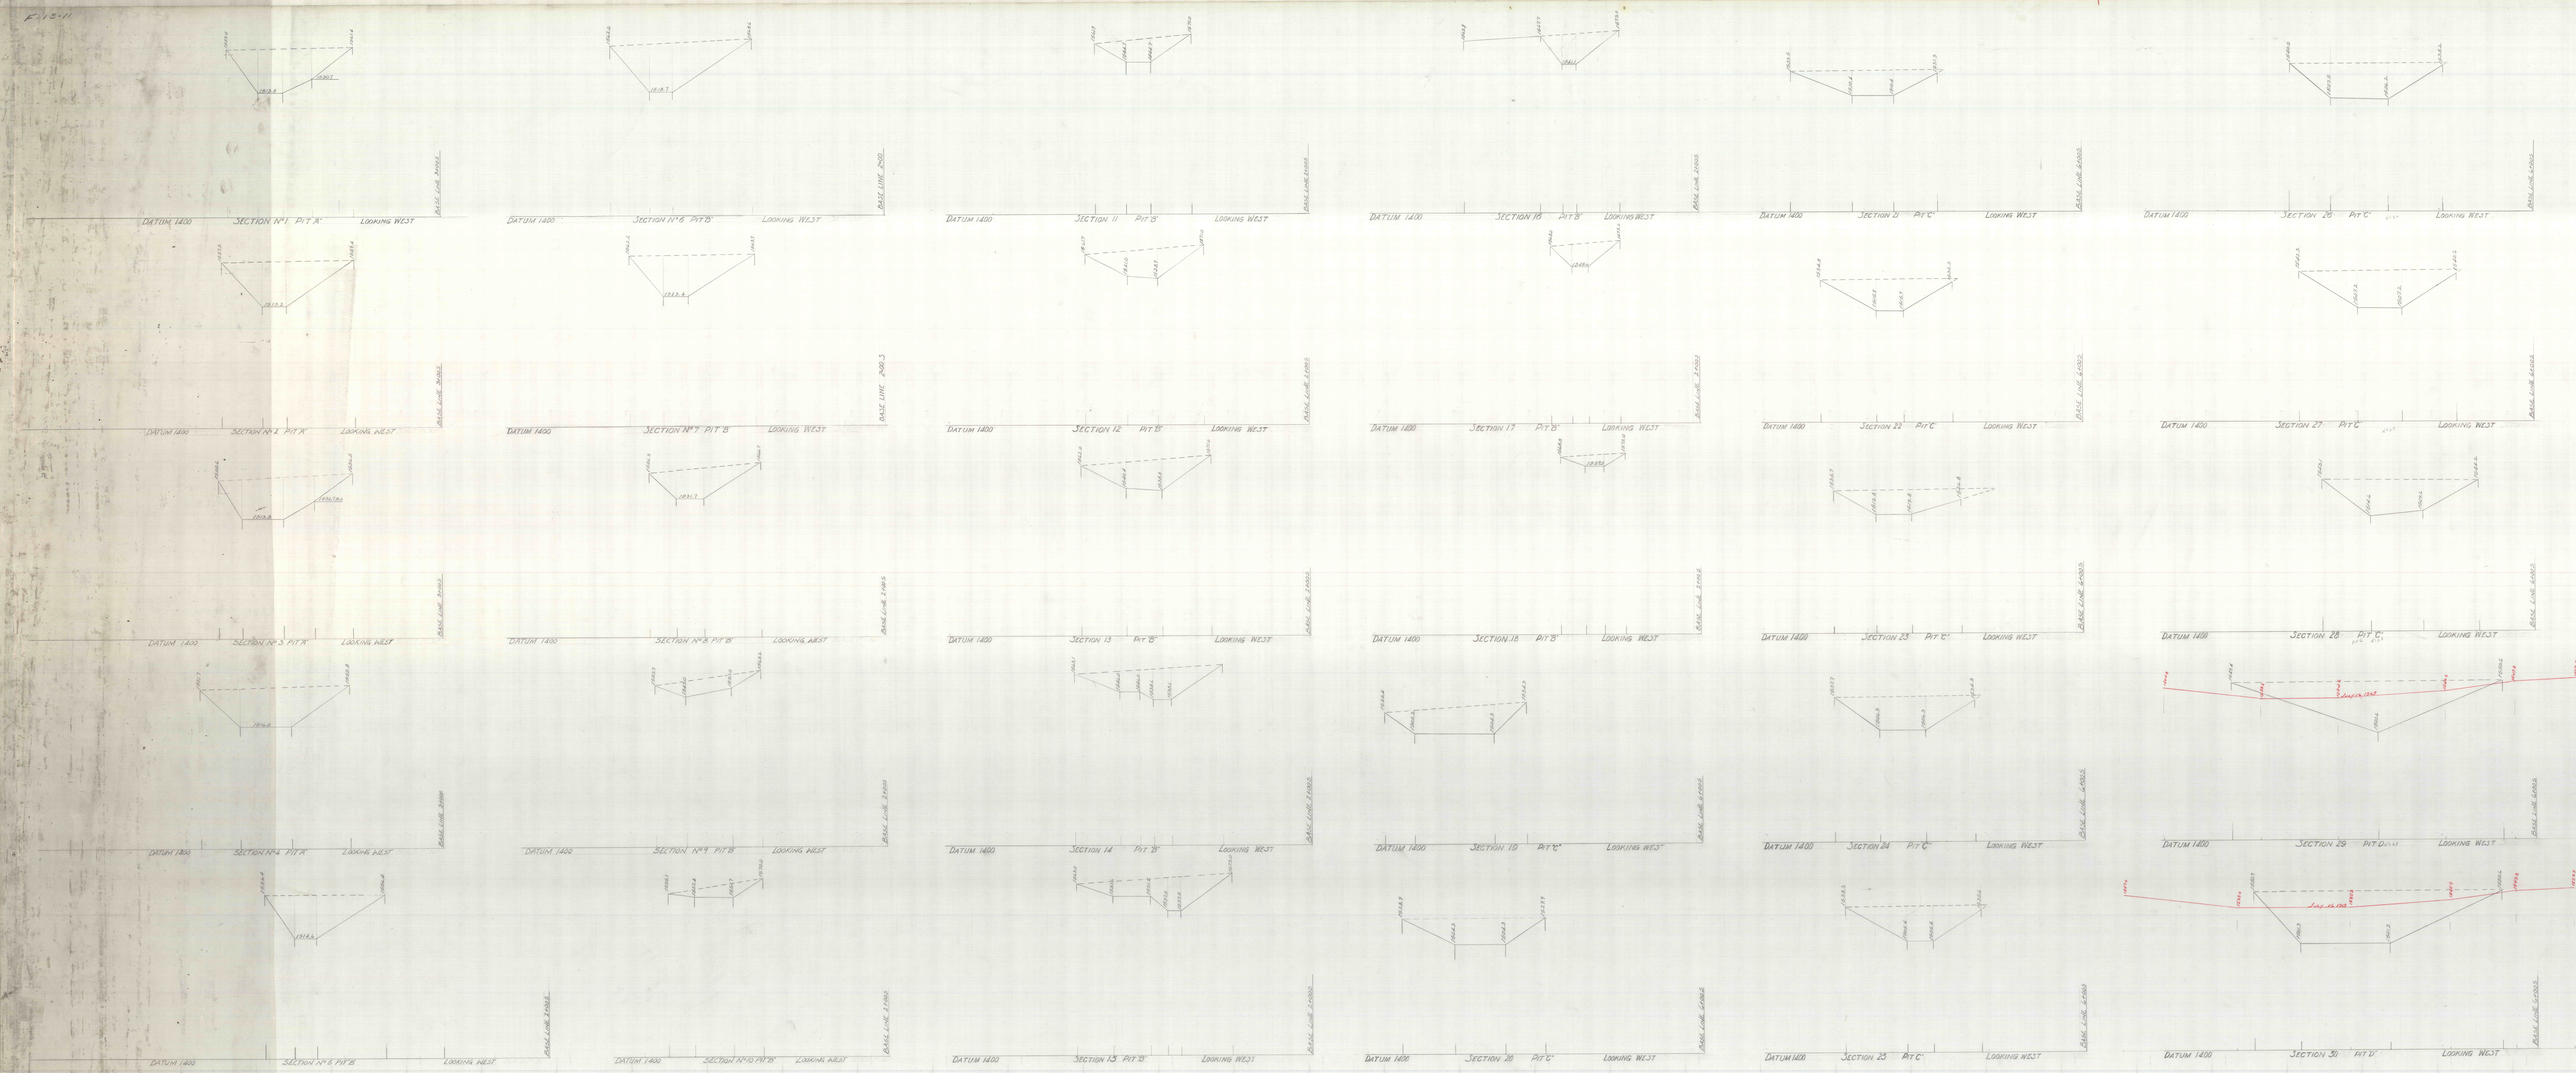
DATUM 1400 SECTION Nº1 PIT 'A' LOOKING WEST
DATUM 1400 SECTION Nº2 PIT 'A' LOOKING WEST
DATUM 1400 SECTION Nº3 PIT 'A' LOOKING WEST
DATUM 1400 SECTION Nº4 PIT 'A' LOOKING WEST
DATUM 1400 SECTION Nº5 PIT 'B' LOOKING WEST
DATUM 1400 SECTION Nº6 PIT 'B' LOOKING WEST
DATUM 1400 SECTION Nº7 PIT 'B' LOOKING WEST
DATUM 1400 SECTION Nº8 PIT 'B' LOOKING WEST
DATUM 1400 SECTION Nº9 PIT 'B' LOOKING WEST
DATUM 1400 SECTION Nº10 PIT 'B' LOOKING WEST
DATUM 1400 SECTION 11 PIT 'B' LOOKING WEST
DATUM 1400 SECTION 12 PIT 'B' LOOKING WEST
DATUM 1400 SECTION 13 PIT 'B' LOOKING WEST
DATUM 1400 SECTION 14 PIT 'B' LOOKING WEST
DATUM 1400 SECTION 15 PIT 'B' LOOKING WEST
DATUM 1400 SECTION 16 PIT 'B' LOOKING WEST
DATUM 1400 SECTION 17 PIT 'B' LOOKING WEST
DATUM 1400 SECTION 18 PIT 'B' LOOKING WEST
DATUM 1400 SECTION 19 PIT 'C' LOOKING WEST
DATUM 1400 SECTION 20 PIT 'C' LOOKING WEST
DATUM 1400 SECTION 21 PIT 'C' LOOKING WEST
DATUM 1400 SECTION 22 PIT 'C' LOOKING WEST
DATUM 1400 SECTION 23 PIT 'C' LOOKING WEST
DATUM 1400 SECTION 24 PIT 'C' LOOKING WEST
DATUM 1400 SECTION 25 PIT 'C' LOOKING WEST
DATUM 1400 SECTION 26 PIT 'C' LOOKING WEST
DATUM 1400 SECTION 27 PIT 'C' LOOKING WEST
DATUM 1400 SECTION 28 PIT 'C' LOOKING WEST
DATUM 1400 SECTION 29 PIT 'D' LOOKING WEST
DATUM 1400 SECTION 30 PIT 'D' LOOKING WEST