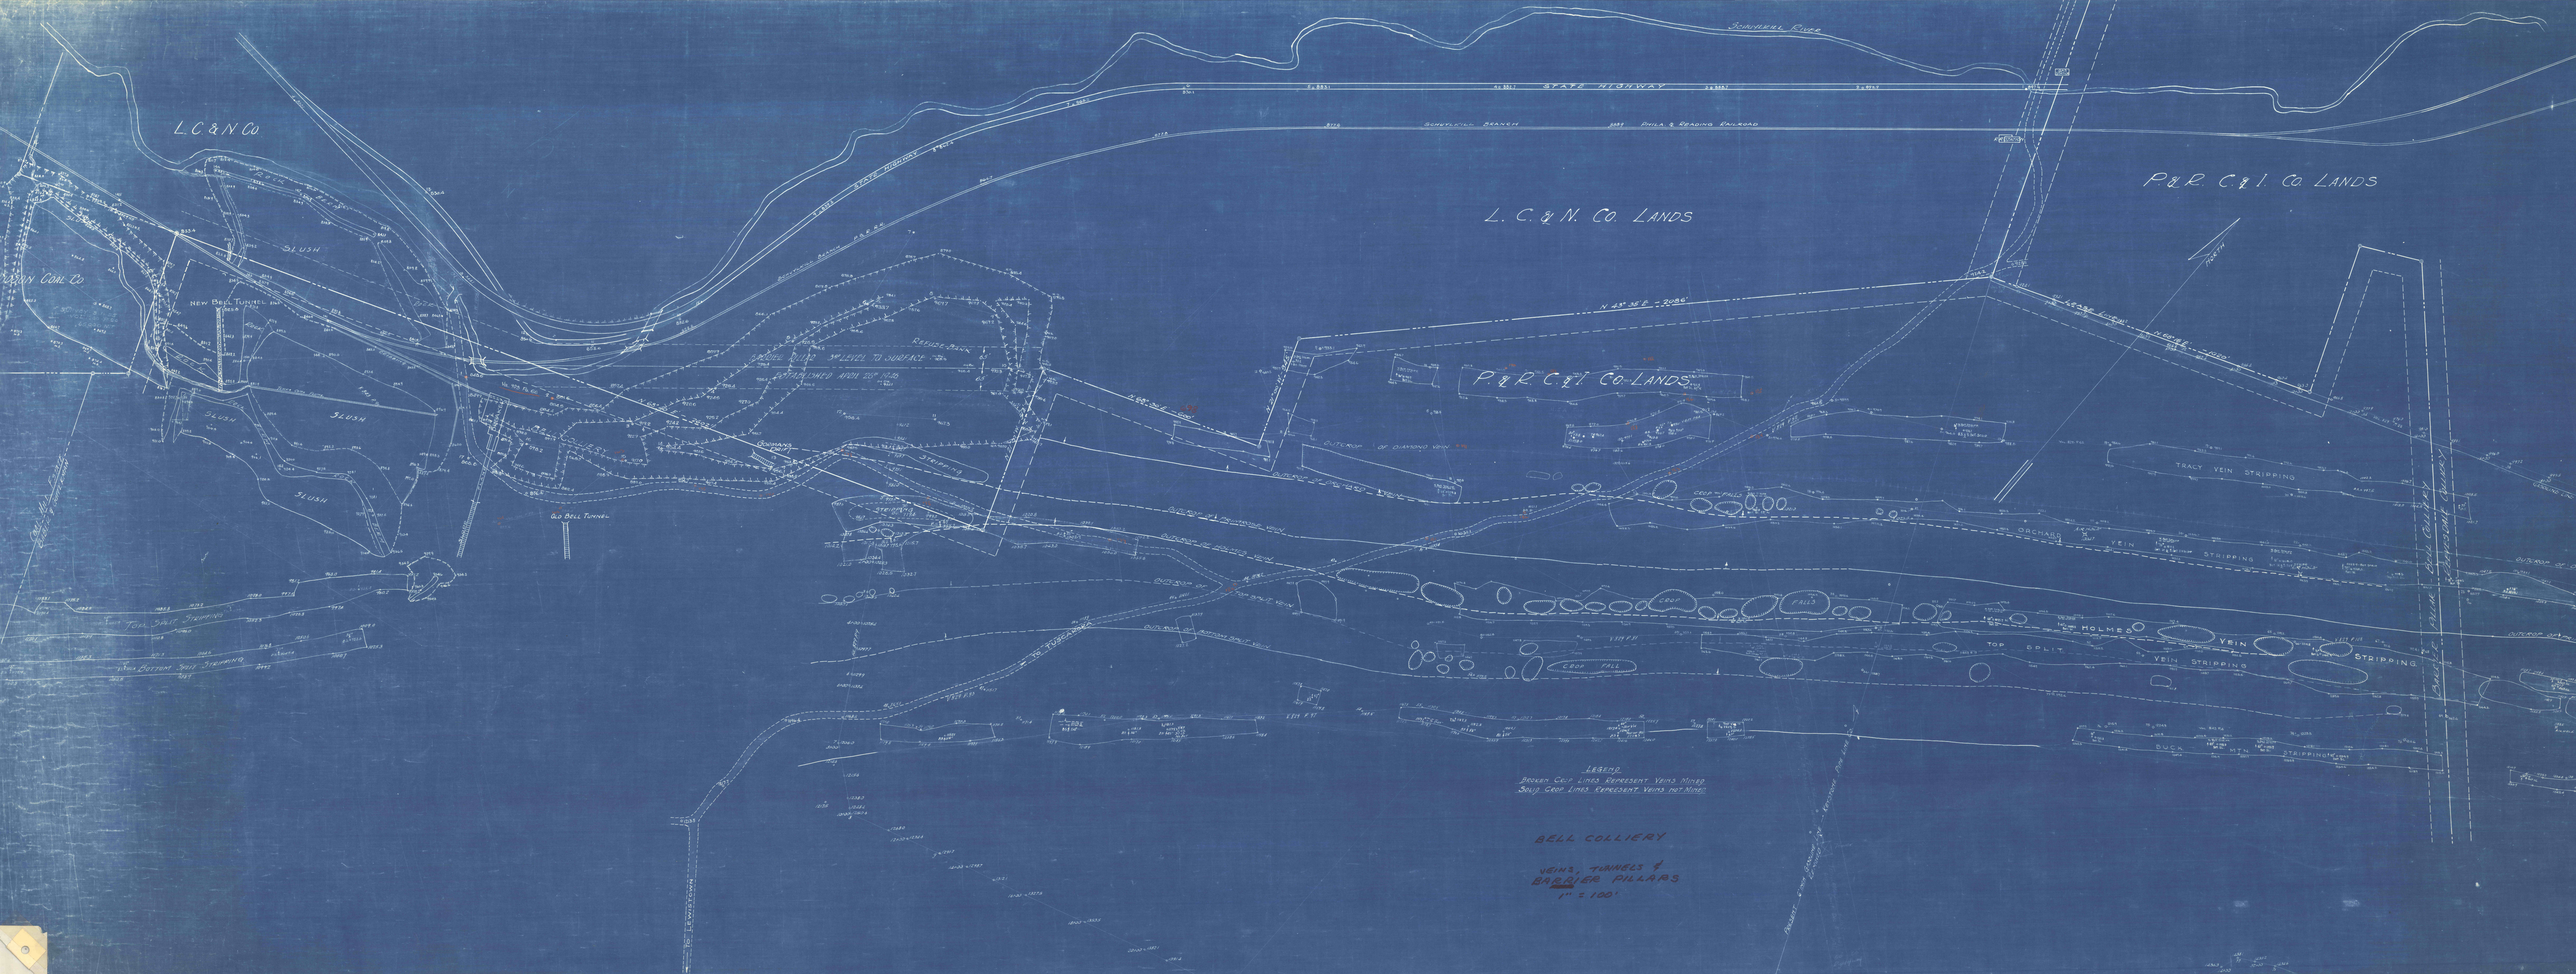
L.C.&N. Co.
L. C. & N. Co. LANDS
P.&R. C.&I. Co. LANDS
P.&R. C.&I. Co-LANDS
STATE HIGHWAY
SCHUYLKILL RIVER
SCHUYLKILL BRANCH
PHILA. & READING RAILROAD
SLUSH
NEW BELL TUNNEL
OLD BELL TUNNEL
REFUSE PILE
STRIPPING
TRACY VEIN STRIPPING
OSCHALA VEIN STRIPPING
TOP SPLIT VEIN STRIPPING
DUCK MTN. STRIPPING
CROP FALL
FALLS
LEGEND
Broken Crop Lines Represent Veins Mined
Solid Crop Lines Represent Veins not Mined
BELL COLLIERY
VEINS, TUNNELS & BARRIER PILLARS
1" = 100'