
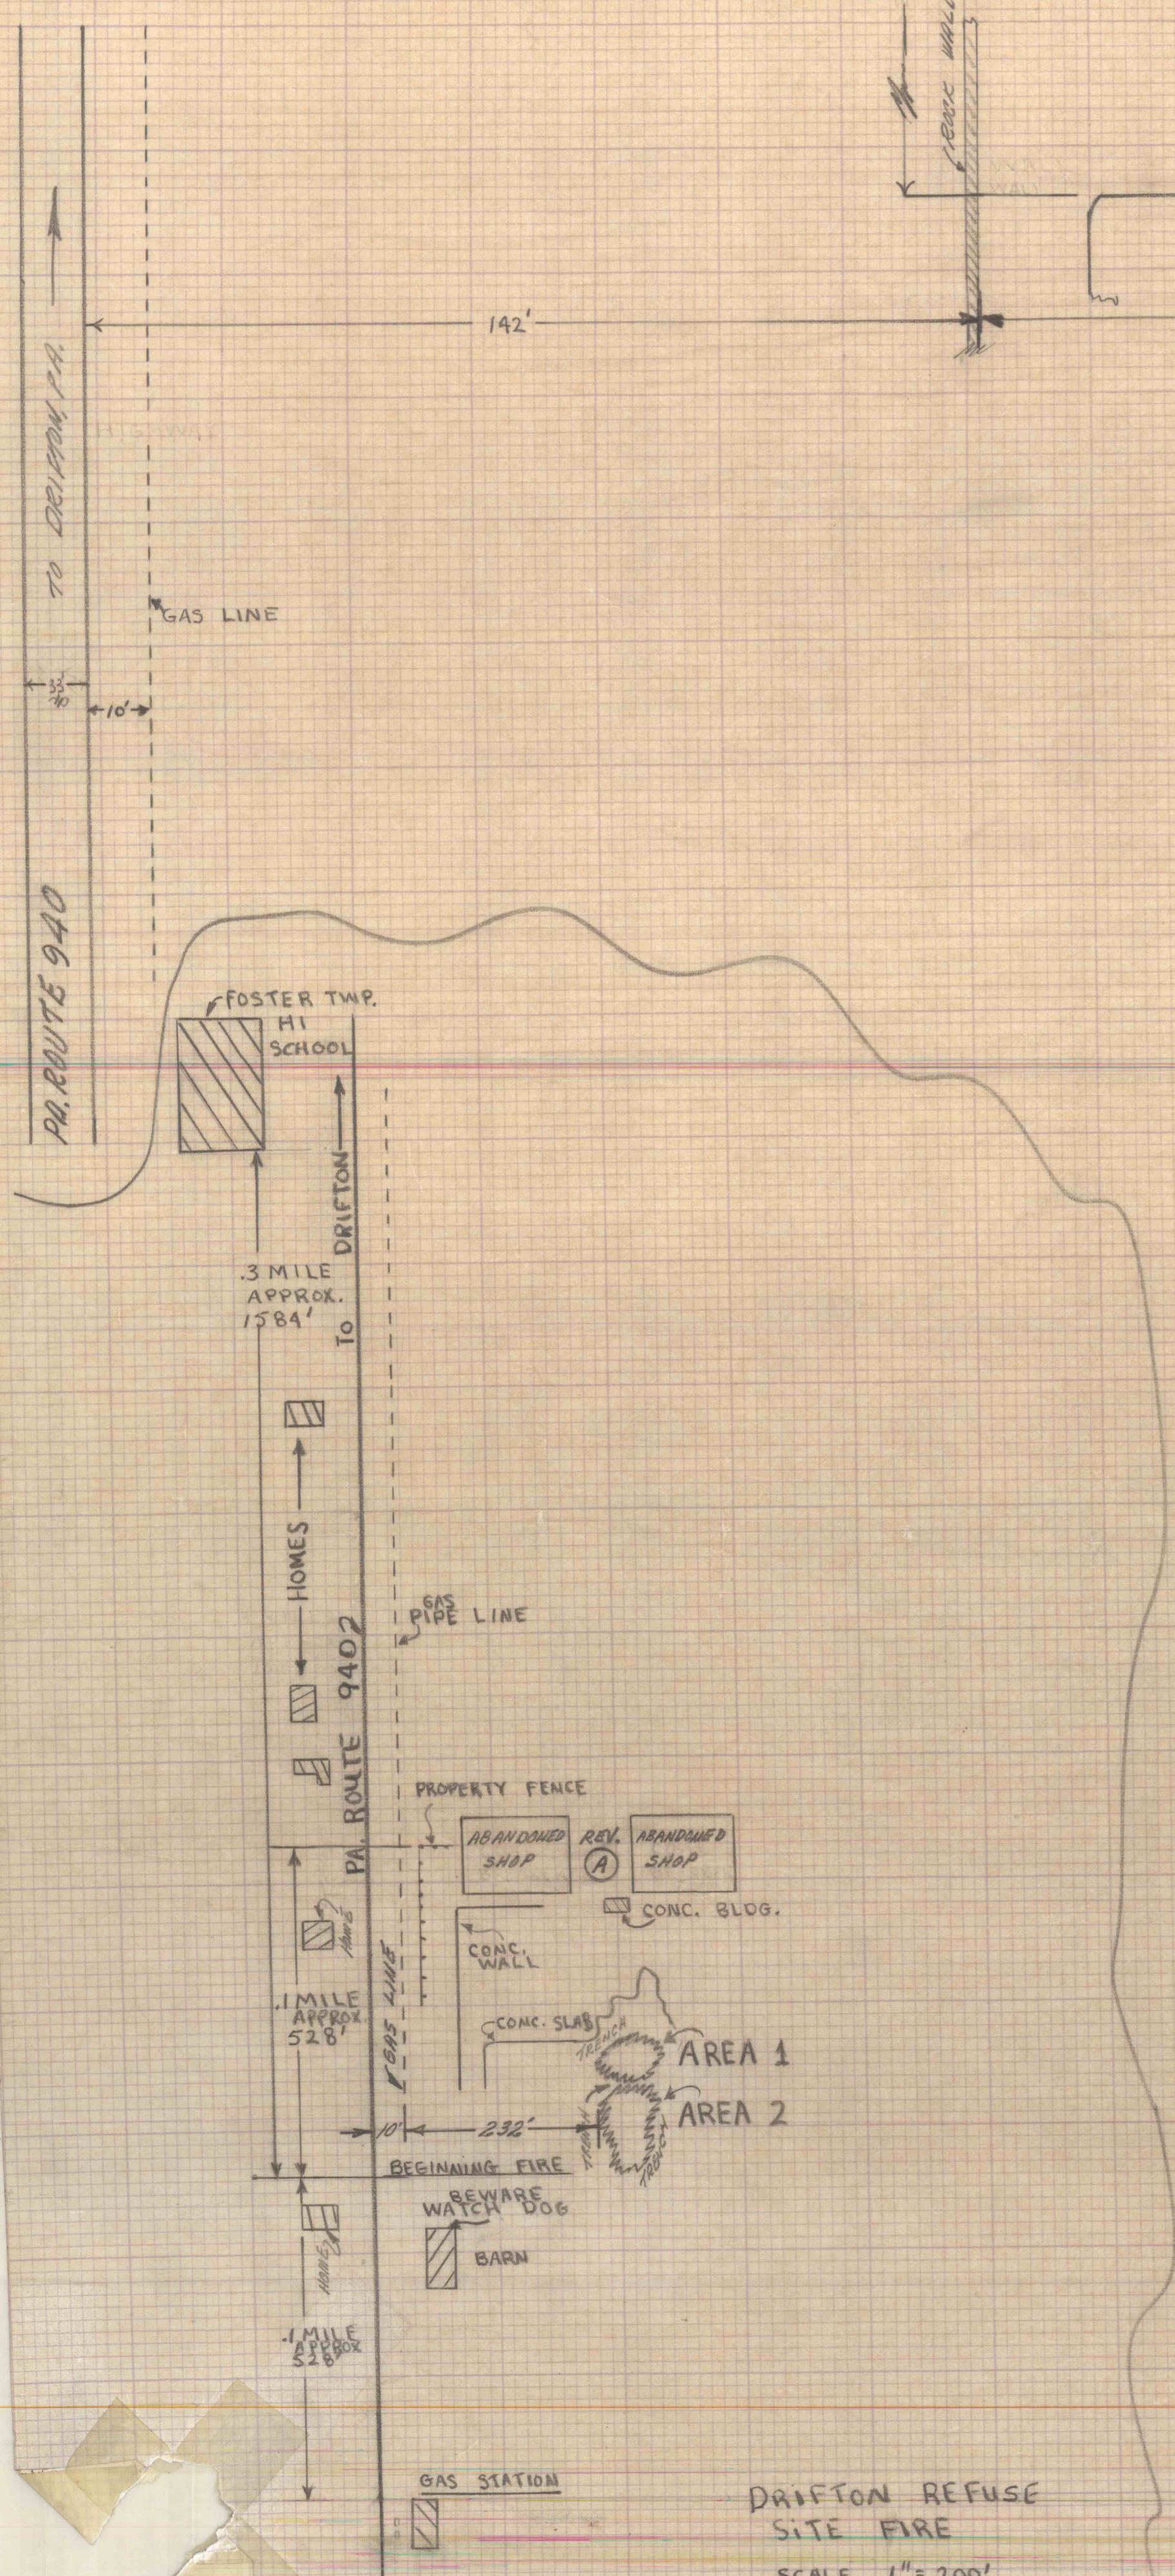


3519 CU. YDS.  
 TOTAL AREA 1 + AREA 2  
 SCALE 1" = 80'  
 TOTAL VOLUME  
 1536 = 3519  
 SLAB = 6222  
 2,741 CU. YDS.

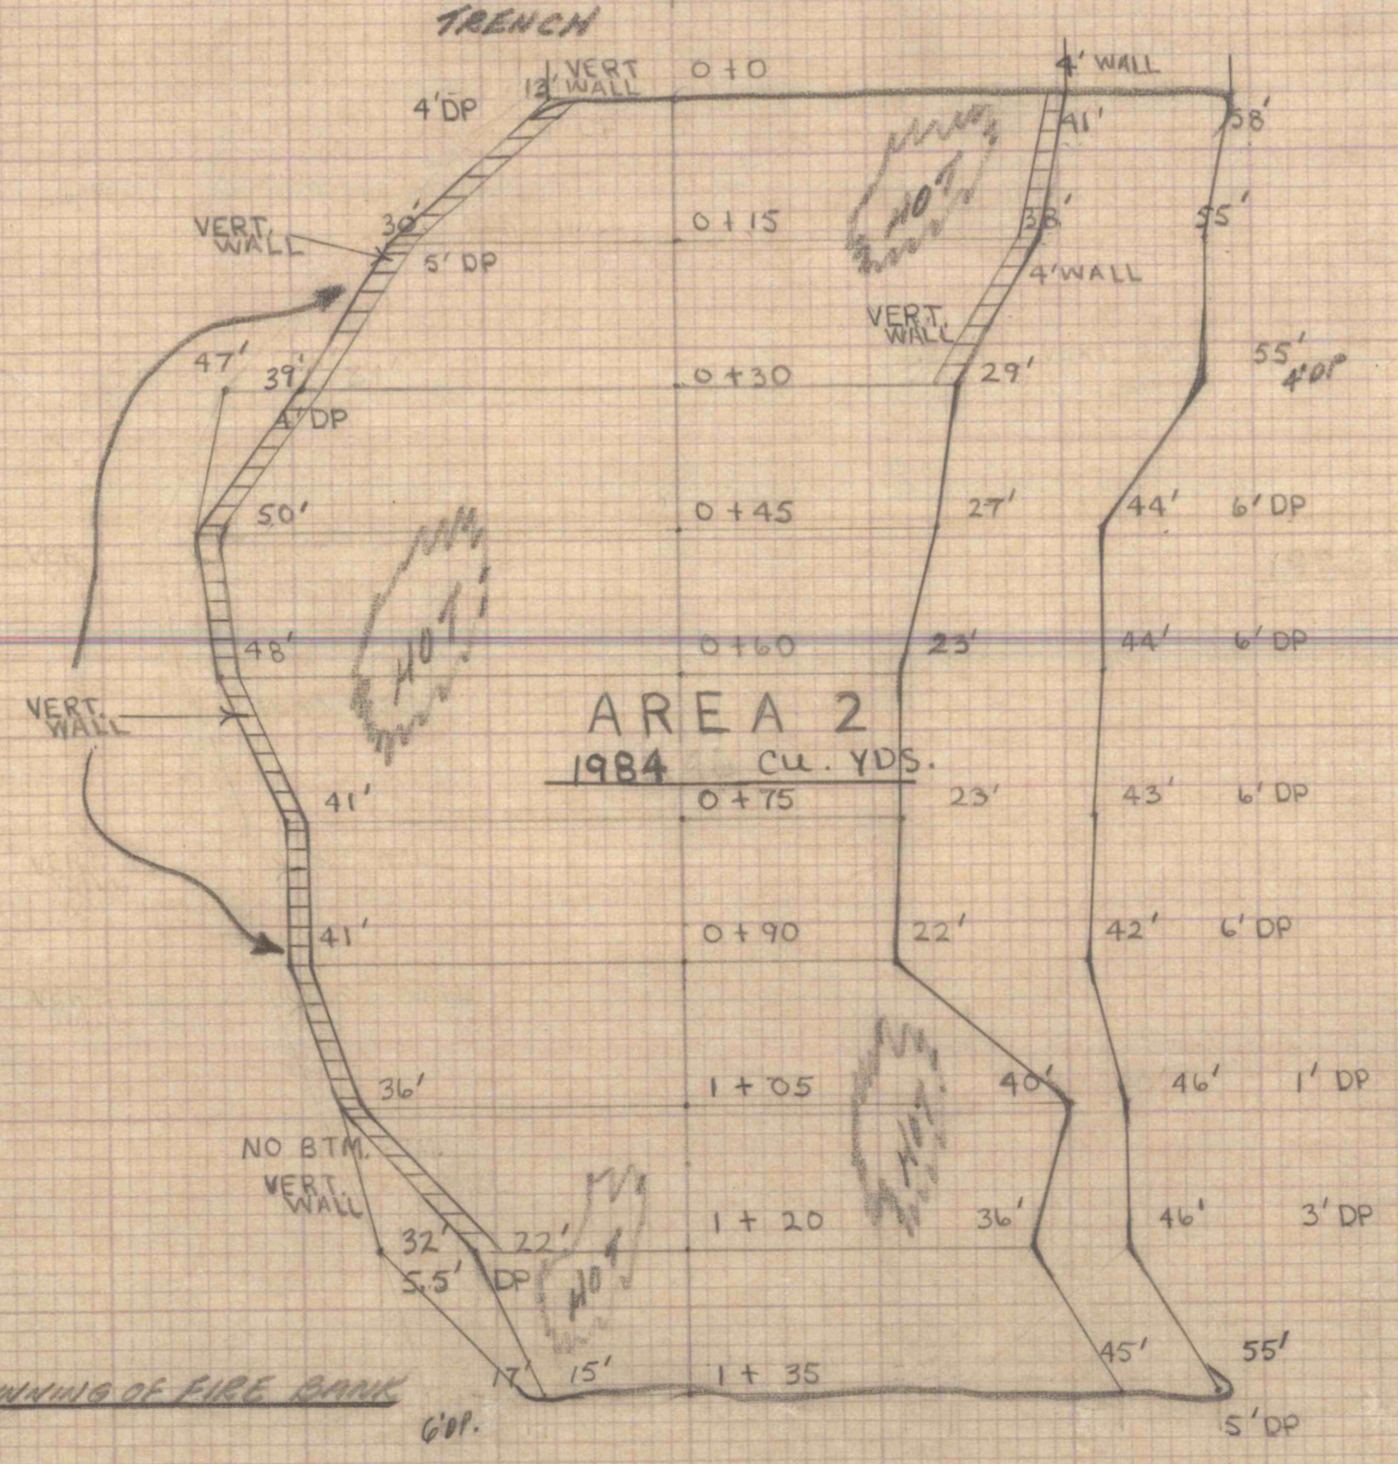

DRIFTON REFUSE  
 SITE FIRE  
 SCALE 1" = 200'

EASTERN MIDDLE FIELD:  
 FOSTER TWP. 7-BLACK Creek DIST.  
 COXE BRO. & Co., INC.,  
 MRS. DONNA CRAIG  
 DRIFTON, PA., LUZERNE CTY.  
 SCALE 1" = 20' N. HERRICK  
 T. VINTYRINA  
 M.B.D. NOV. 27, 1974 J.M.N. ZELINSKI  
 DRAWN BY: KEITH A. LASLOW  
 REV. (A) ABANDONED SHOP WAS COAL BREAKER  
 12.4.78 M.M.S.