


3519 CU. YDS.
 TOTAL AREA 1 + AREA 2
 SCALE 1" = 20'
 TOTAL VOLUME
 182 = 3519
 SLAB = 6222
 2741 CU. YDS.

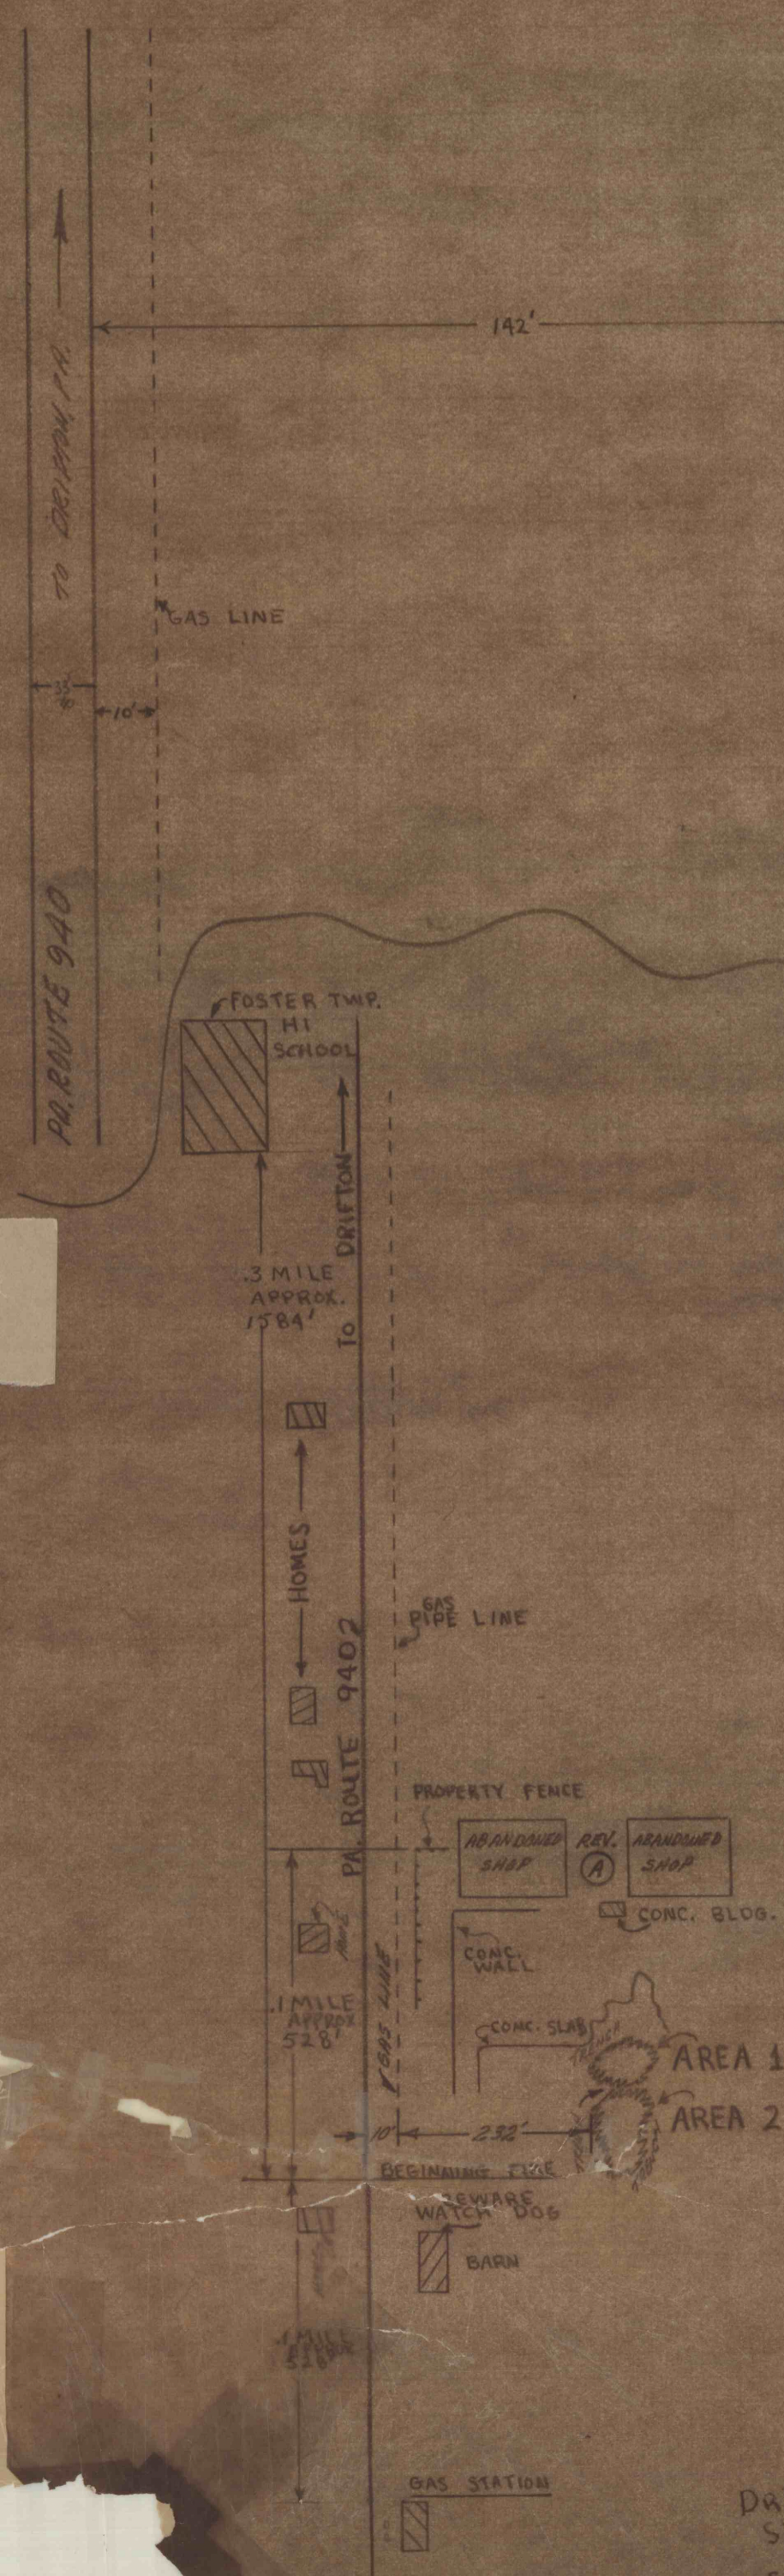

DRIFTON REFUSE
 SITE FIRE
 SCALE 1" = 200'

MRS. DONNA CRAIG
 DRIFTON, PA., LUZERNE CO.
 SCALE 1" = 20'
 DEC. 11, 1974
 DRAWN BY: KEITH A. LASLOVI
 REV. (A) ABANDONED SHOP WAS COAL BURNER
 12-4-74 M.A.S.