


3519 CU. YDS.
 TOTAL AREA 1 + AREA 2
 SCALE 1" = 50'
 TOTAL VOLUME
 1536 + 1984
 SLAB = 6222
 3141 CU. YDS.

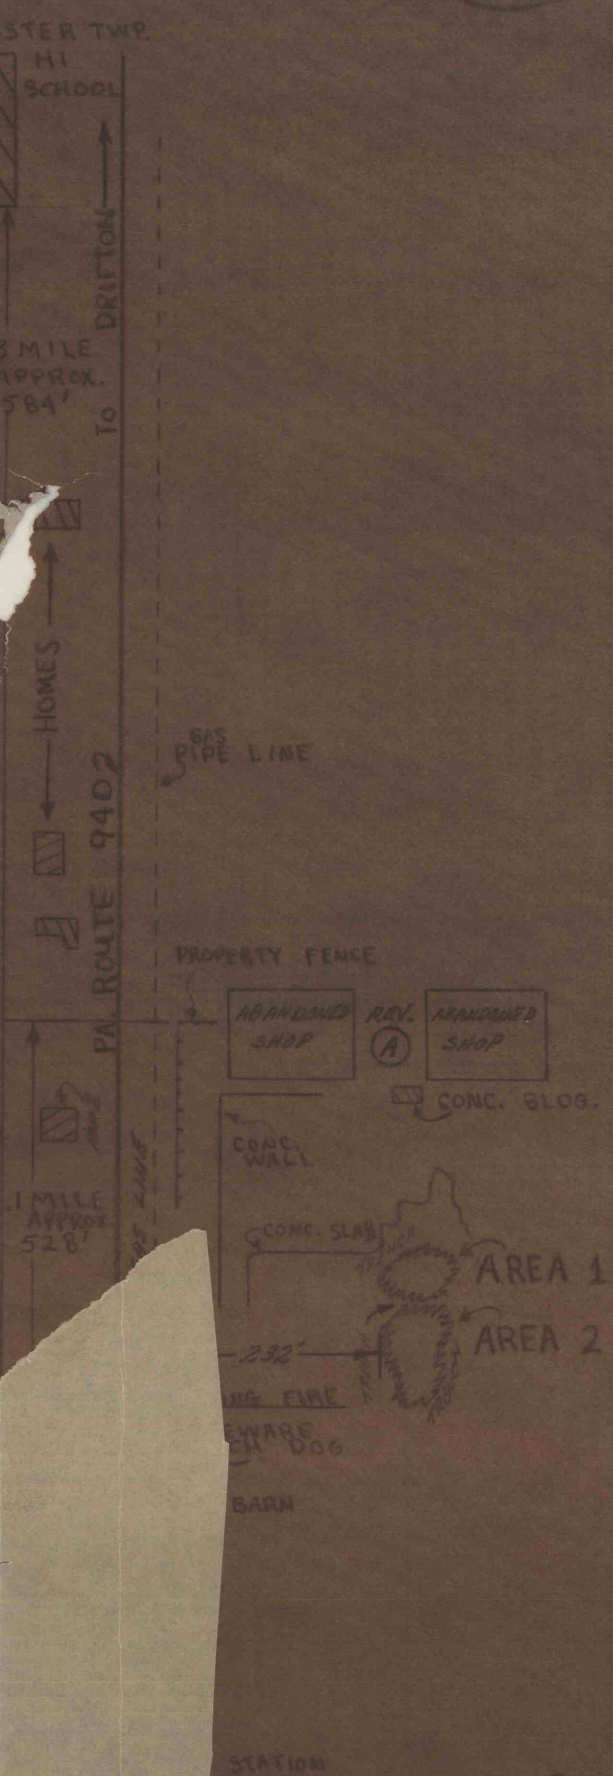

DRIFTON REFUSE
 SITE FIRE
 SCALE 200'

MRS. DONNA CRAIG
 DRIFTON, PA., LUZERN CO.,
 SCALE 1" = 20'
 AUG. 21, 1978
 DRAWN BY: KEVIN A. WILSON
 REV. (A) ABANDONED SHOP W/RE CON. BLDG.