

BELTRAMI LEE Prop North Line

Shot Angle Dist

$\pi$  @ T103 - B.S. - T104

T103 - T104 0°00'00" -

646.48  
617.75  

---

28.73

T103 - T201 114°14' 617.748 SET HIT T201

$\pi$  @ T201 - B.S. - T103

T201 - T103 0°00'00" -

253°31'  
180.00  

---

73°31'

T201 - T202 180°00'00" 28.73 SET HIT T202

$\pi$  @ T202 - B.S. - T201

T202 - T201 0°00'00" -

T202 - T203 253°31' 517.778 SET HIT T203


$\pi$  @ T203 - B.S. - T202

T203 - T202 0°00'00" -

T203 - T204 180°00'00" 682.22 SET HIT T204

BELTRAMI JOE LOE Prop North Line

REF: PAGE 67 - THIS BOOK

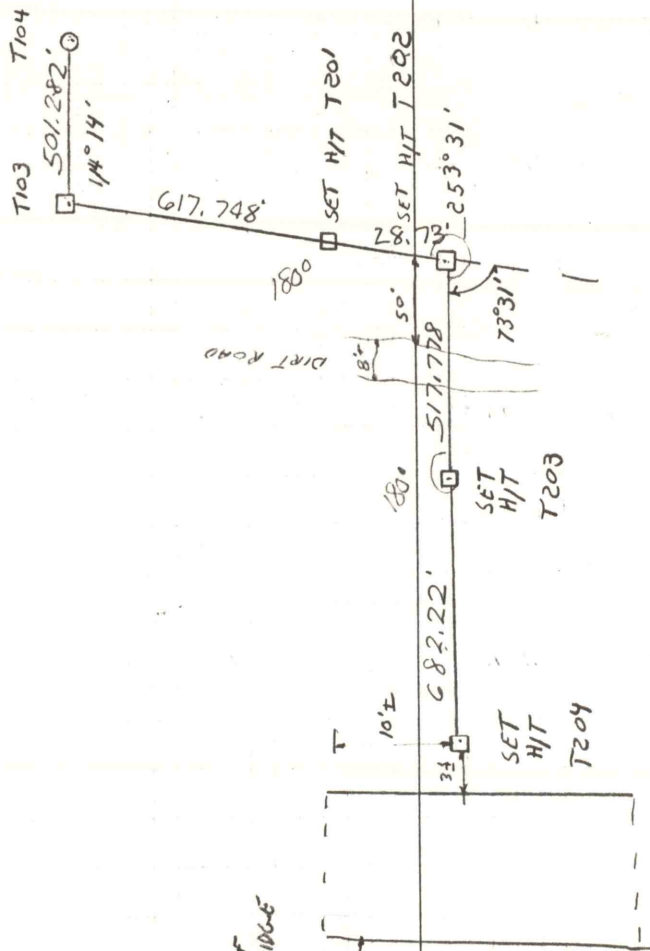

SOME KIND OF  
CONCRETE BRIDGE  
OR TUNNEL