

BELTRAMI Joe Lee North Line 12-12-78

Shot Angle DIST

π @ T204 - BS - T203

T204-T203 0°00'00"

T204-T205 186°08' 478.063 SET PK T205

π @ T205 - BS - T204

T205-T204 0°00'00"

T205-T206 79°13'18" 704.618 SET HIT T206

π @ T206 - BS - T205

T206-T205 0°00'00"

T206-T207 174°05'34" 311.125' EXT HIT T207

SEE PAGE 60


π @ T207 - BS - T206

T207-T206 0°00'00"

T207-T208 86°41'18"

EXT 2" I.R. T208  
SEE PAGE 60

BELTRAMI Joe Lee North Line 12-12-78 72

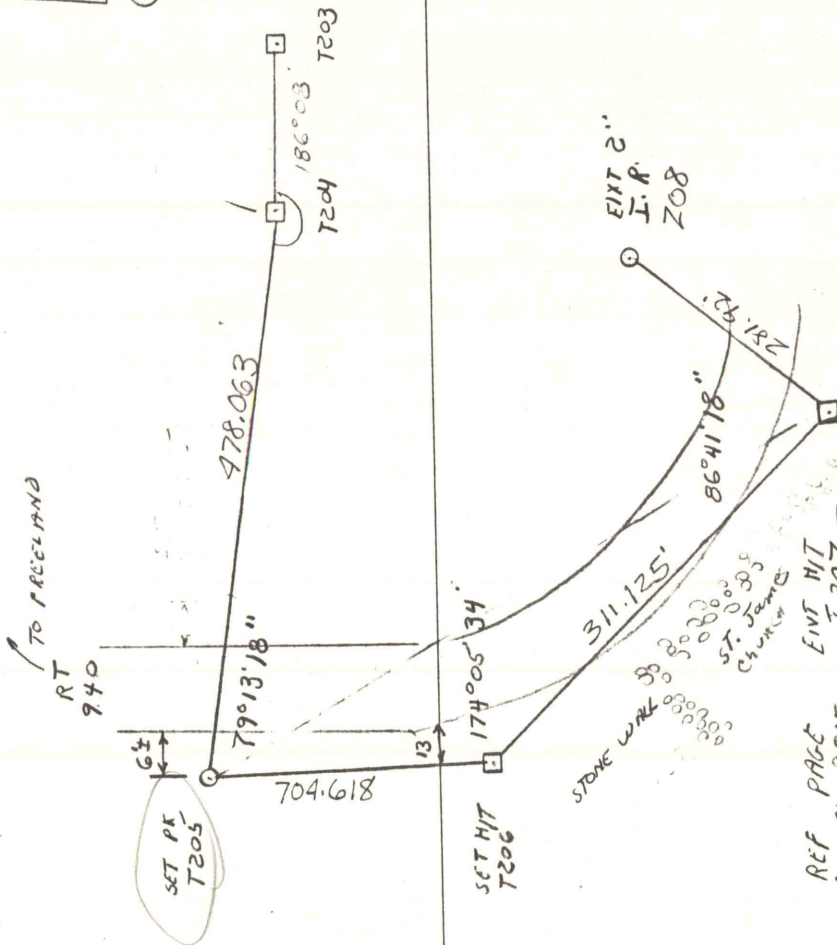

EXT HIT T207  
REF PAGE 60