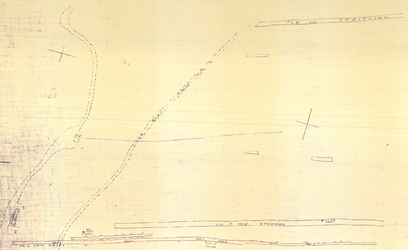

MAR BERN COAL CO
MINE WORKING

Year // Southern Coal Field...
/ Sherman Colliery, Limit
• All Veins... Schuylkill County
Pottsville, Pa.

Mine Symbol Code.
Coal Veins Worked. Normegian and Sherman Coal Co.
Sherman Colliery, Southern Field.
Copyright by T.B.S.A.D.

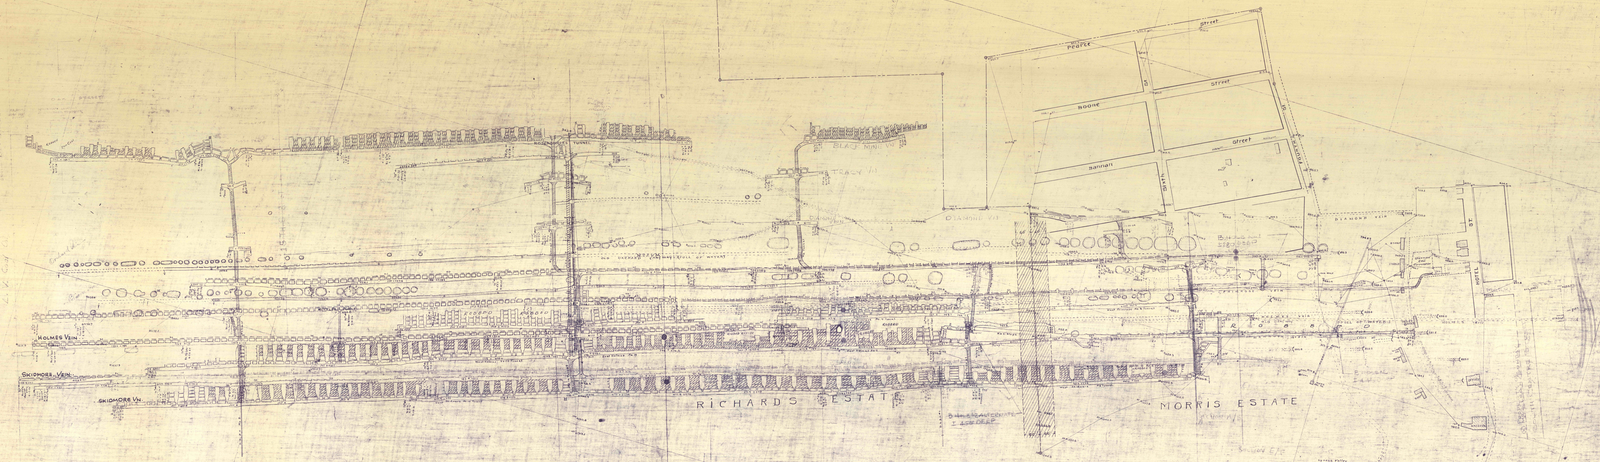

STATE MINE INSPECTOR'S
MAP
SHERMAN COAL CORPORATION
MINE WORKINGS — POTTSVILLE PA.