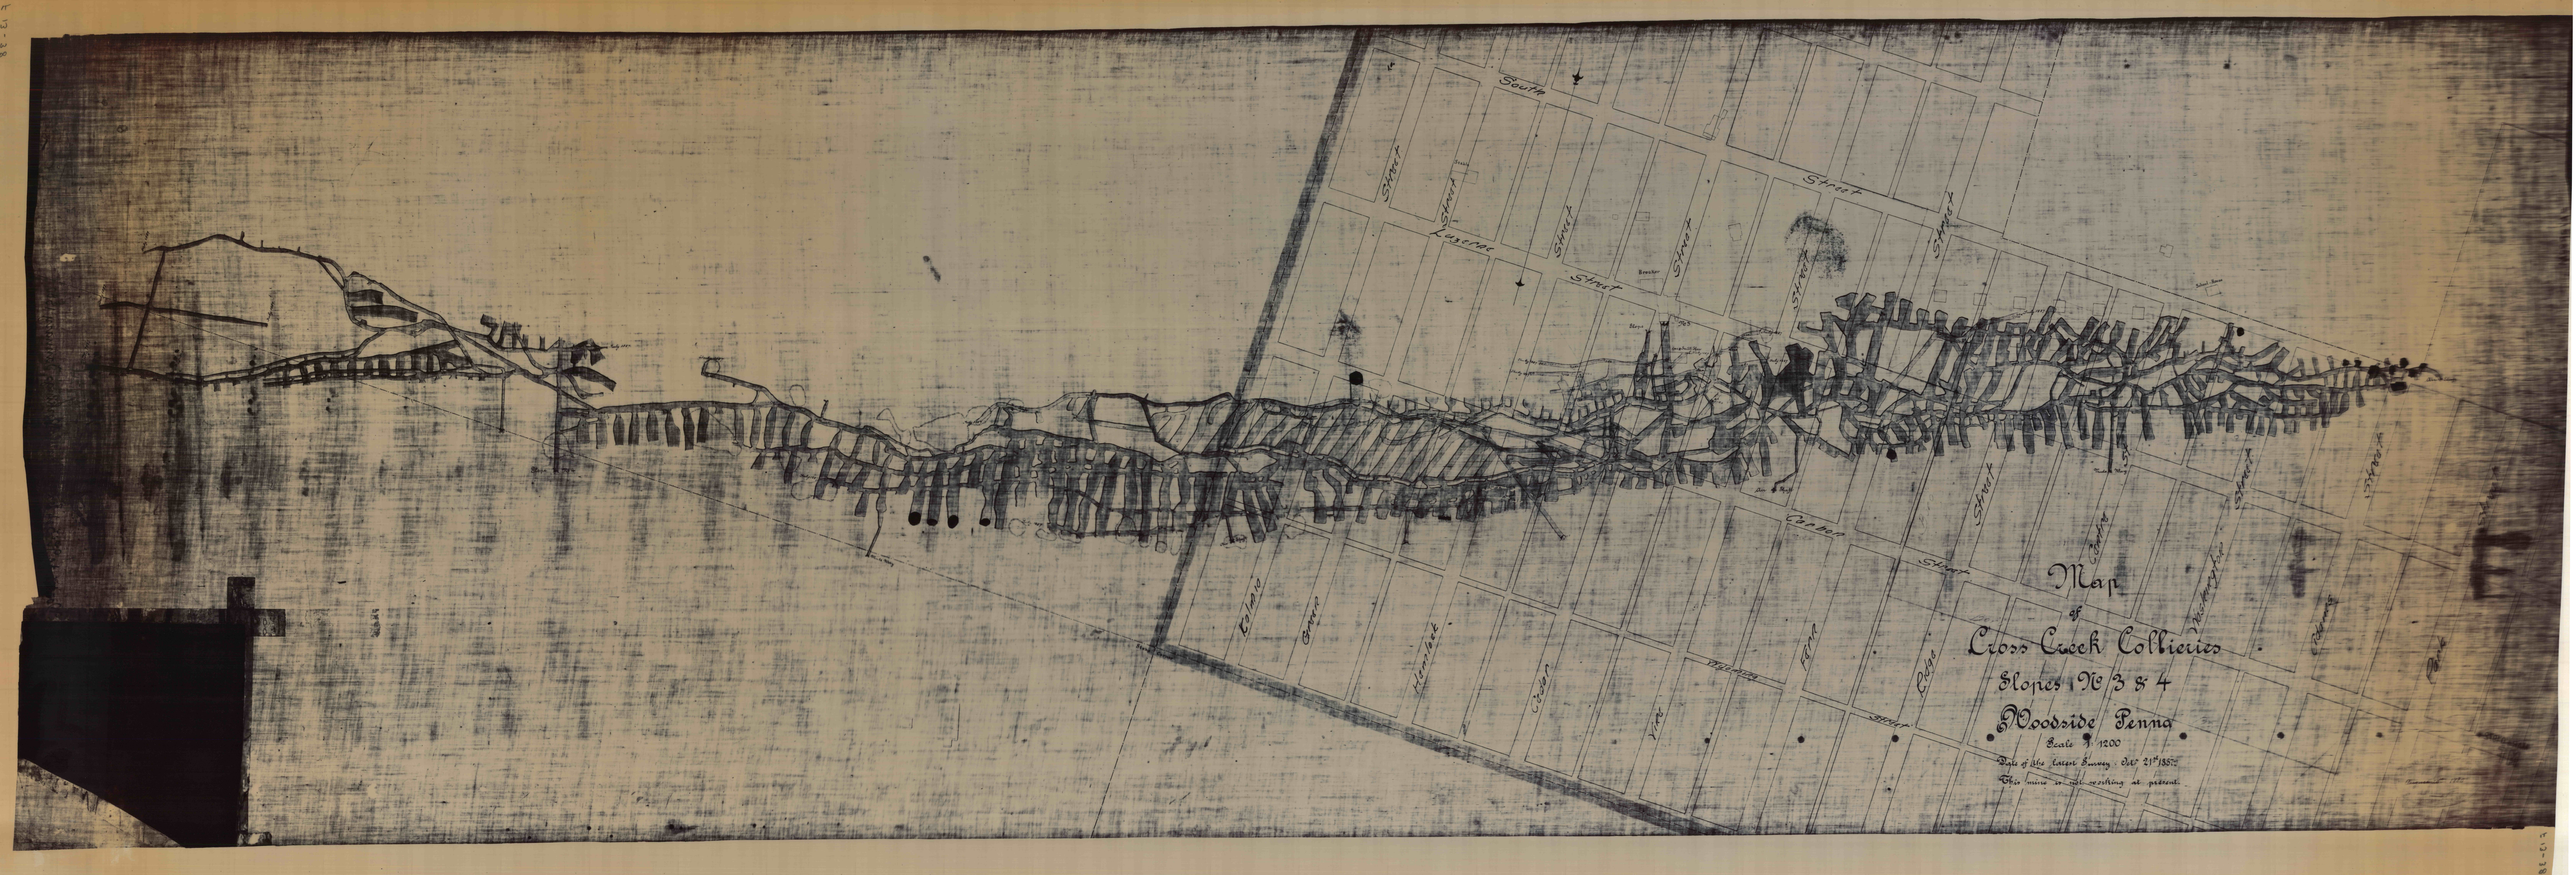
Map
of
Cross Creek Collieries
Slopes No 3 & 4
Woodside Penna
Scale 1" 1200
Date of the Latest Survey, Oct 21st 1886
This mine is not working at present.
South
Street
Lusaras
Brewer
Store
Carbon
Stream
Cedar
Walnut
Pine
Mulberry
Locust
Chestnut
