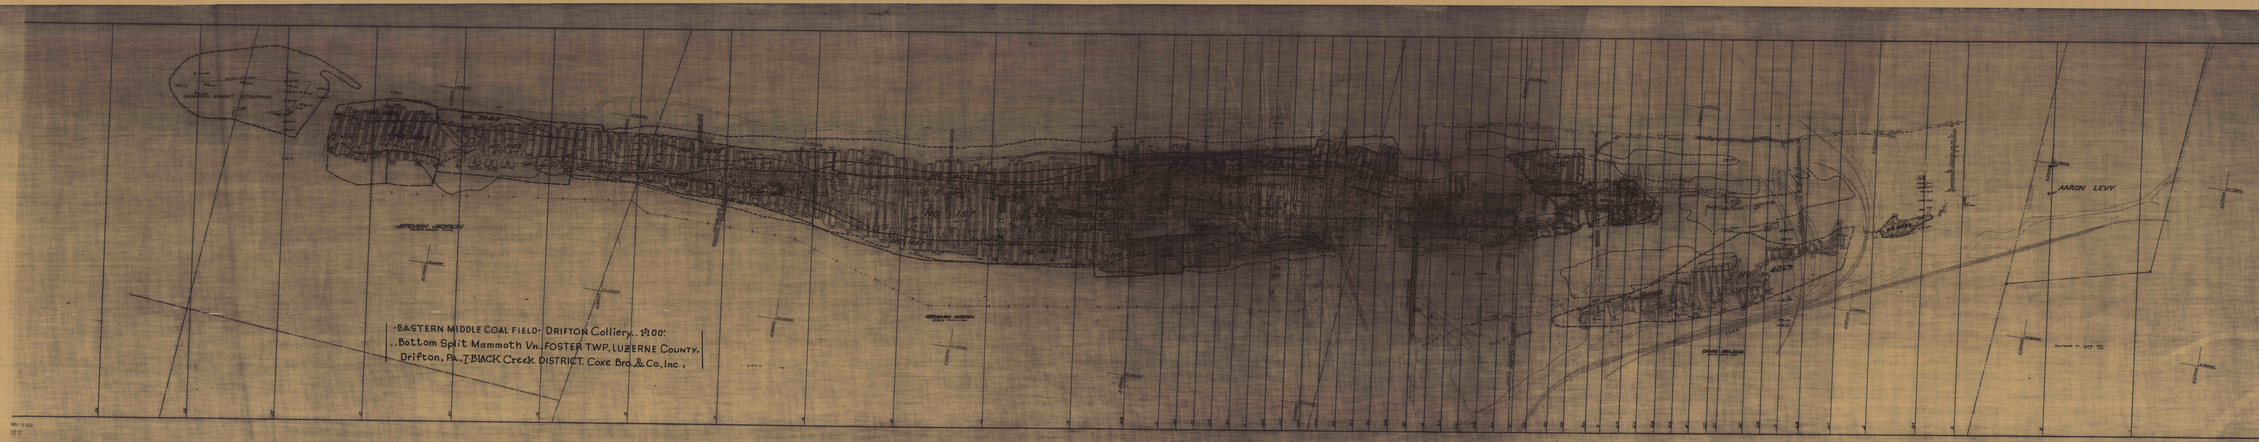

Eastern Middle Field
DRIFTON - BOTTOM SPLIT MAMMOTH VEIN 1:100
Coxe Bros. & Co. Inc.
-13-
M-4
-13-
M-4