


"LOOKING WEST."

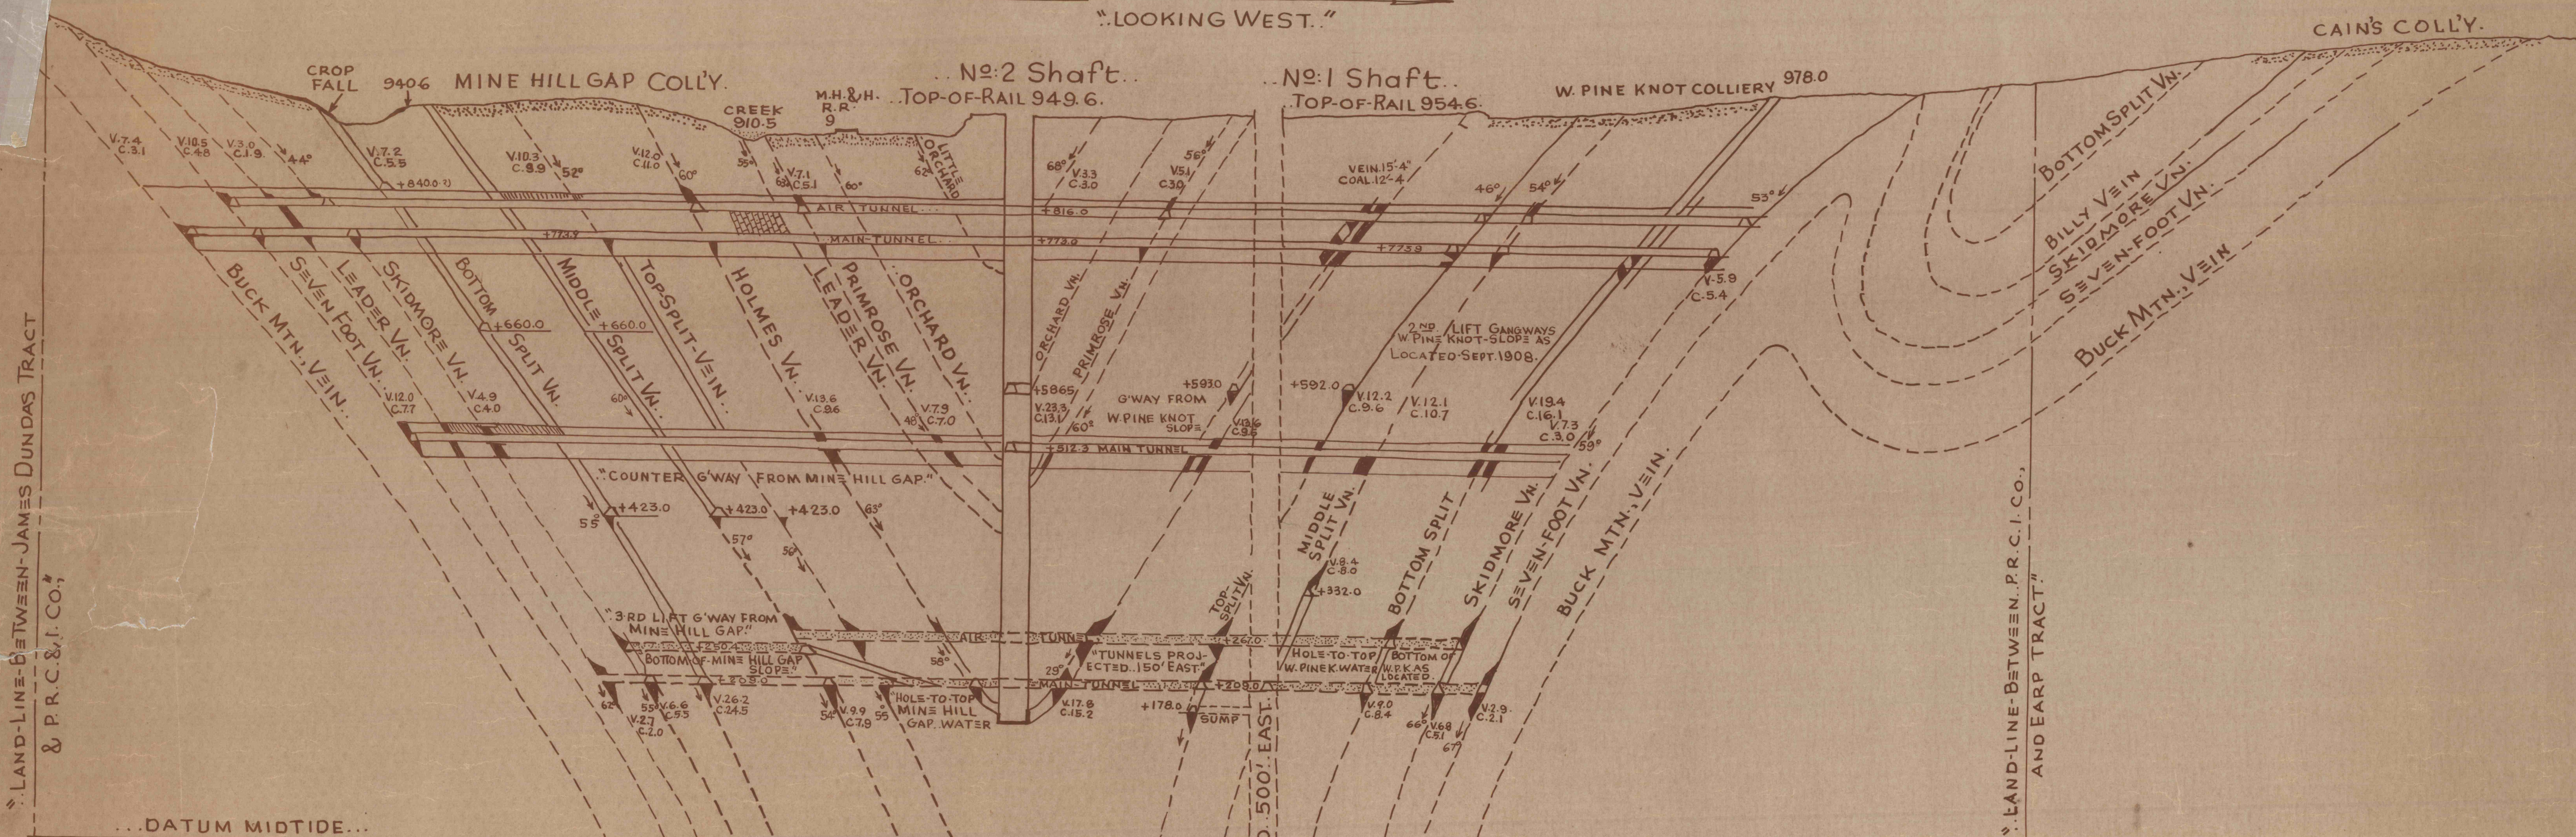

**SOUTHERN FIELD
PINE KNOT COLLIERY**

CASS Twp., SCHUYLKILL
COUNTY, 15 W. SCHUYLKILL

DISTRICT READING ANTHRACITE COLLIERIES.

CROSS SECTION THRU NO. 2 SHAFT. 1"=100'. POTTSVILLE, PA., 28 DEC., 1910.
RETRACED; 15 FEB., 1978. DEEP MINE SAFETY. REVISED: 7 JUNE 1912.

ALEXANDER DROZDA
RESOURCES MGMT
JAN. 9, 1979

E. F. WEIMER, DIVISION ENGINEER.