MAR-BERN COAL CO
MINE WORKING

SOUTHERN COAL FIELD...
SHERMAN COLLIERY...1"=100'
ALL VEINS, SCHUYLKILL COUNTY,
POTTSVILLE, PA.

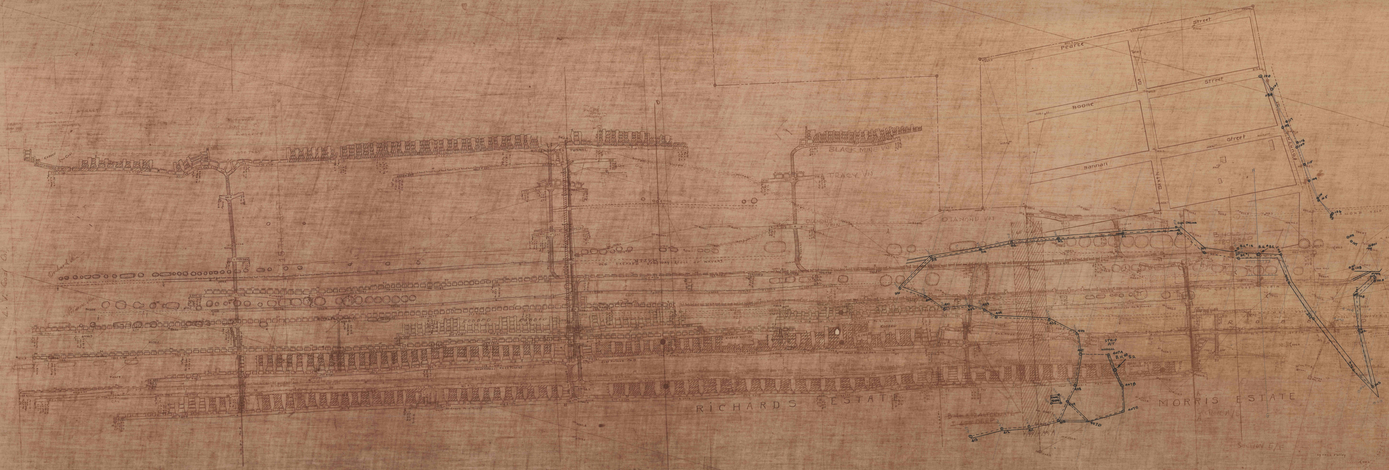

STATE MINE INSPECTOR'S
MAP OF
SHERMAN COAL CORPORATION
MINE WORKINGS PREPARED