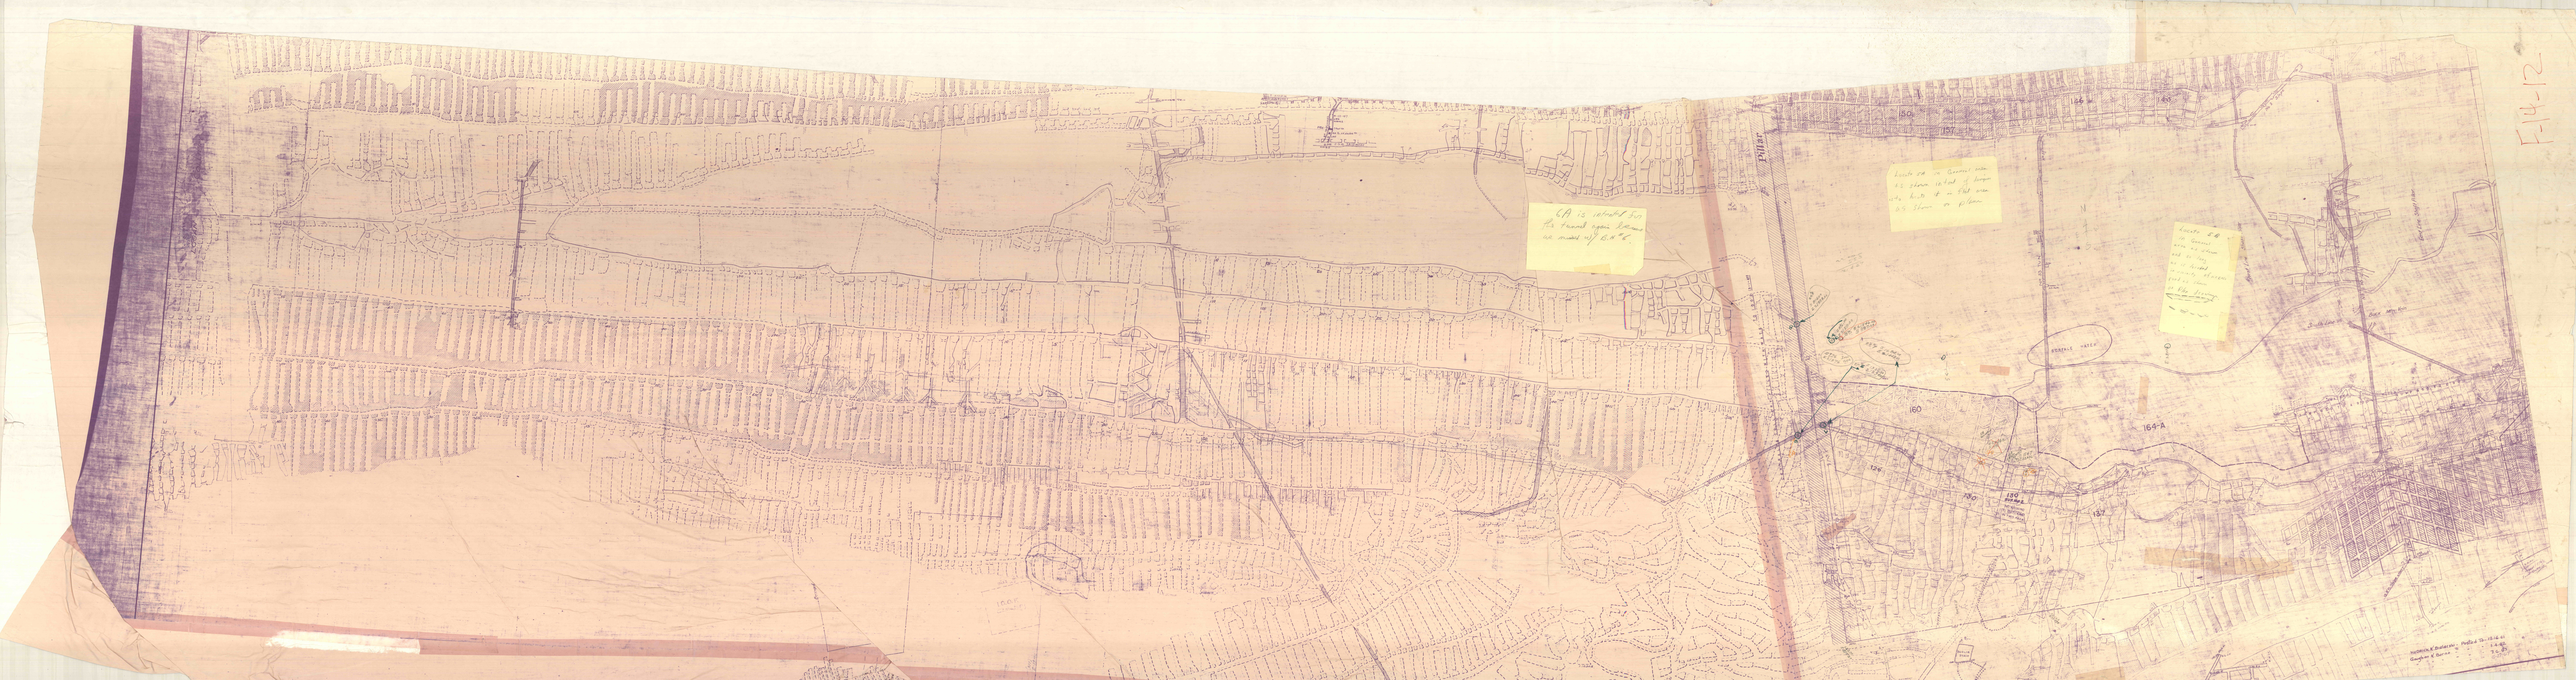
160
164-A
160
164-A