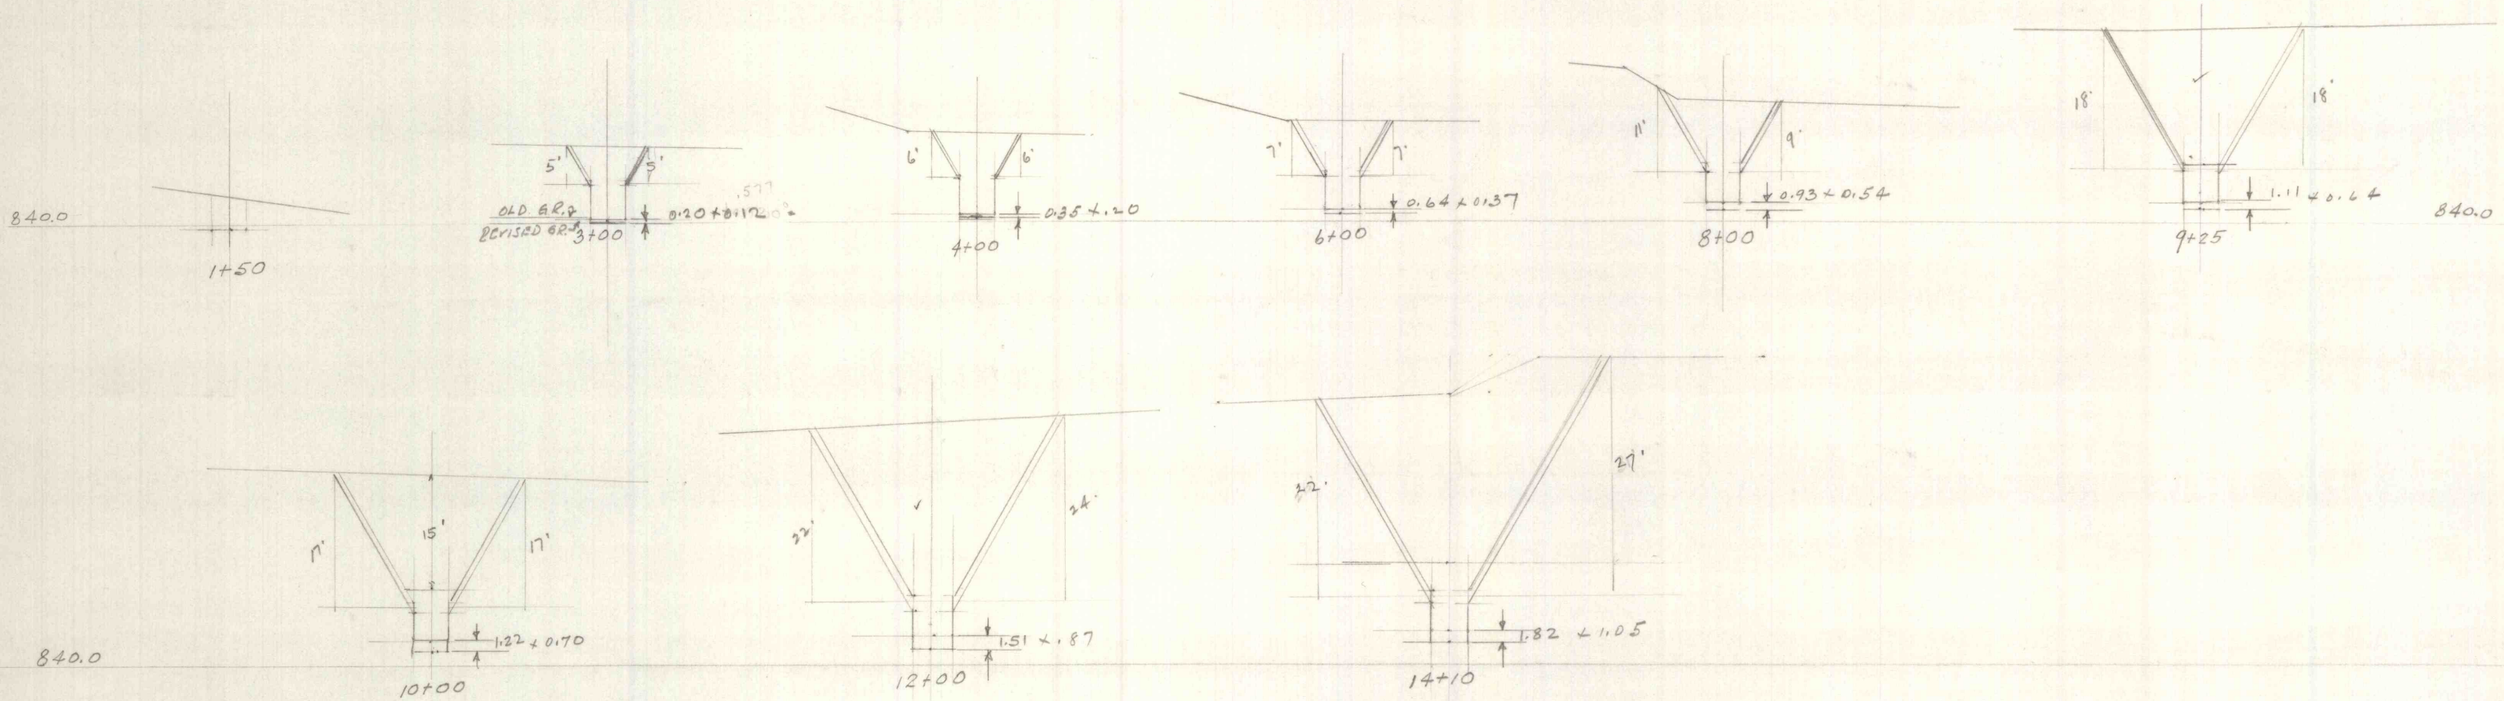

RANSHAW A-19-B
REVISED SECTIONS SHOWING
ADDITIONAL AREAS DUE TO
CHANGE IN GRADE
JUNE 1970 1" = 20'