


2600 FT

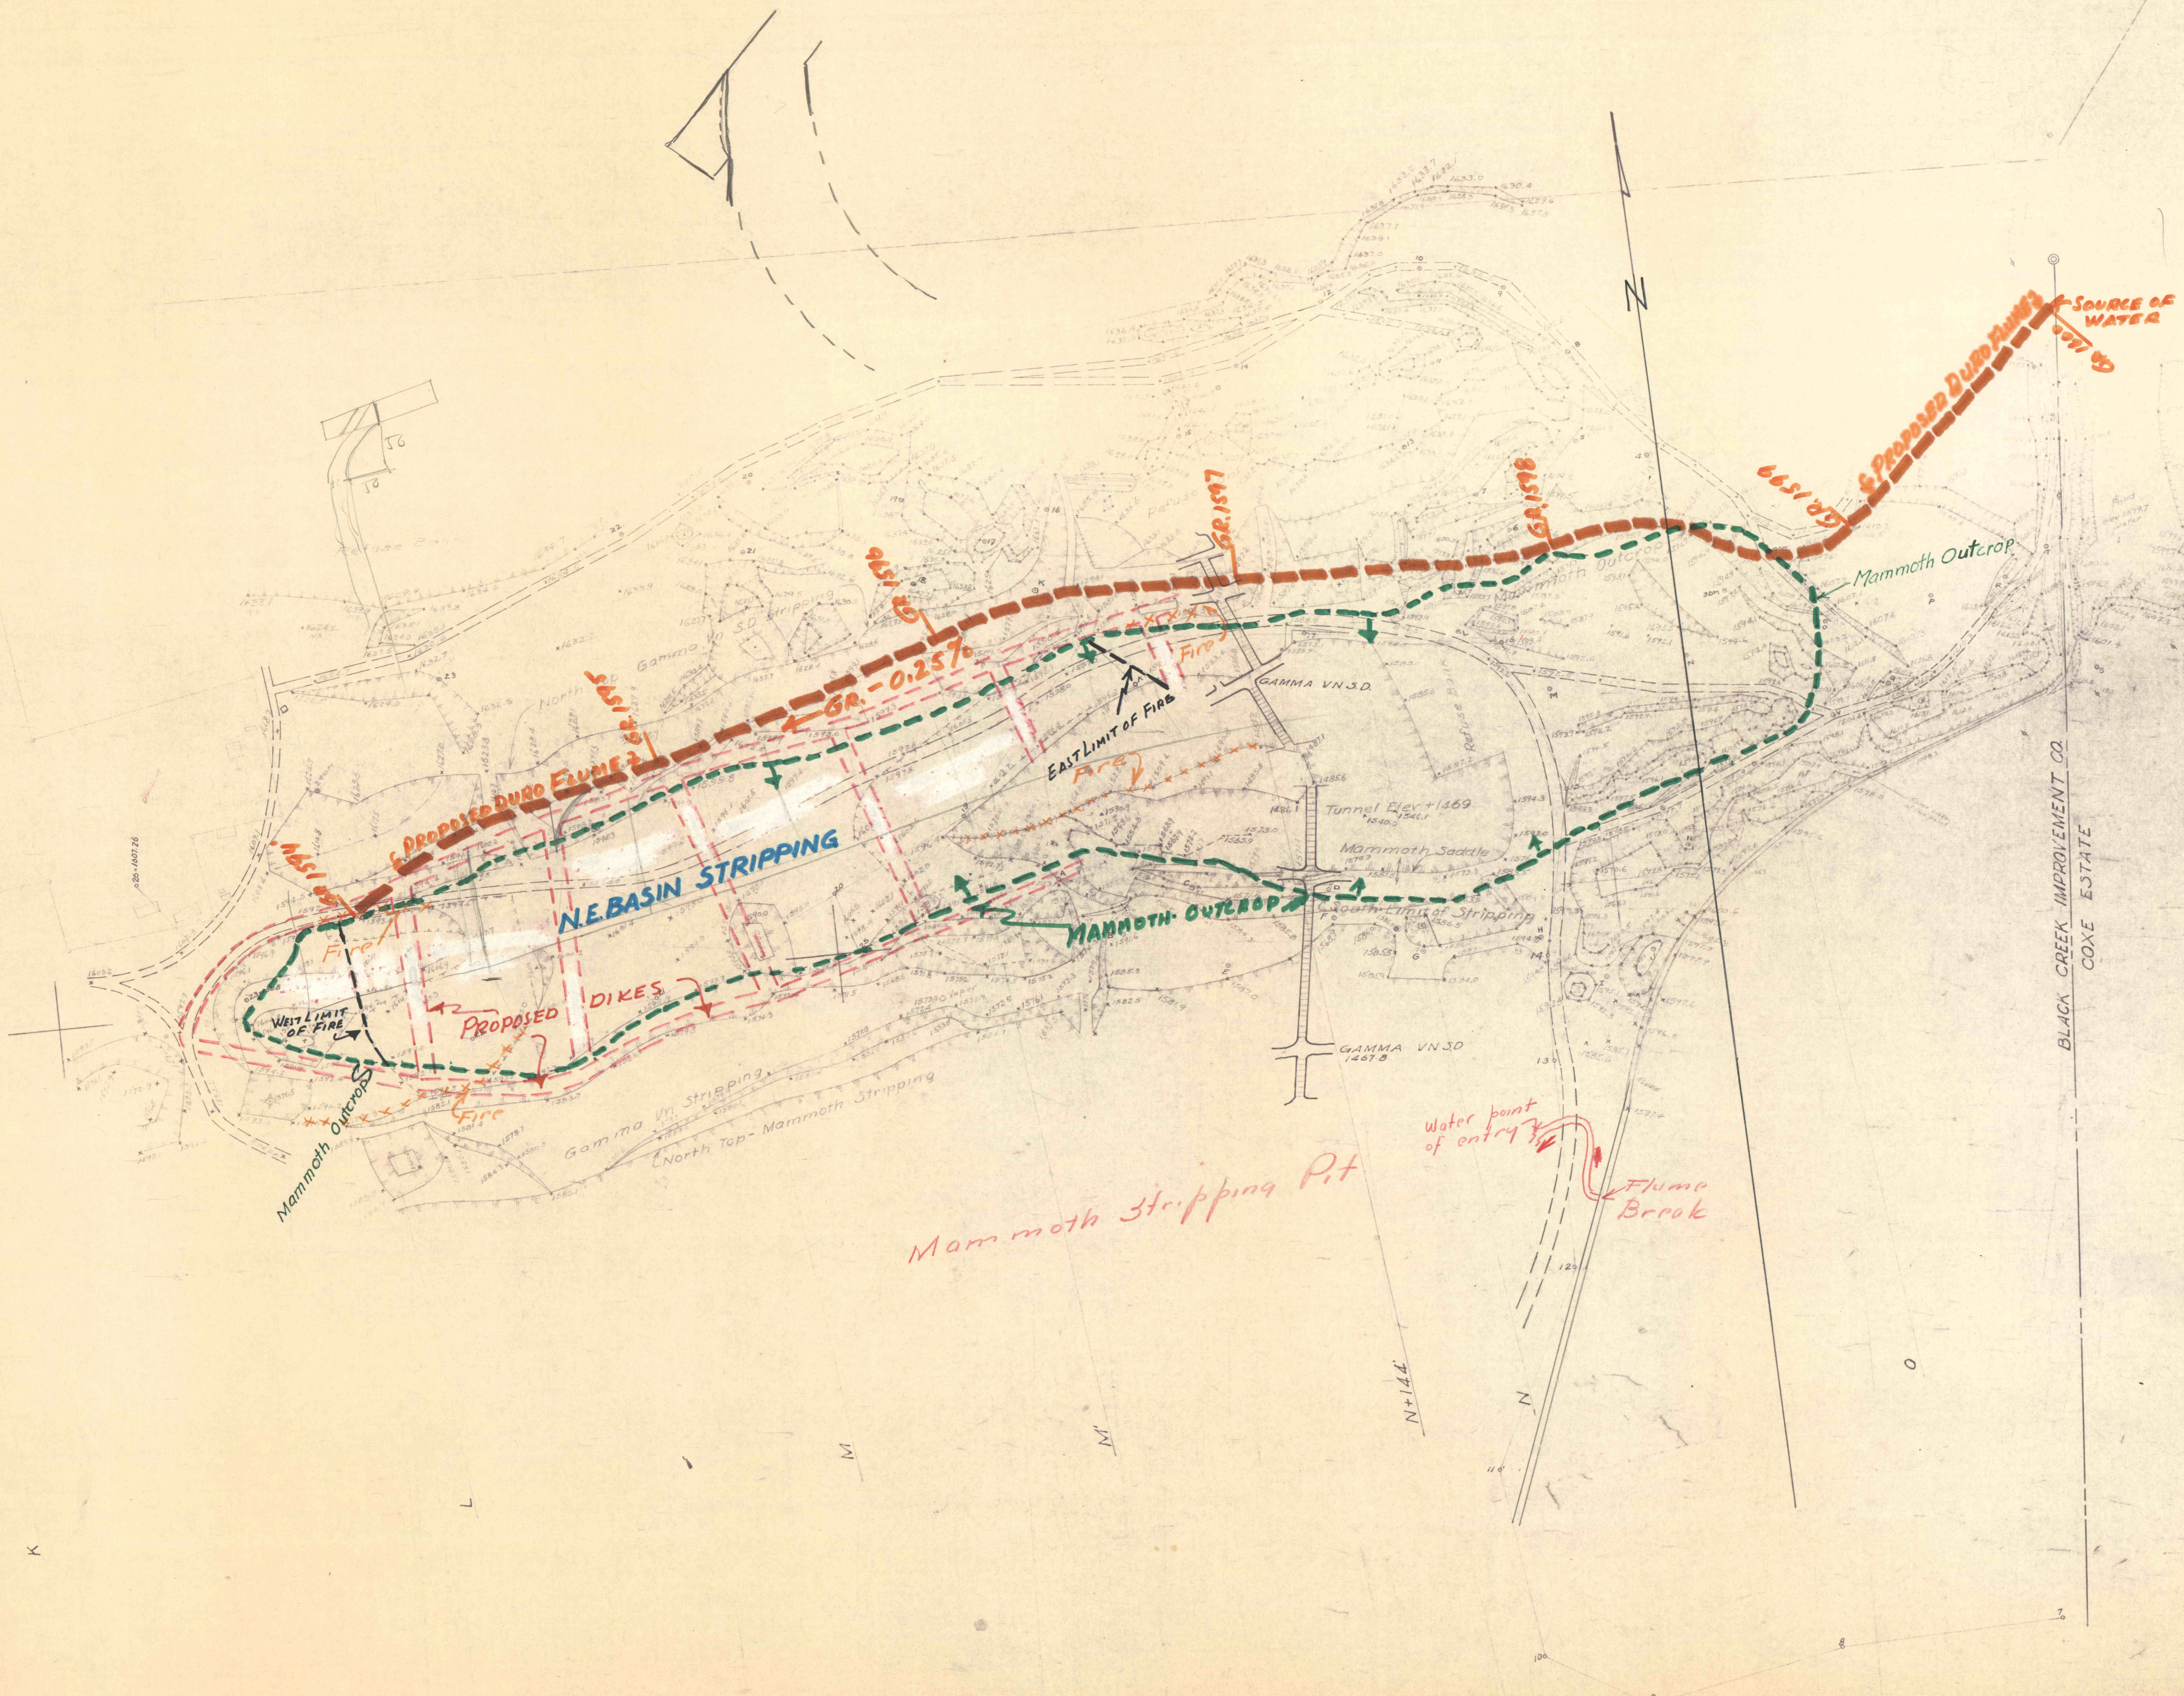

 GR. - 0.25%

N.E. BASIN STRIPPING

EAST LIMIT OF FIRE

PROPOSED DIKES

MAMMOTH OUTCROP

Mammoth Outcrop

BLACK CREEK IMPROVEMENT CO.
 COXE ESTATE

Mammoth Stripping Pit

Water point of entry
 Flume Break

SOURCE OF WATER

GAMMA VN 30

Tunnel Elev +1469

Mammoth Saddle

South Limit of Stripping

GAMMA VN 30

N+144

Mammoth Outcrop

Gamma Vn Stripping

North Top - Mammoth Stripping

K

L

M

M'

N

N

100

8

3