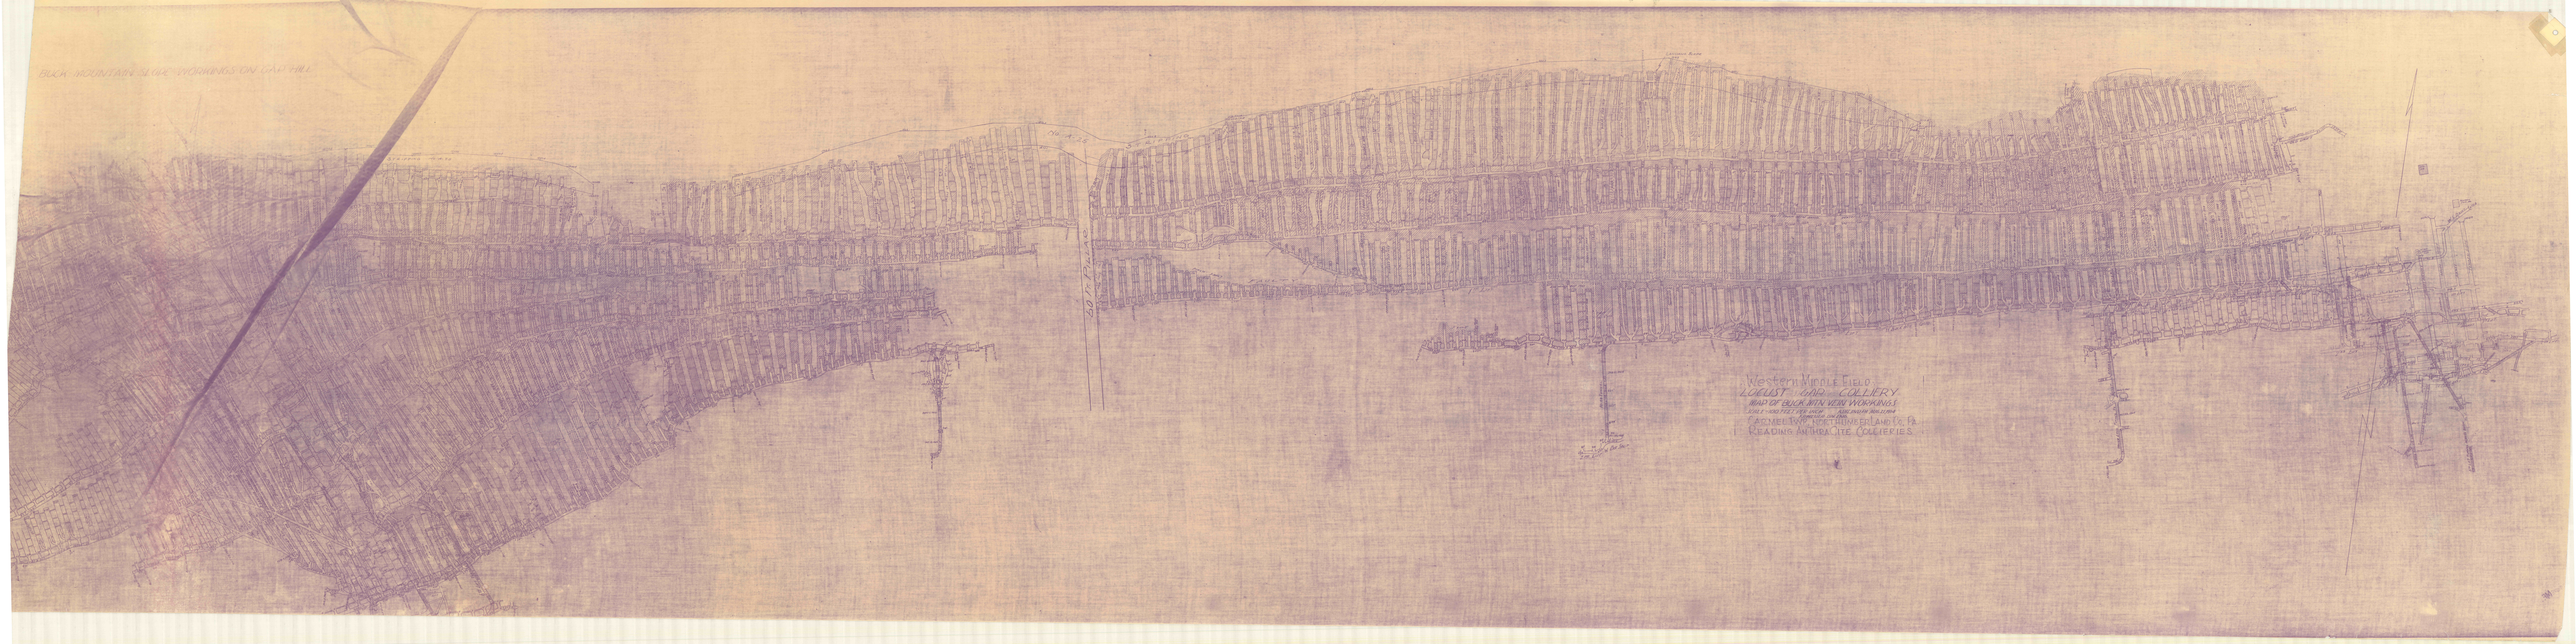
BUCK MOUNTAIN SLOPE WORKINGS ON OAK HILL
Western Middle Field
LOCUST GAP COLLIERY
MAP OF BUCK MTN. VEIN WORKINGS
SCALE 400 FEET PER INCH
READING ANTHRACITE COLLIERIES