

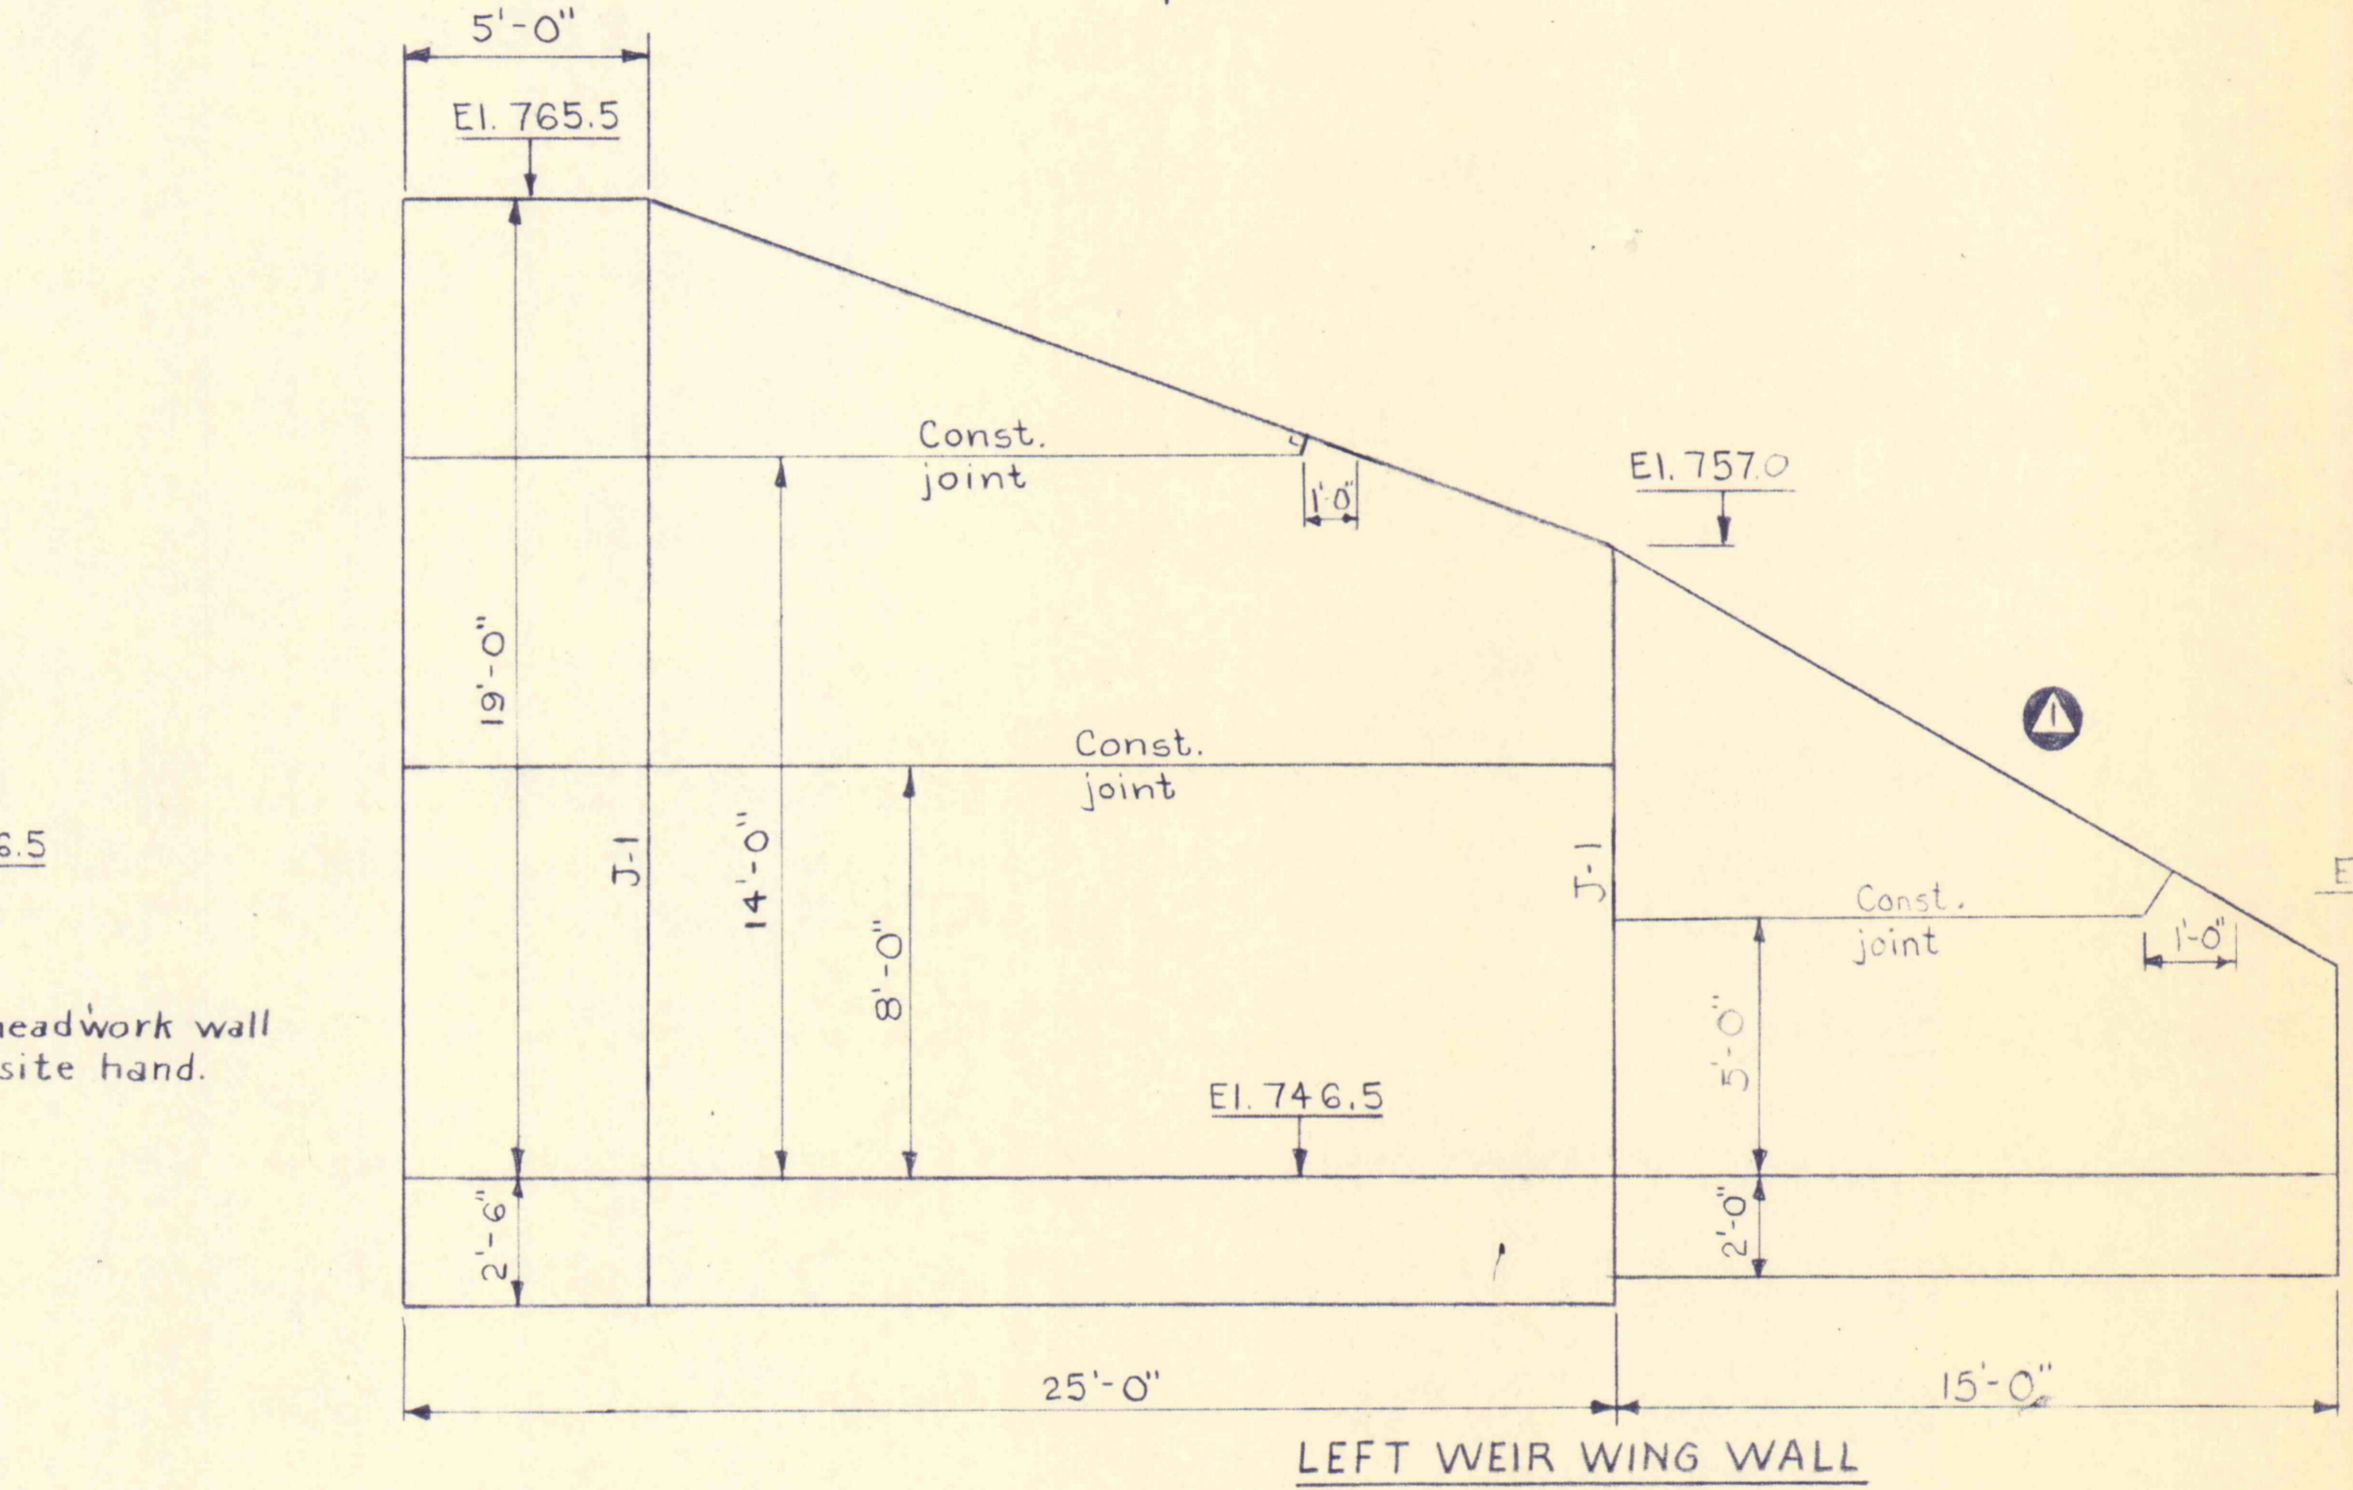
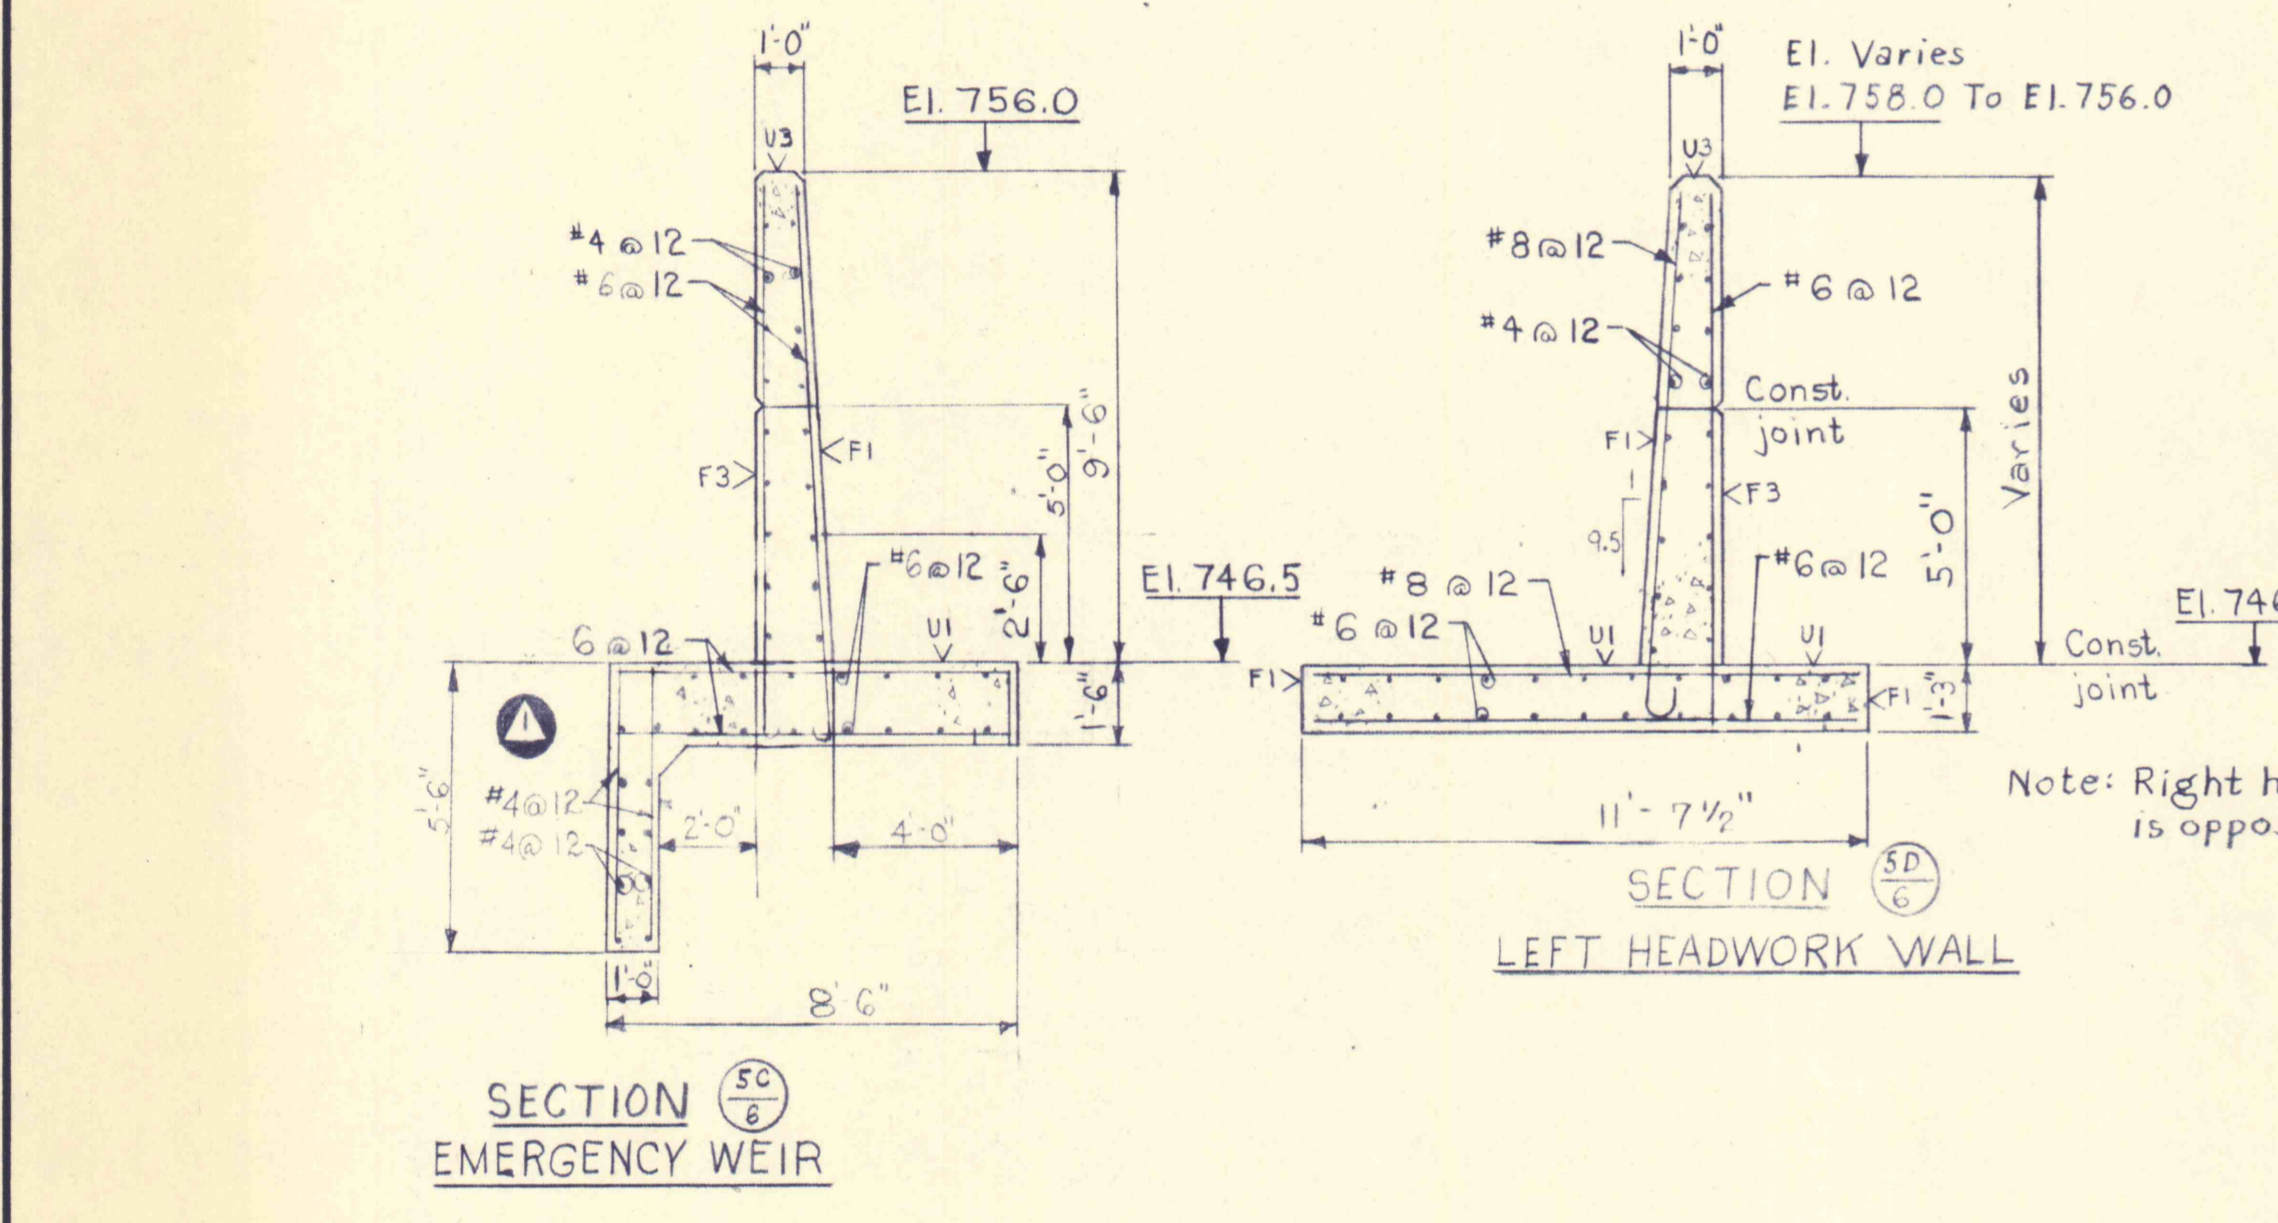
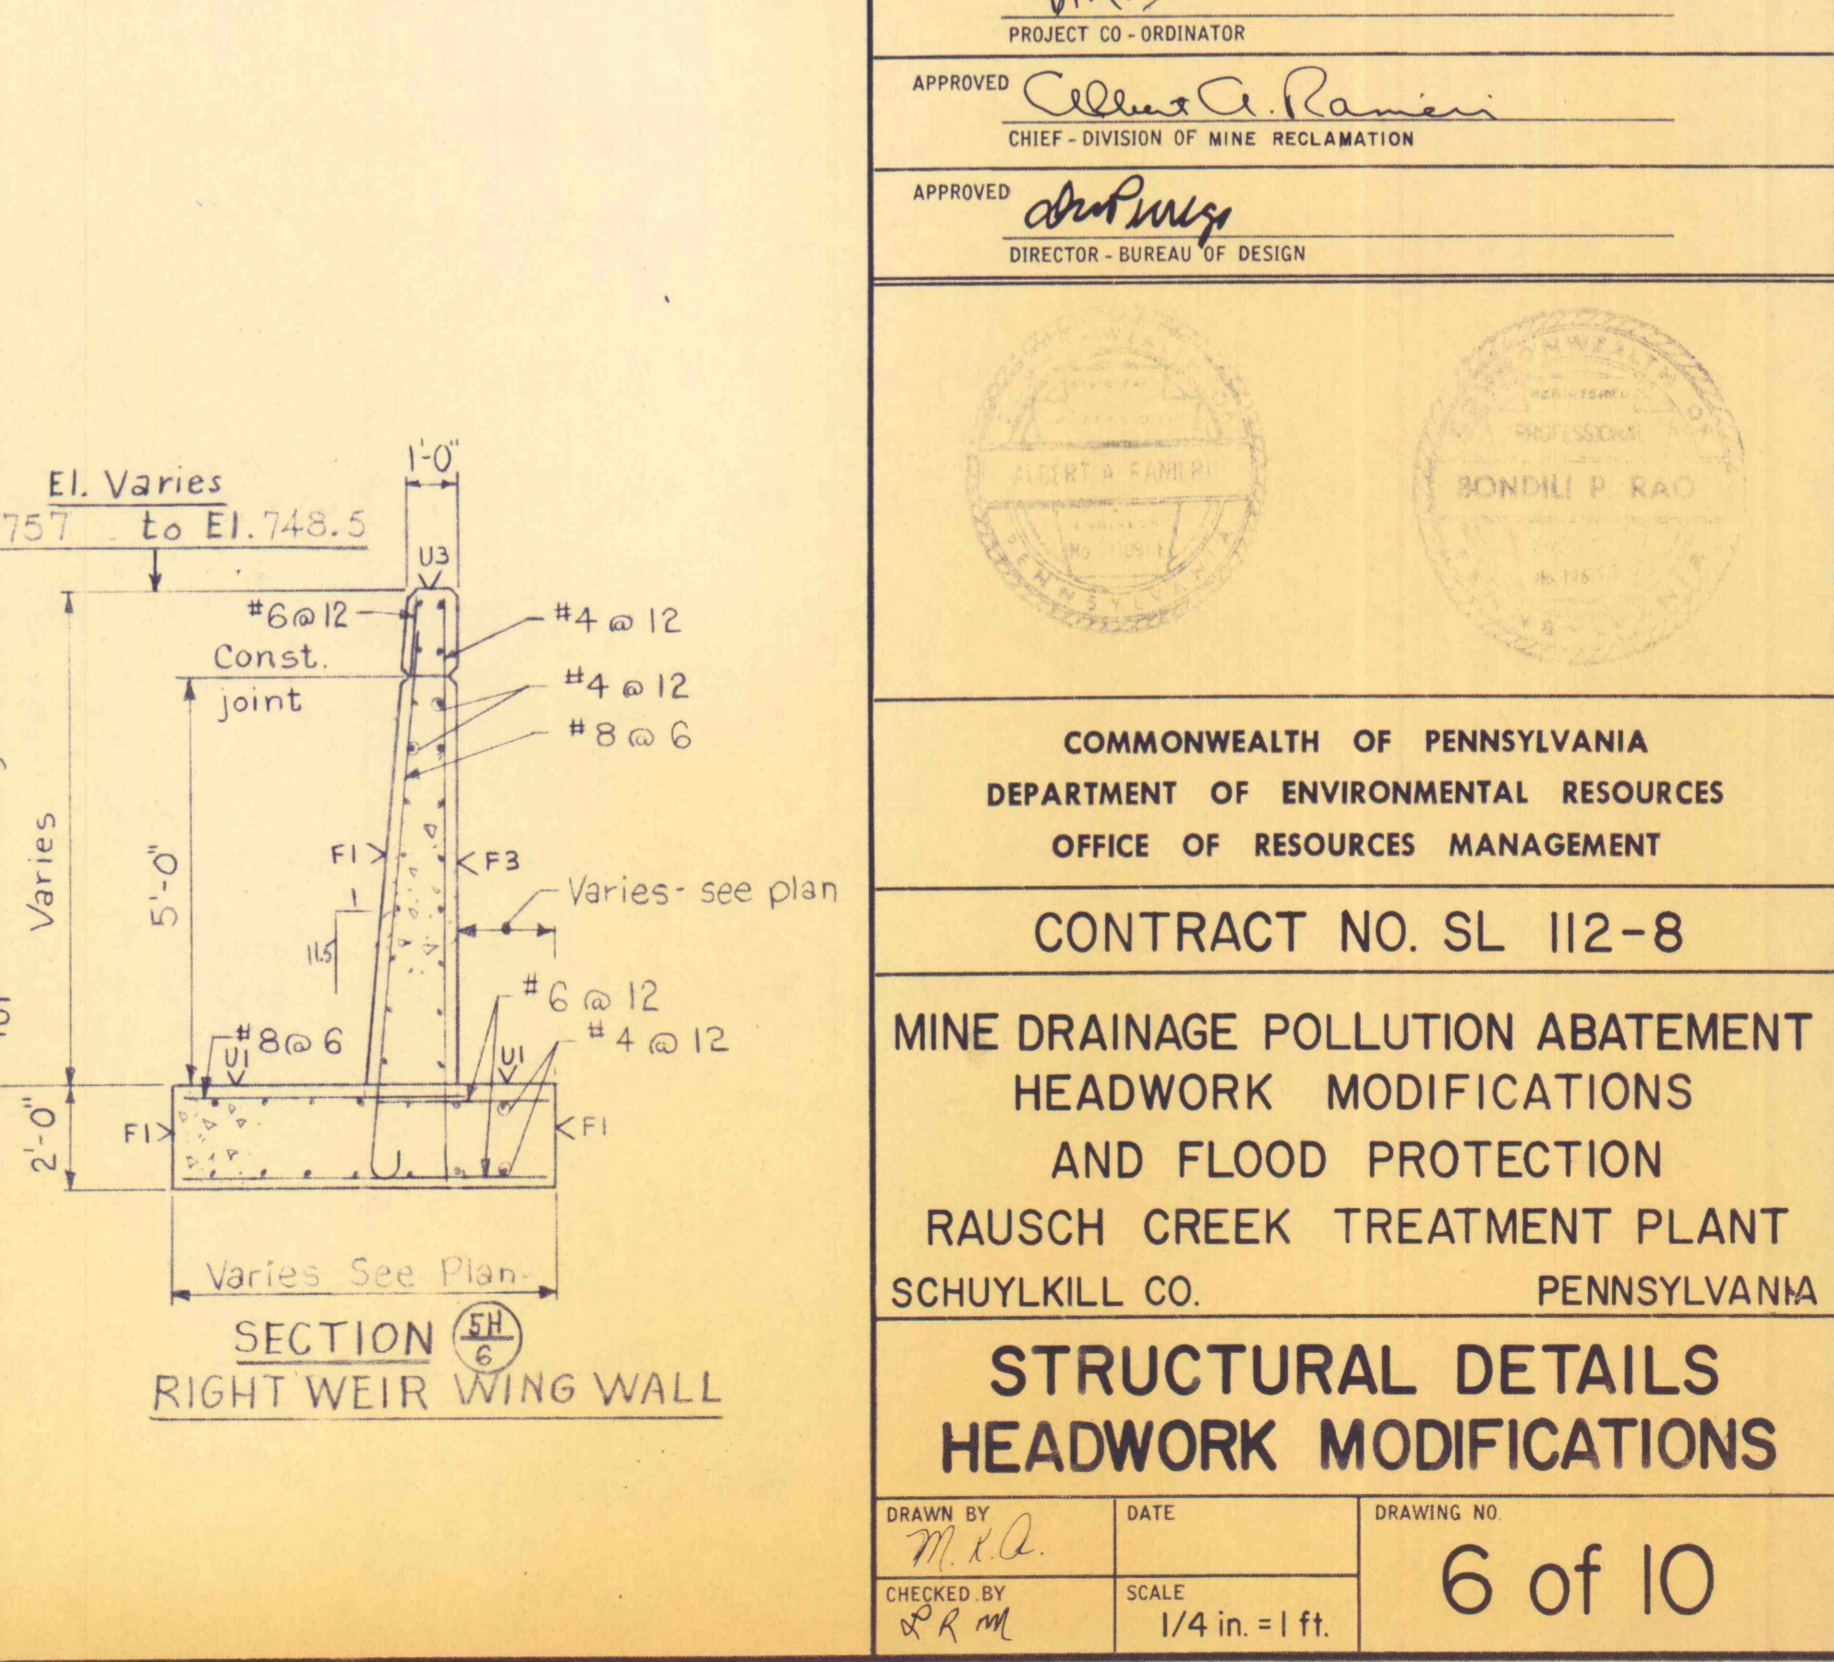


- CONCRETE NOTES:**
1. Chamfer all exposed edges, horizontal and vertical joints in walls 3/4" unless otherwise noted.
 2. All steel reinforcement is 2" clear (Edge of steel to surface of concrete) unless otherwise noted.
 3. Reinforcement steel shall be paid for under pay item (12).
 4. <No Denotes concrete finish. See standard specifications.
 5. Located weep holes as directed where none are indicated on the drawings.
 6. J1 (Contraction joint); J2 (Expansion joint)
- REFERENCES:**
1. For Plan and General Notes, see Dwg. No. 3.
 2. For Profiles, see Dwg. No. 4.
 3. For Cross sections, see Dwg. No. 7.

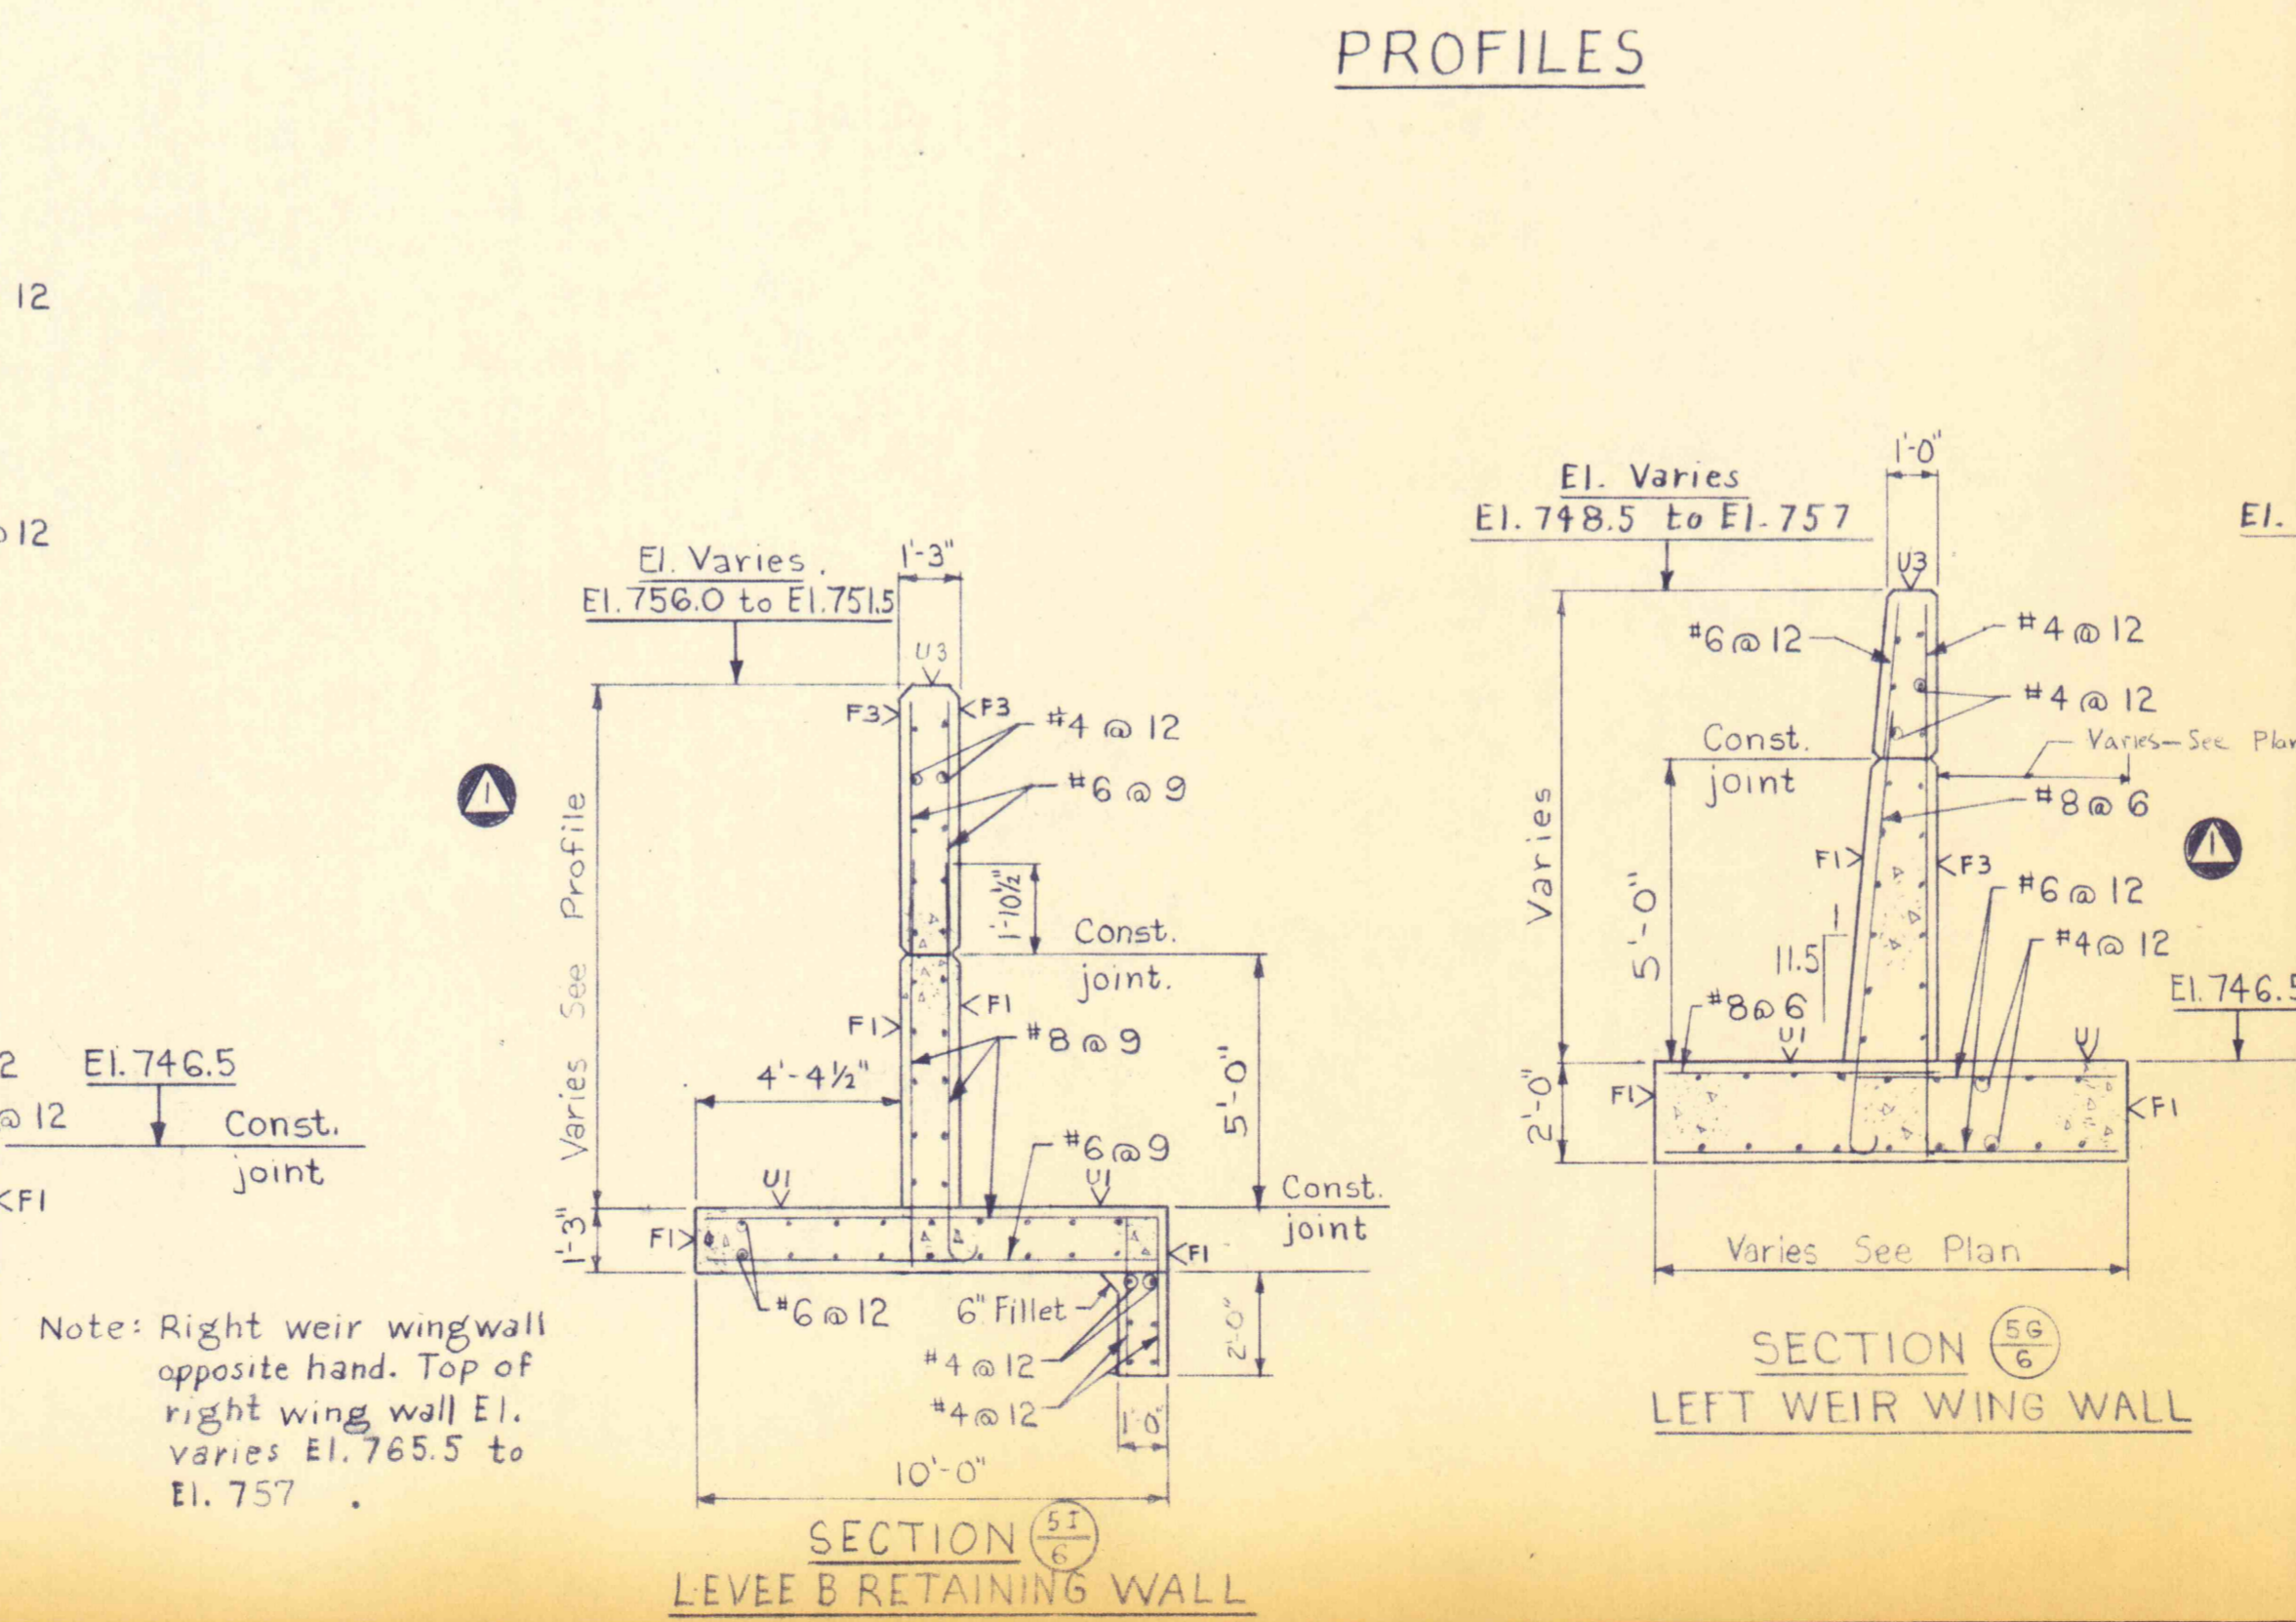

PROFILES

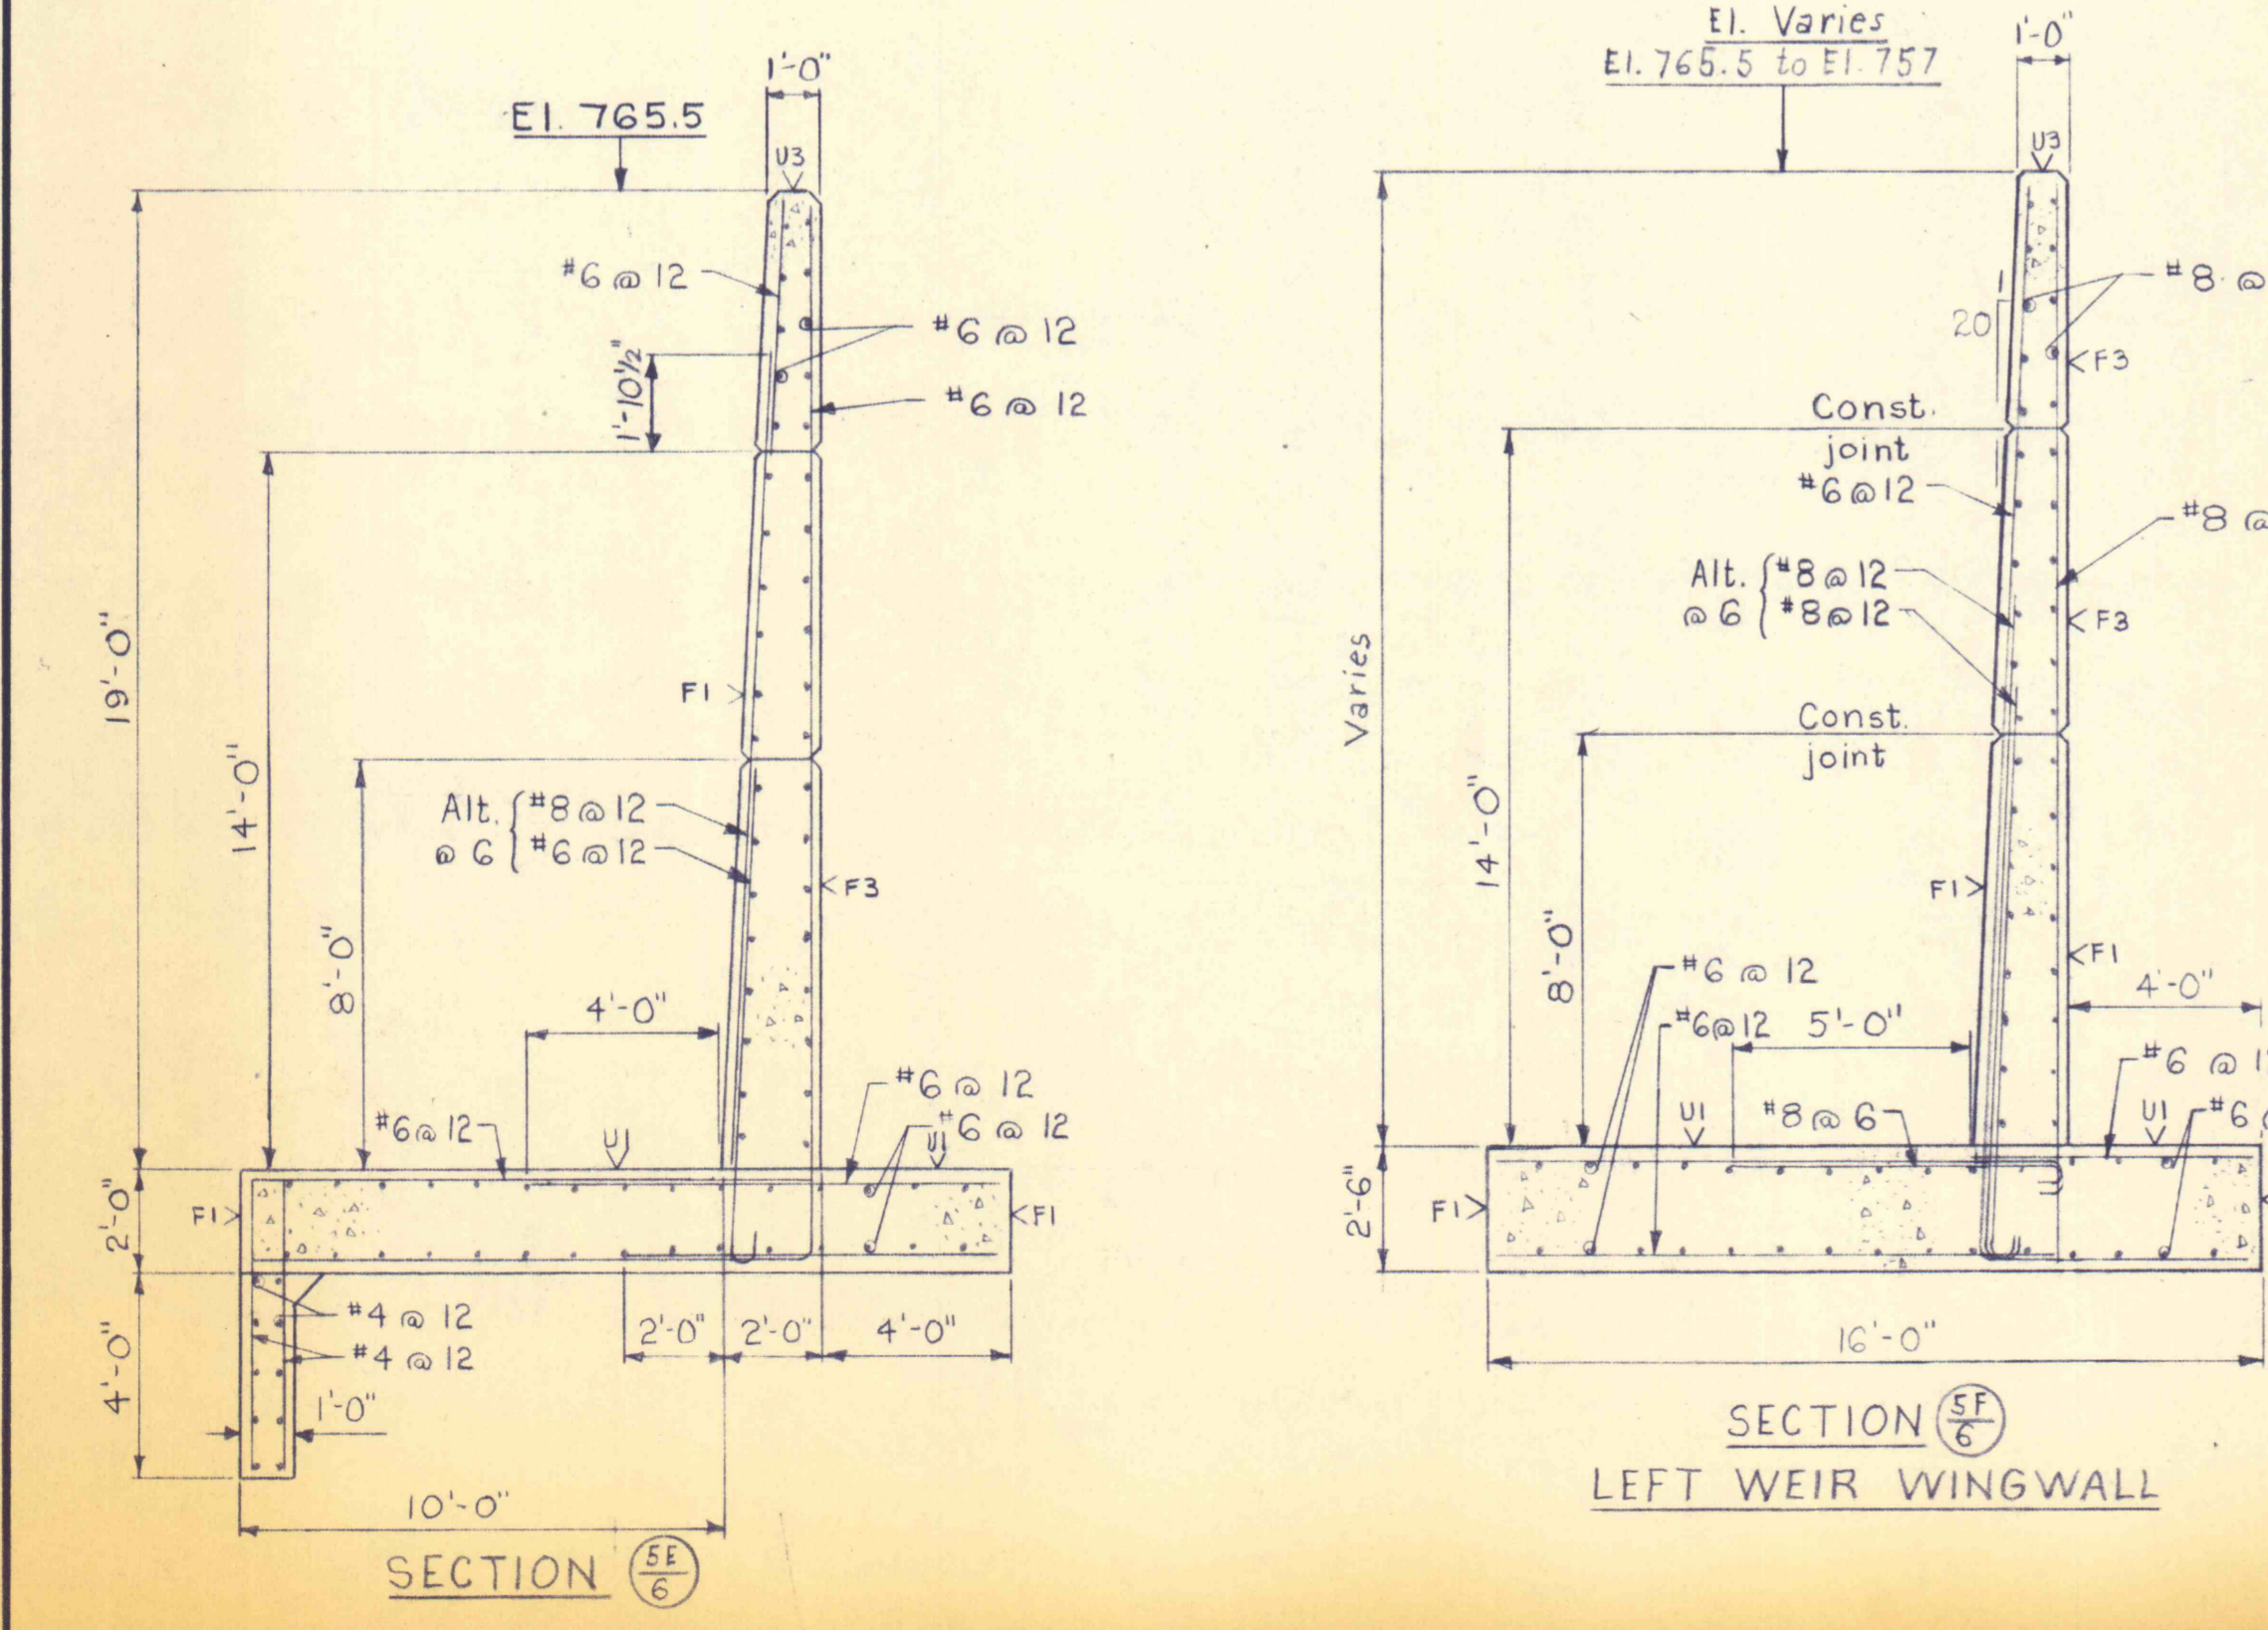

5-30-78	Miscellaneous details, revised left and right weir walls, deleted emergency weir apron.	
NO.	DATE	REVISION
SUBMITTED <i>[Signature]</i>		APPR.
PROJECT CO-ORDINATOR		
APPROVED <i>[Signature]</i>		
CHIEF - DIVISION OF MINE RECLAMATION		
APPROVED <i>[Signature]</i>		
DIRECTOR - BUREAU OF DESIGN		
COMMONWEALTH OF PENNSYLVANIA DEPARTMENT OF ENVIRONMENTAL RESOURCES OFFICE OF RESOURCES MANAGEMENT		
CONTRACT NO. SL 112-8		
MINE DRAINAGE POLLUTION ABATEMENT HEADWORK MODIFICATIONS AND FLOOD PROTECTION RAUSCH CREEK TREATMENT PLANT SCHUYLKILL CO. PENNSYLVANIA		
STRUCTURAL DETAILS HEADWORK MODIFICATIONS		
DRAWN BY <i>[Signature]</i>	DATE	DRAWING NO.
CHECKED BY <i>[Signature]</i>	SCALE 1/4 in. = 1 ft.	6 of 10