


NOTE:
1. Where existing ground elevation is 1'-0" above, equal to, or lower than top of grouted riprap, no gravel drain or weep holes required.
2. Right Wing Wall - opposite hand.

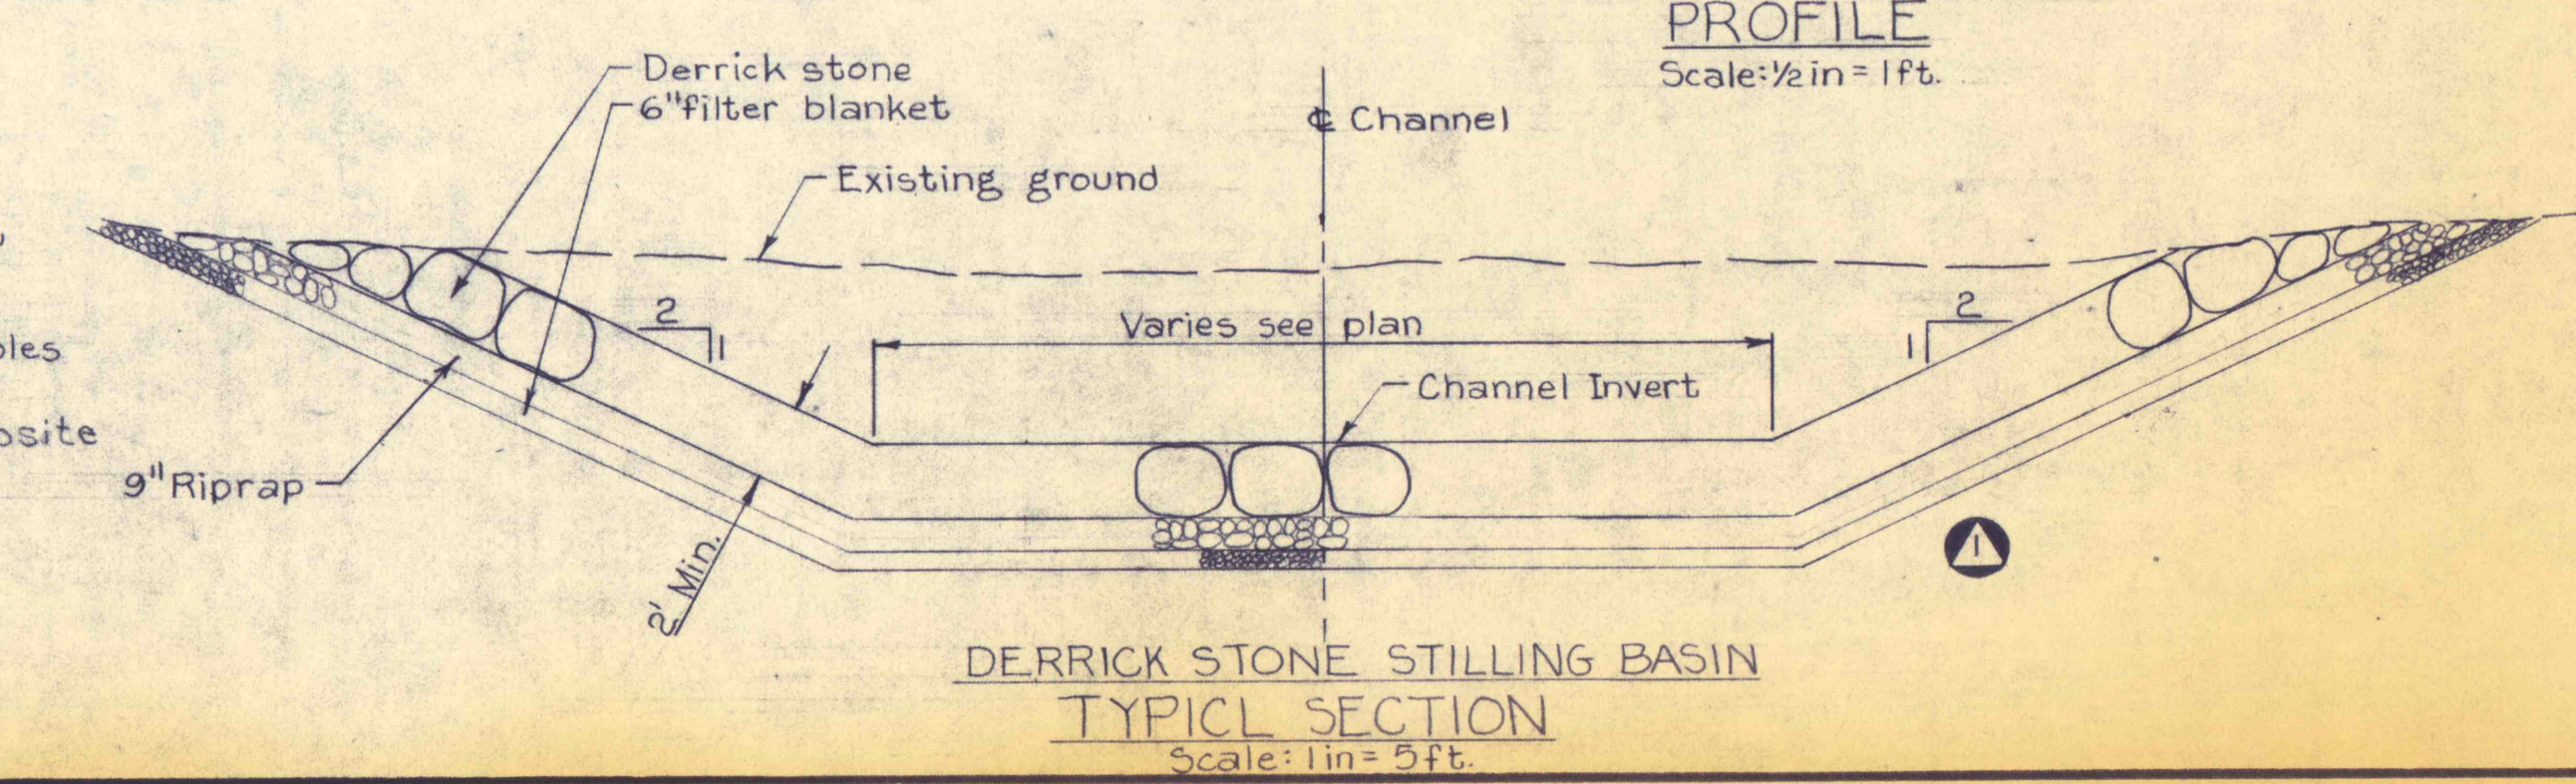

REFERENCES:
1. For Plan and General notes, see Dwg. No. 3
2. For Profiles, see Dwg. No. 4

NO.	DATE	REVISION	APPR.
5-30-75		Revise derrick stone stilling basin, typical detail, Add waterstop detail	HTZ
SUBMITTED: <i>HR</i>			
PROJECT CO-ORDINATOR			
APPROVED: <i>Albert A. Raneri</i>			
CHIEF - DIVISION OF MINE RECLAMATION			
APPROVED: <i>Albert A. Raneri</i>			
DIRECTOR - BUREAU OF DESIGN			
COMMONWEALTH OF PENNSYLVANIA DEPARTMENT OF ENVIRONMENTAL RESOURCES OFFICE OF RESOURCES MANAGEMENT			
CONTRACT NO. SL 112-8 MINE DRAINAGE POLLUTION ABATEMENT HEADWORK MODIFICATIONS AND FLOOD PROTECTION RAUSCH CREEK TREATMENT PLANT SCHUYLKILL CO. PENNSYLVANIA			
HEADWORK MODIFICATIONS CROSS-SECTIONS			
DRAWN BY: <i>S. E. H.</i>	DATE: 5-19-75	DRAWING NO. 7 of 10	
CHECKED BY: <i>P. M.</i>	SCALE: As Shown		