

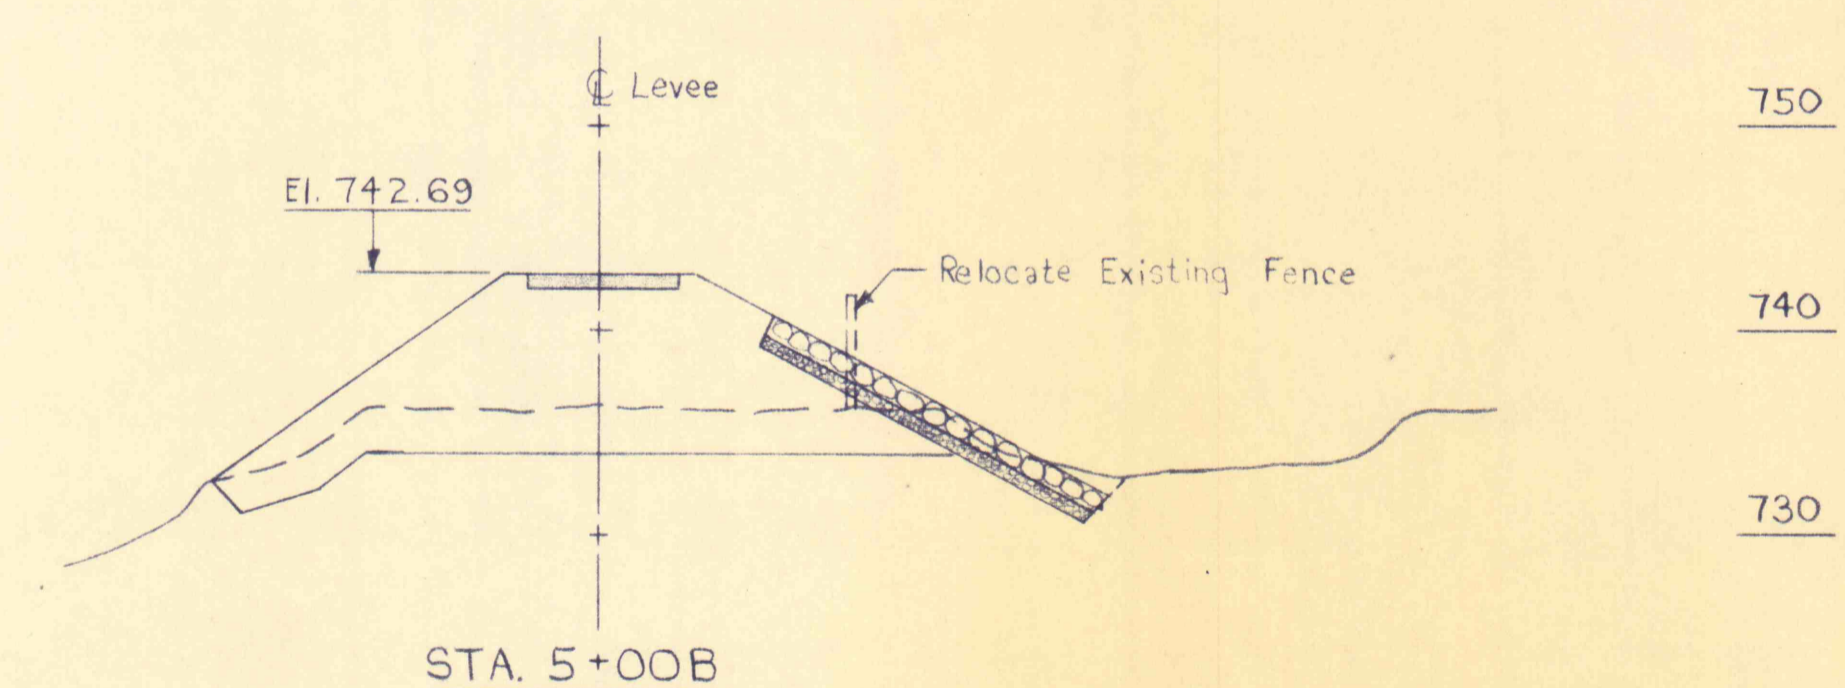
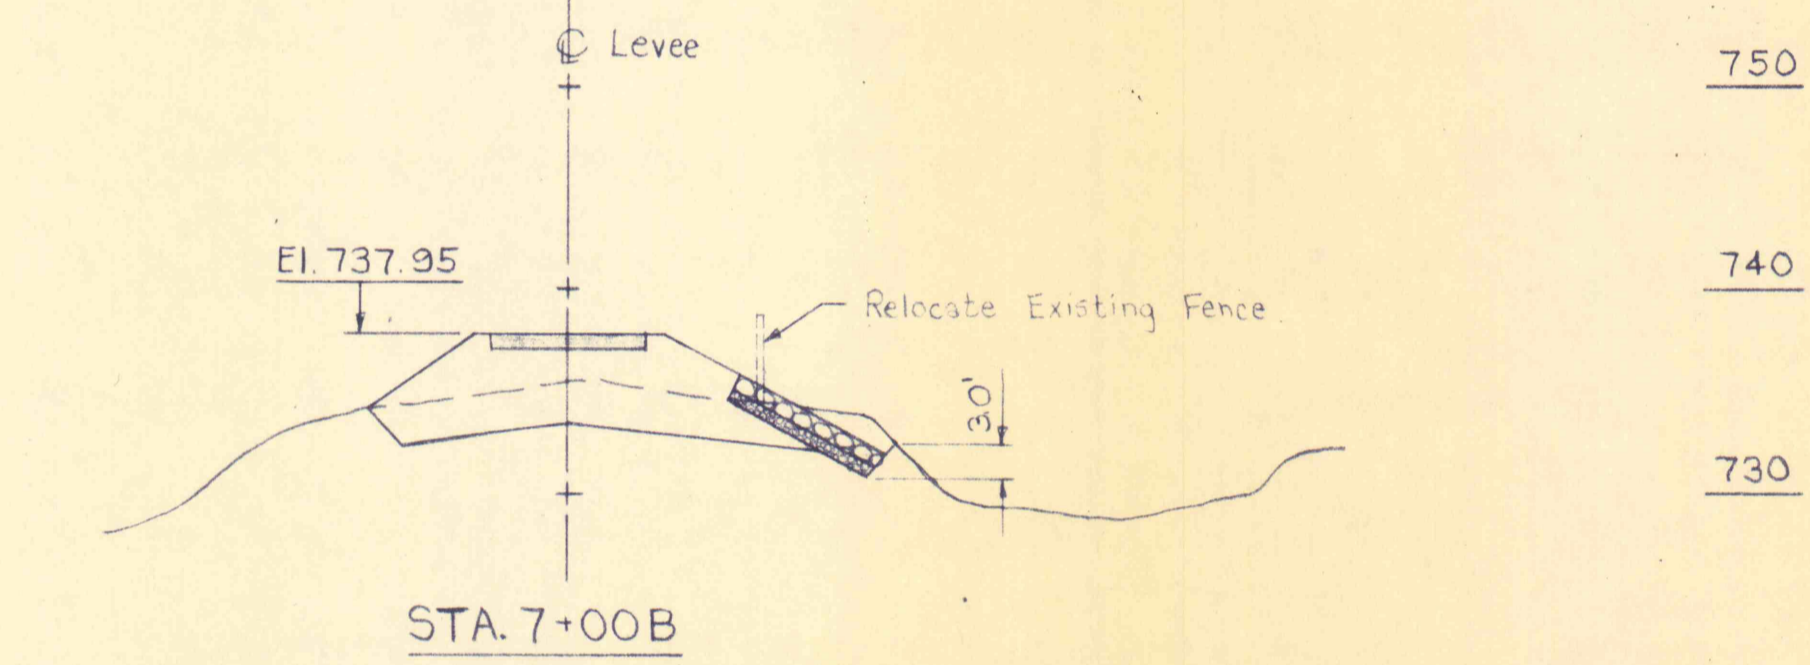
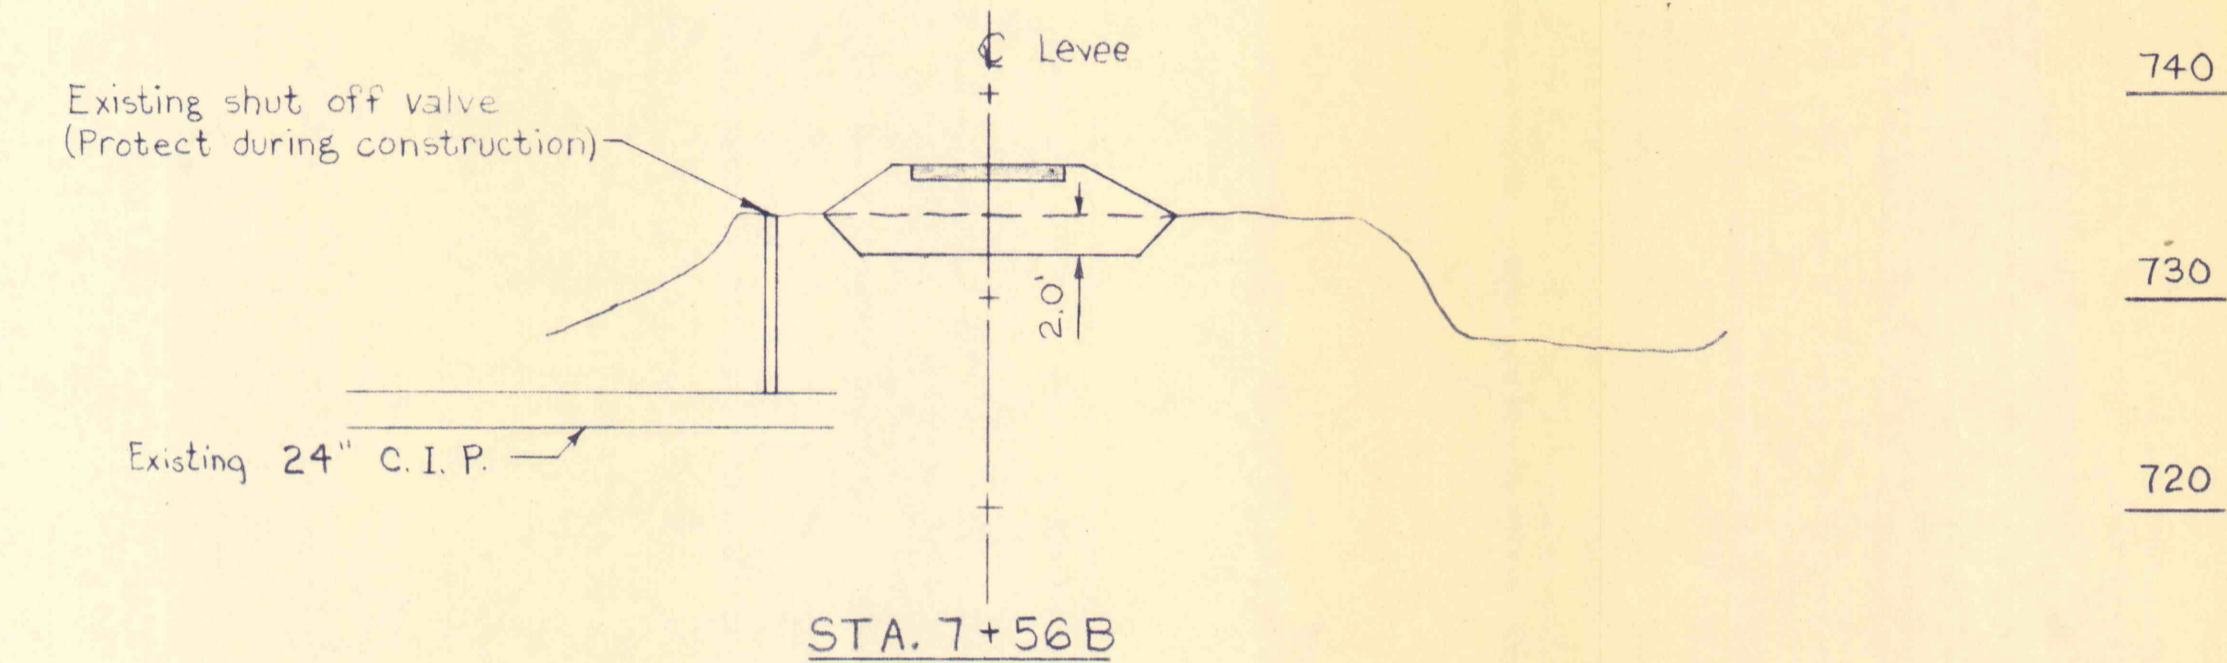
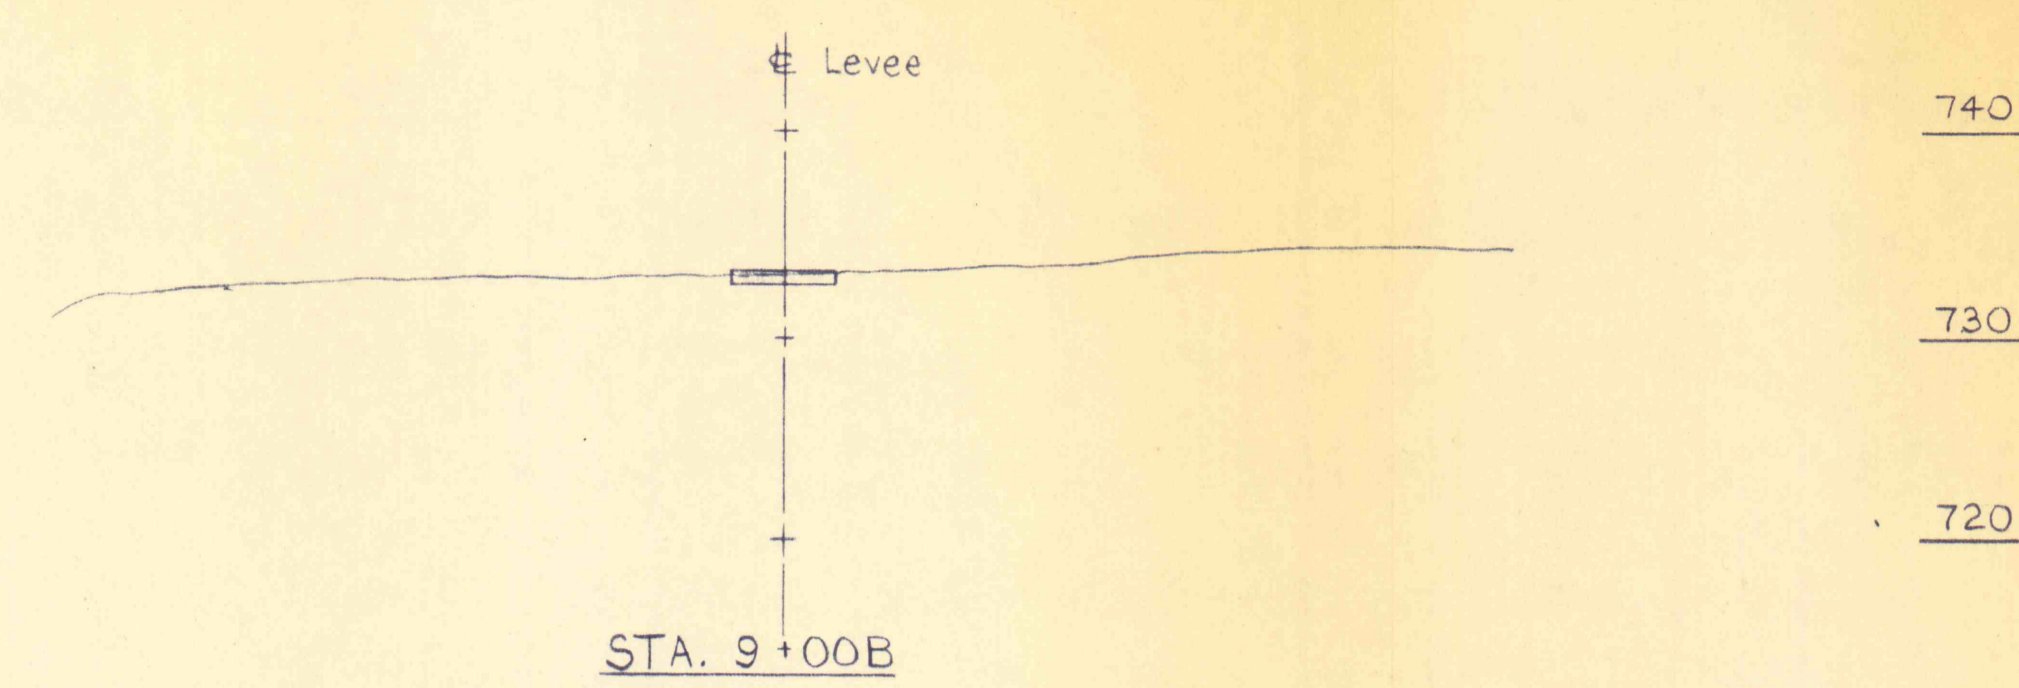
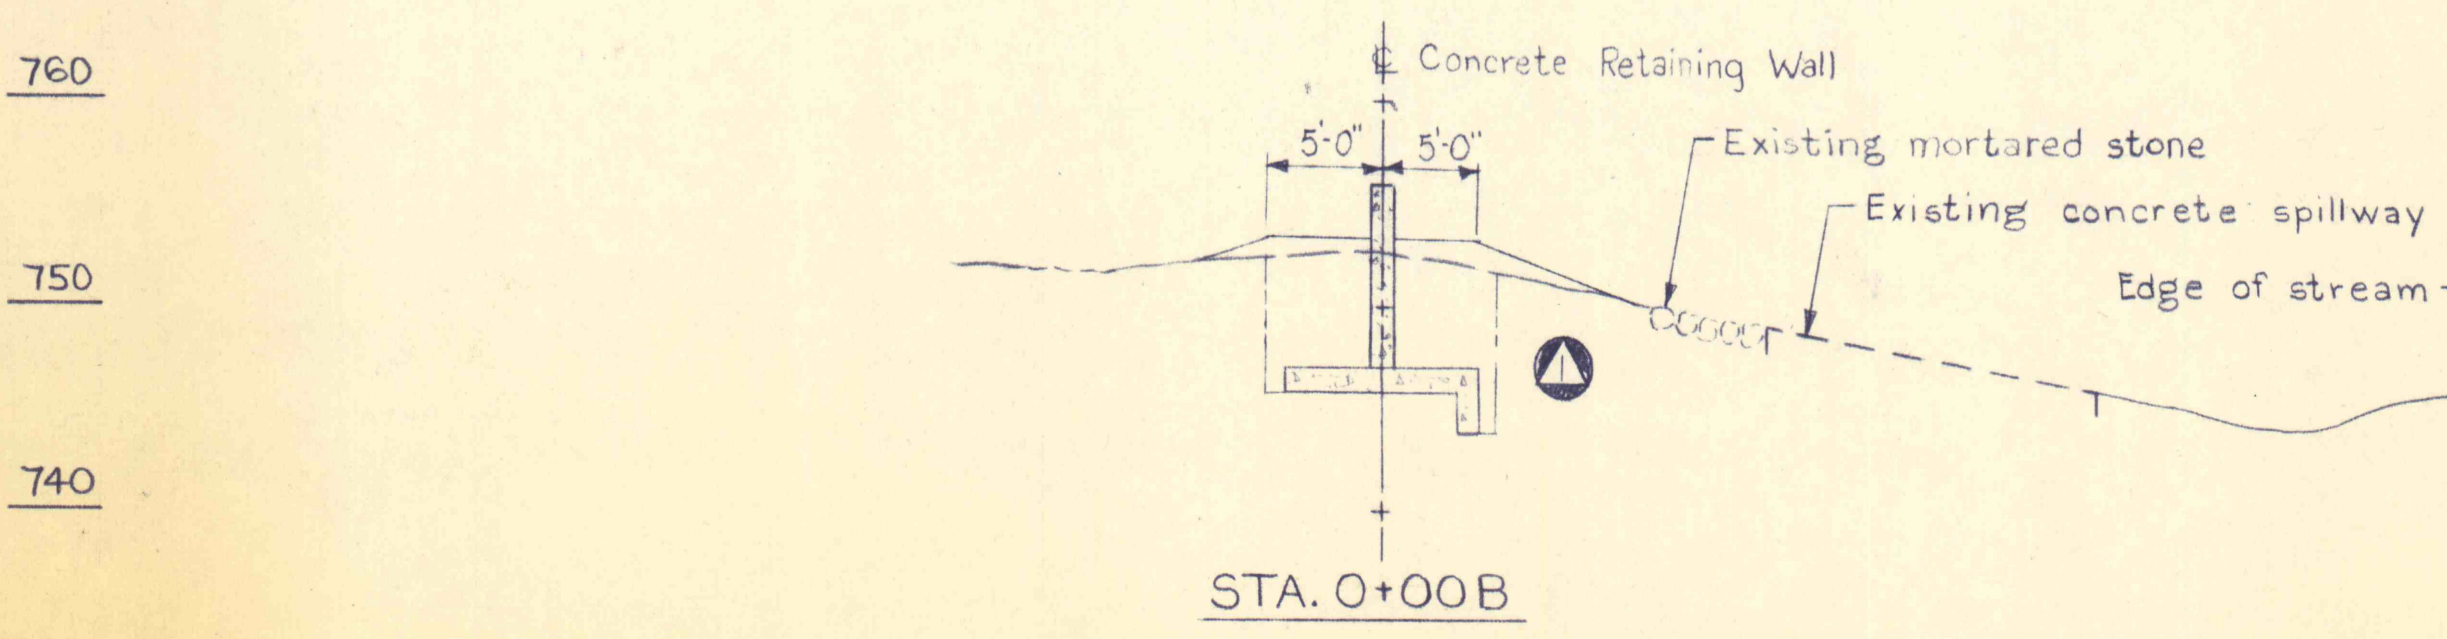


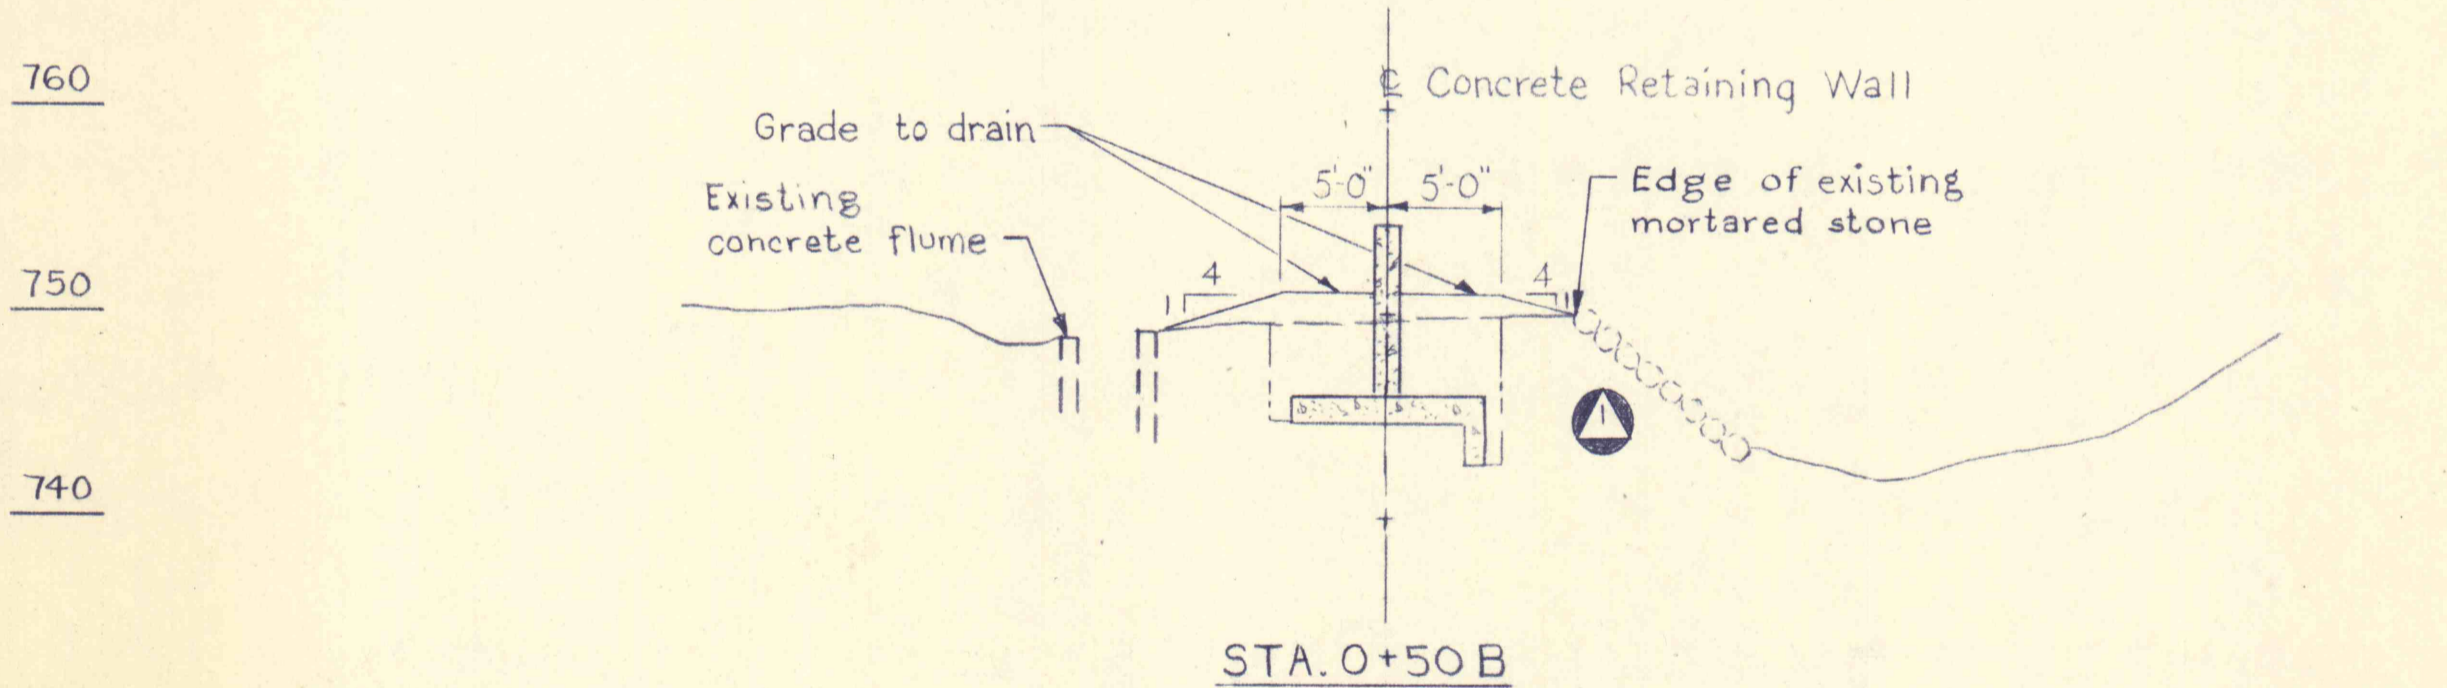

NOTE: End concrete retaining wall at Sta. 1+12.
Start levee at Sta. 1+07

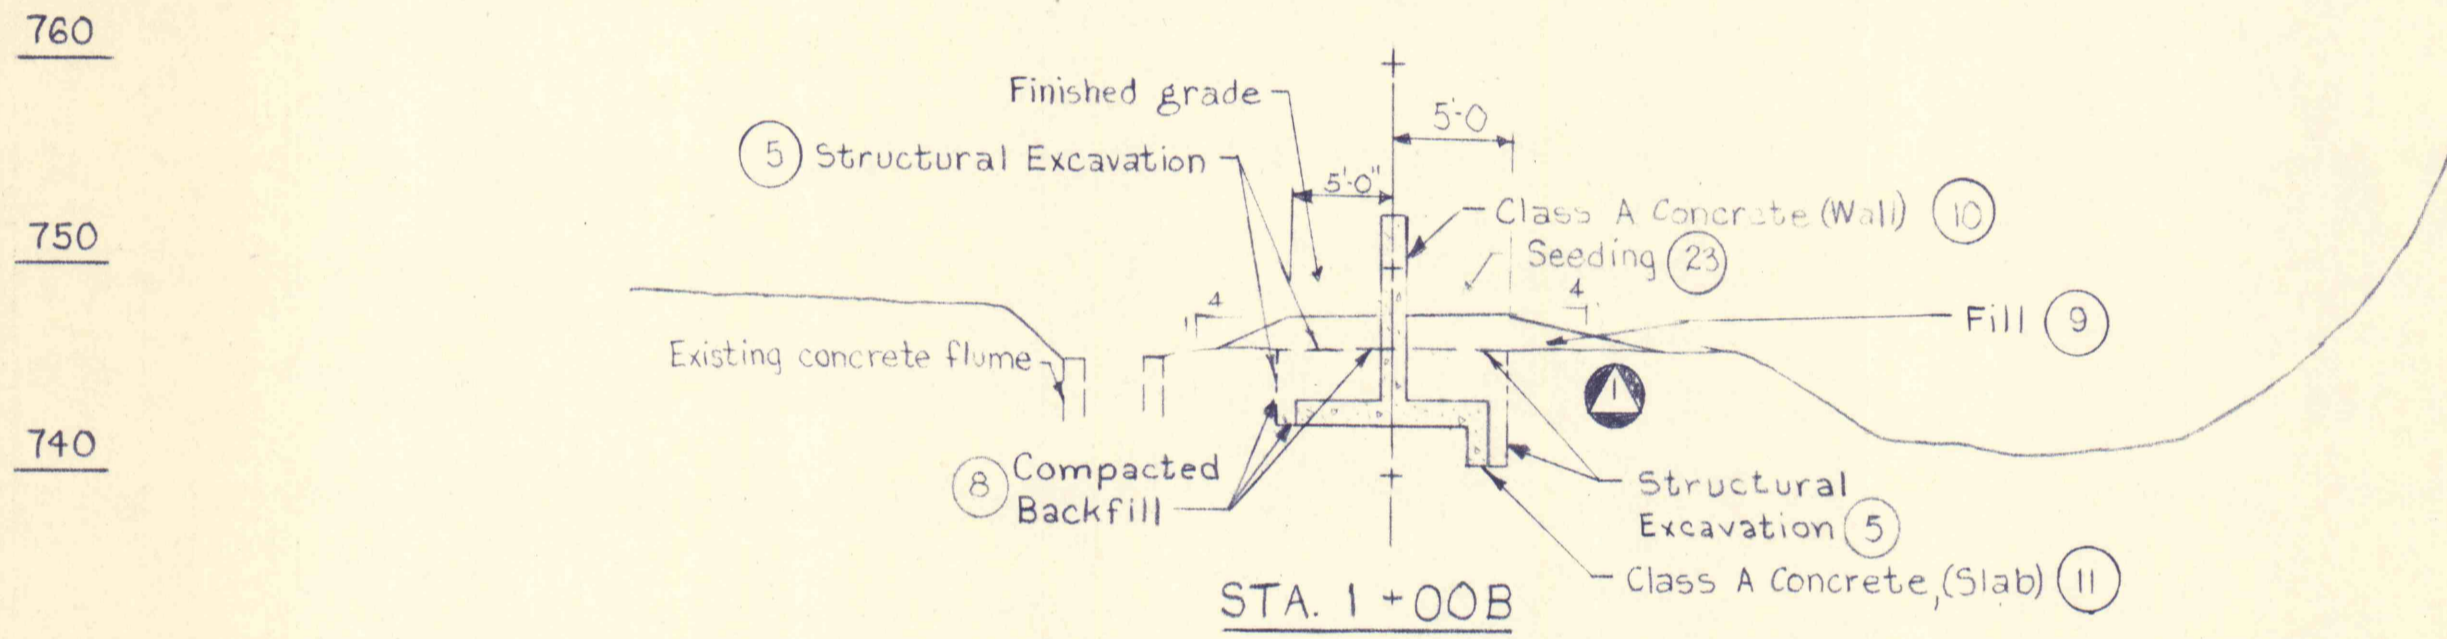

- REFERENCES:
1. For Plan and General Notes, see Dwg. No. 3
 2. For Profile see Dwg. No. 4
 3. For Concrete Notes, see Dwg. No. 6
 4. For Details see Dwg. No. 10

NOTES:
1. All Cross Sections are shown looking downstream

53075	Miscellaneous details, added revised retaining wall height		
NO.	DATE	REVISION	APPR.
SUBMITTED <i>B.R. Rao</i>			
PROJECT CO-ORDINATOR			
APPROVED <i>Robert A. Pameri</i>			
CHIEF - DIVISION OF MINE RECLAMATION			
APPROVED <i>W. L. Jones</i>			
DIRECTOR - BUREAU OF DESIGN			
COMMONWEALTH OF PENNSYLVANIA DEPARTMENT OF ENVIRONMENTAL RESOURCES OFFICE OF RESOURCES MANAGEMENT			
CONTRACT NO. SL 112-8			
MINE DRAINAGE POLLUTION ABATEMENT HEADWORK MODIFICATIONS AND FLOOD PROTECTION RAUSCH CREEK TREATMENT PLANT SCHUYLKILL CO. PENNSYLVANIA			
CROSS SECTIONS LEVEE B			
DRAWN BY <i>M. K. A.</i>	DATE 5-15-75	DRAWING NO. 9 OF 10	
CHECKED BY <i>L. R. M.</i>	SCALE 1 in. = 10 ft.		