

STOP WORK
STA. 29+10



CONSTRUCTION STATION

SURVEY STATION

15+00 [END 6:1 FLARED EARTH CHANNEL AT STA. 29+10]
 14+70 [END FLARED REINFORCED CONCRETE CHANNEL, BEGIN 6:1 FLARED EARTH CHANNEL]

NOTE:
STA. 28+95 @ RETAINING EMB., 10' WIDE TOP AT EL. 1046.0

14+50 [END 6' REINFORCED CONCRETE CHANNEL, BEGIN FLARED REINFORCED CONCRETE CHANNEL]

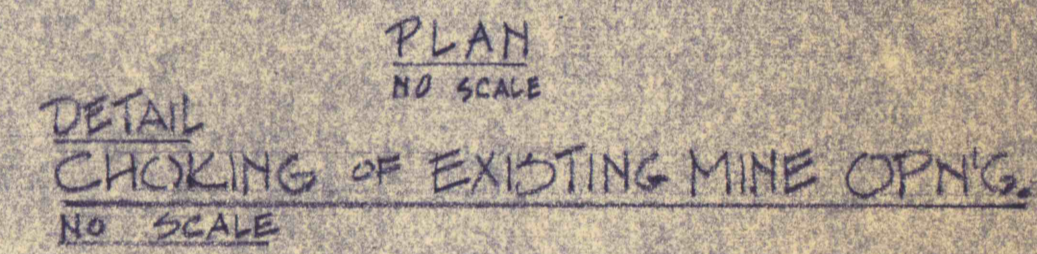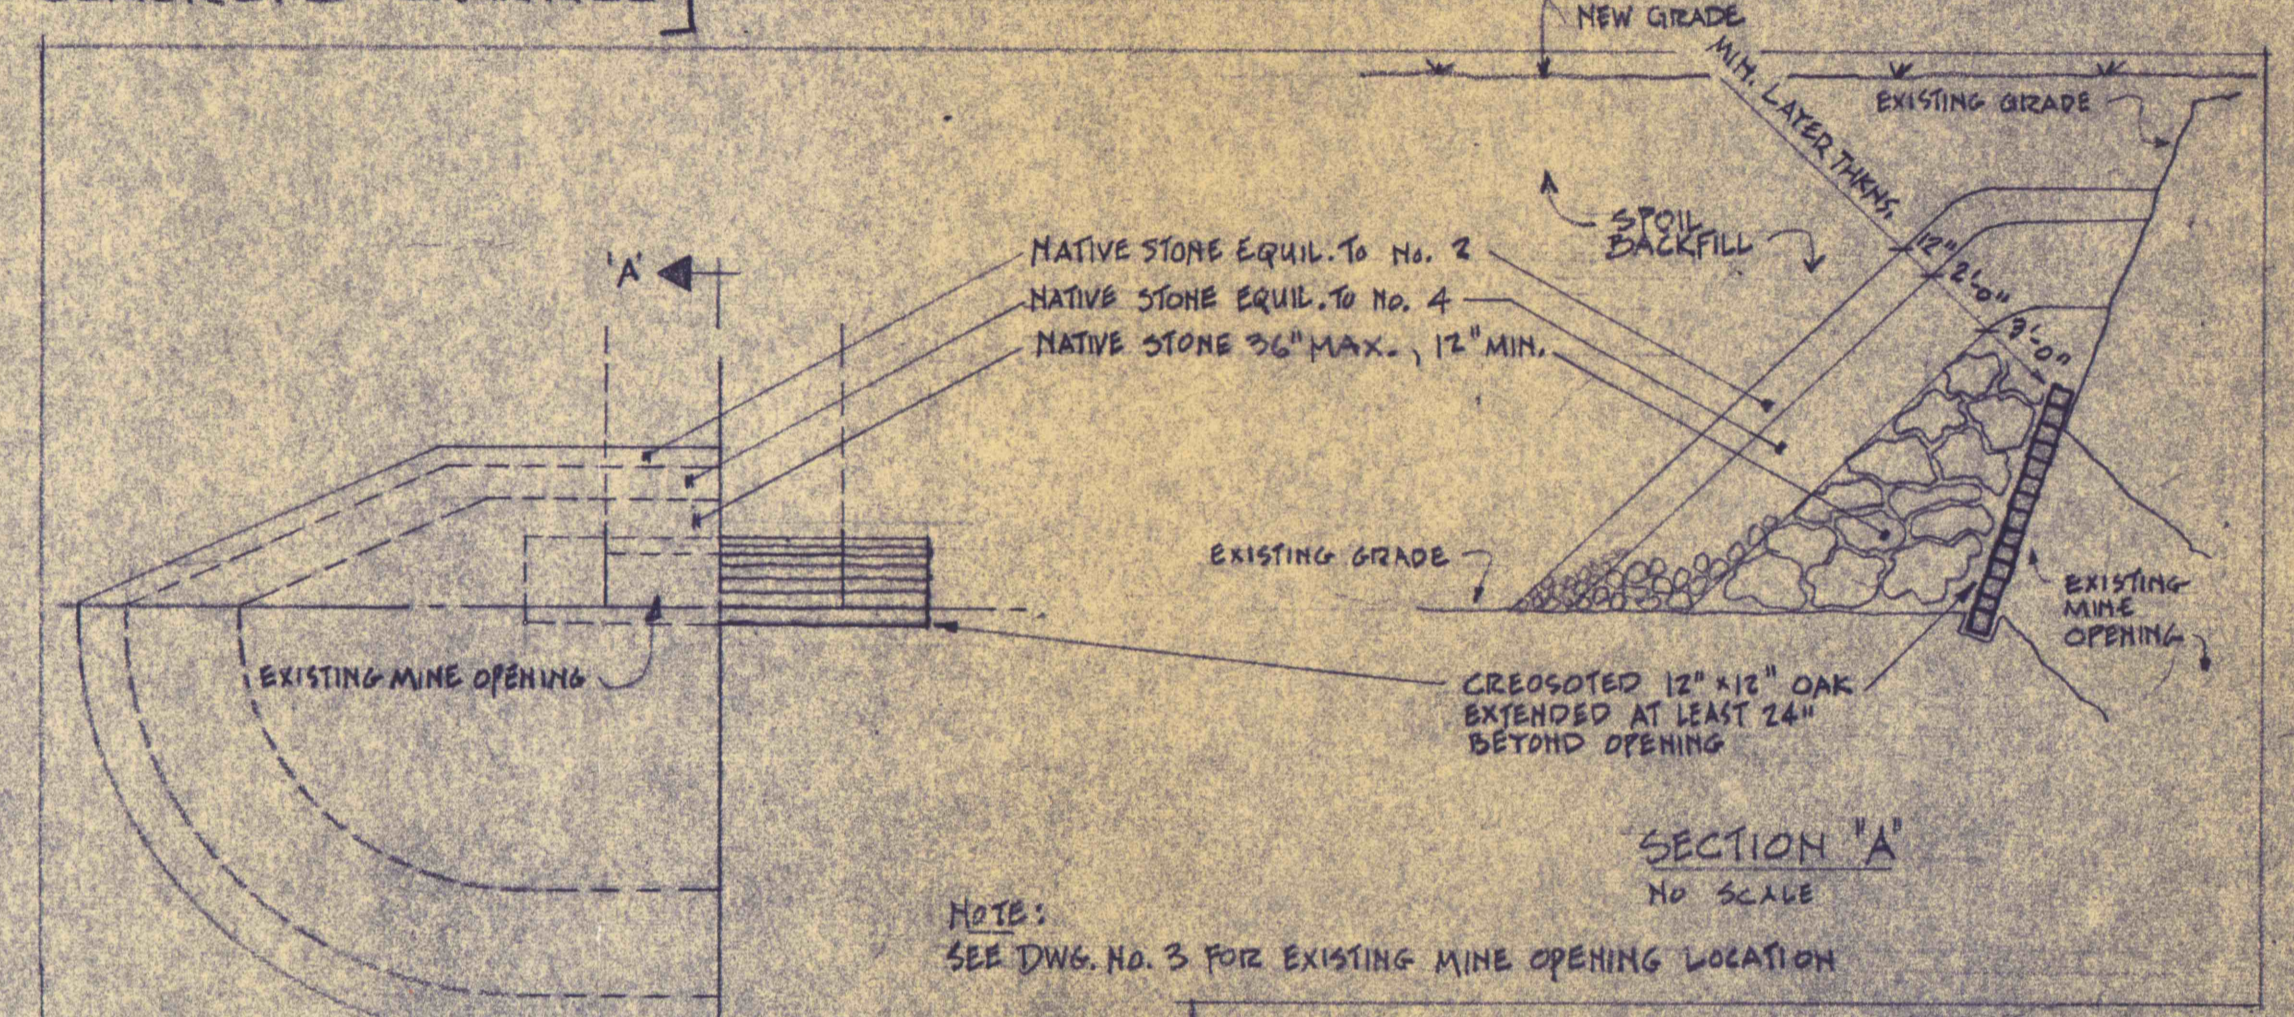

SECTIONS
 HORI. SCALE: 1"=10'
 VERT. SCALE: 1"=10'

LEGEND
 EXISTING GRADE LINES ---
 FINAL GRADE LINES ———



NO.	DATE	REVISION	APPR.
SUBMITTED		<i>James D. Cowley</i> PROFESSIONAL	
APPROVED		<i>Robert C. Rainey</i> CHIEF - DIVISION OF MINE RECLAMATION	
APPROVED		<i>Andrew</i> DIRECTOR - BUREAU OF DESIGN	
COMMONWEALTH OF PENNSYLVANIA DEPARTMENT OF ENVIRONMENTAL RESOURCES OFFICE OF RESOURCES MANAGEMENT			
PROJECT NO. SL 126-1-5 MINE DRAINAGE POLLUTION ABATEMENT SWATARA CREEK WATERSHED UPPER SWATARA CREEK & POLLY'S RUN REILLY TWP. SCHUYLKILL CO., PA.			
NICHOLAS-COWLEY-BROSCH ASSOC., INC. 3300 NORTH THIRD STREET HARRISBURG, PENNSYLVANIA 17110			
UPPER SWATARA CREEK SECTIONS - PAR			
DRAWN BY	DATE	DRAWING	
BEL	Jan. 11, 1974	9	
CHECKED BY	SCALE		
HFC	As shown		