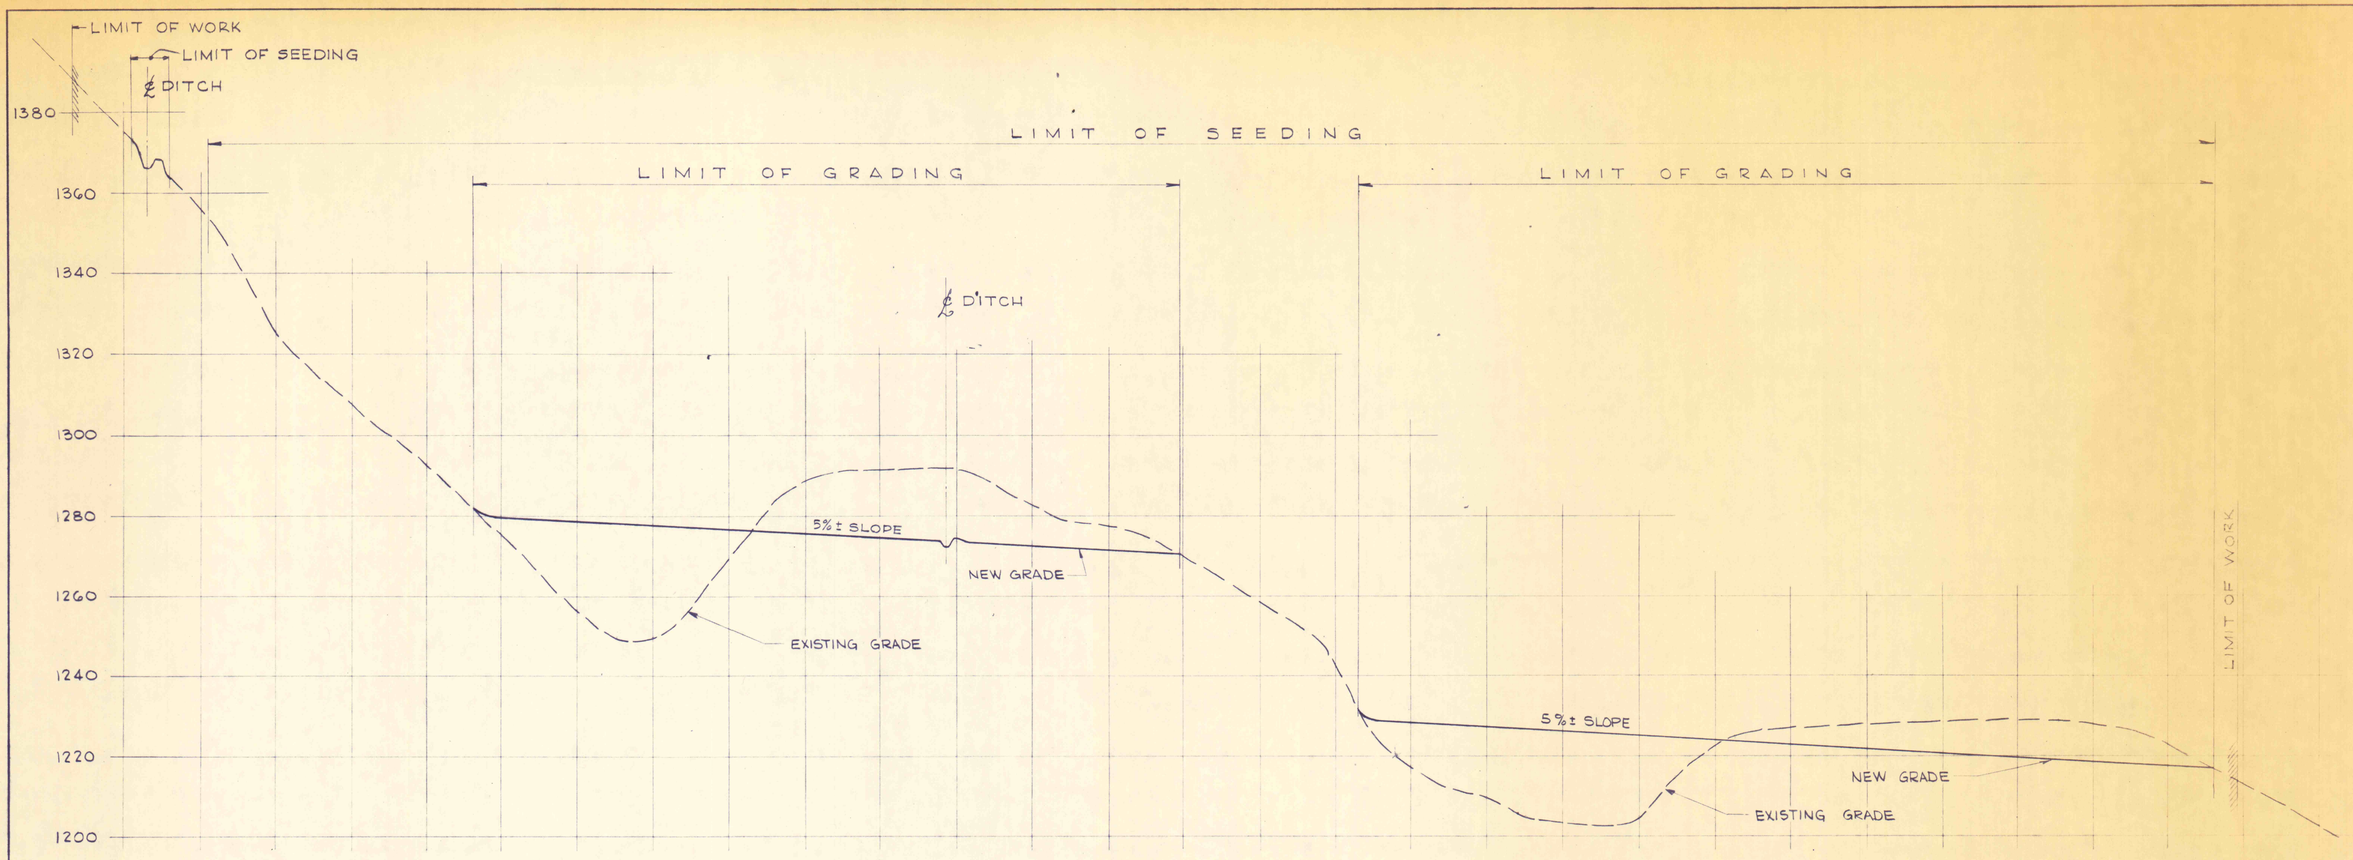

CROSS-SECTION NO. 3

SCALE: 1" = 20' (HORIZ. & VERT.)
FOR LOCATION SEE DRAWING NO. 2

FOR LEGEND & NOTES SEE DWG. NO. 2

NO.	DATE	REVISION	APPR
	9-24-75	As built	

SUBMITTED Thomas Richard Babacz
PROFESSIONAL

APPROVED Edward A. Ramsey
CHIEF - DIVISION OF MINE DRAINAGE REHABILITATION

APPROVED Sam Perrazzo
DIRECTOR - BUREAU OF CONSULTING SERVICES

COMMONWEALTH OF PENNSYLVANIA
REGISTERED PROFESSIONAL
THOMAS RICHARD BABACZ
ENGINEER
NO. 12804E

COMMONWEALTH OF PENNSYLVANIA
DEPARTMENT OF ENVIRONMENTAL RESOURCES
OFFICE OF ENGINEERING AND CONSTRUCTION

PROJECT NO. SL-170

STRIP MINE RECLAMATION
QUICK START PROJECT "B"
STATE GAME LAND NO.264
WICONISCO CREEK WATERSHED
DAUPHIN COUNTY, PENNA.

SANDERS AND THOMAS, INC.
CONSULTING ENGINEERS
EXECUTIVE OFFICES POTTSTOWN, PENNSYLVANIA
BRANCH OFFICES: PHILADELPHIA, PA. - LONG ISLAND, N.Y. - MIAMI, FLA. PITTSBURGH, PA. - BALTIMORE, MD. - LONG BEACH, CALIF. - WASHINGTON D.C.

CROSS-SECTION NO. 3

DRAWN BY	DATE	DRAWING NO.
T Z	MAY 4, 1973	6 of 7
CHECKED BY T B	SCALE AS NOTED	