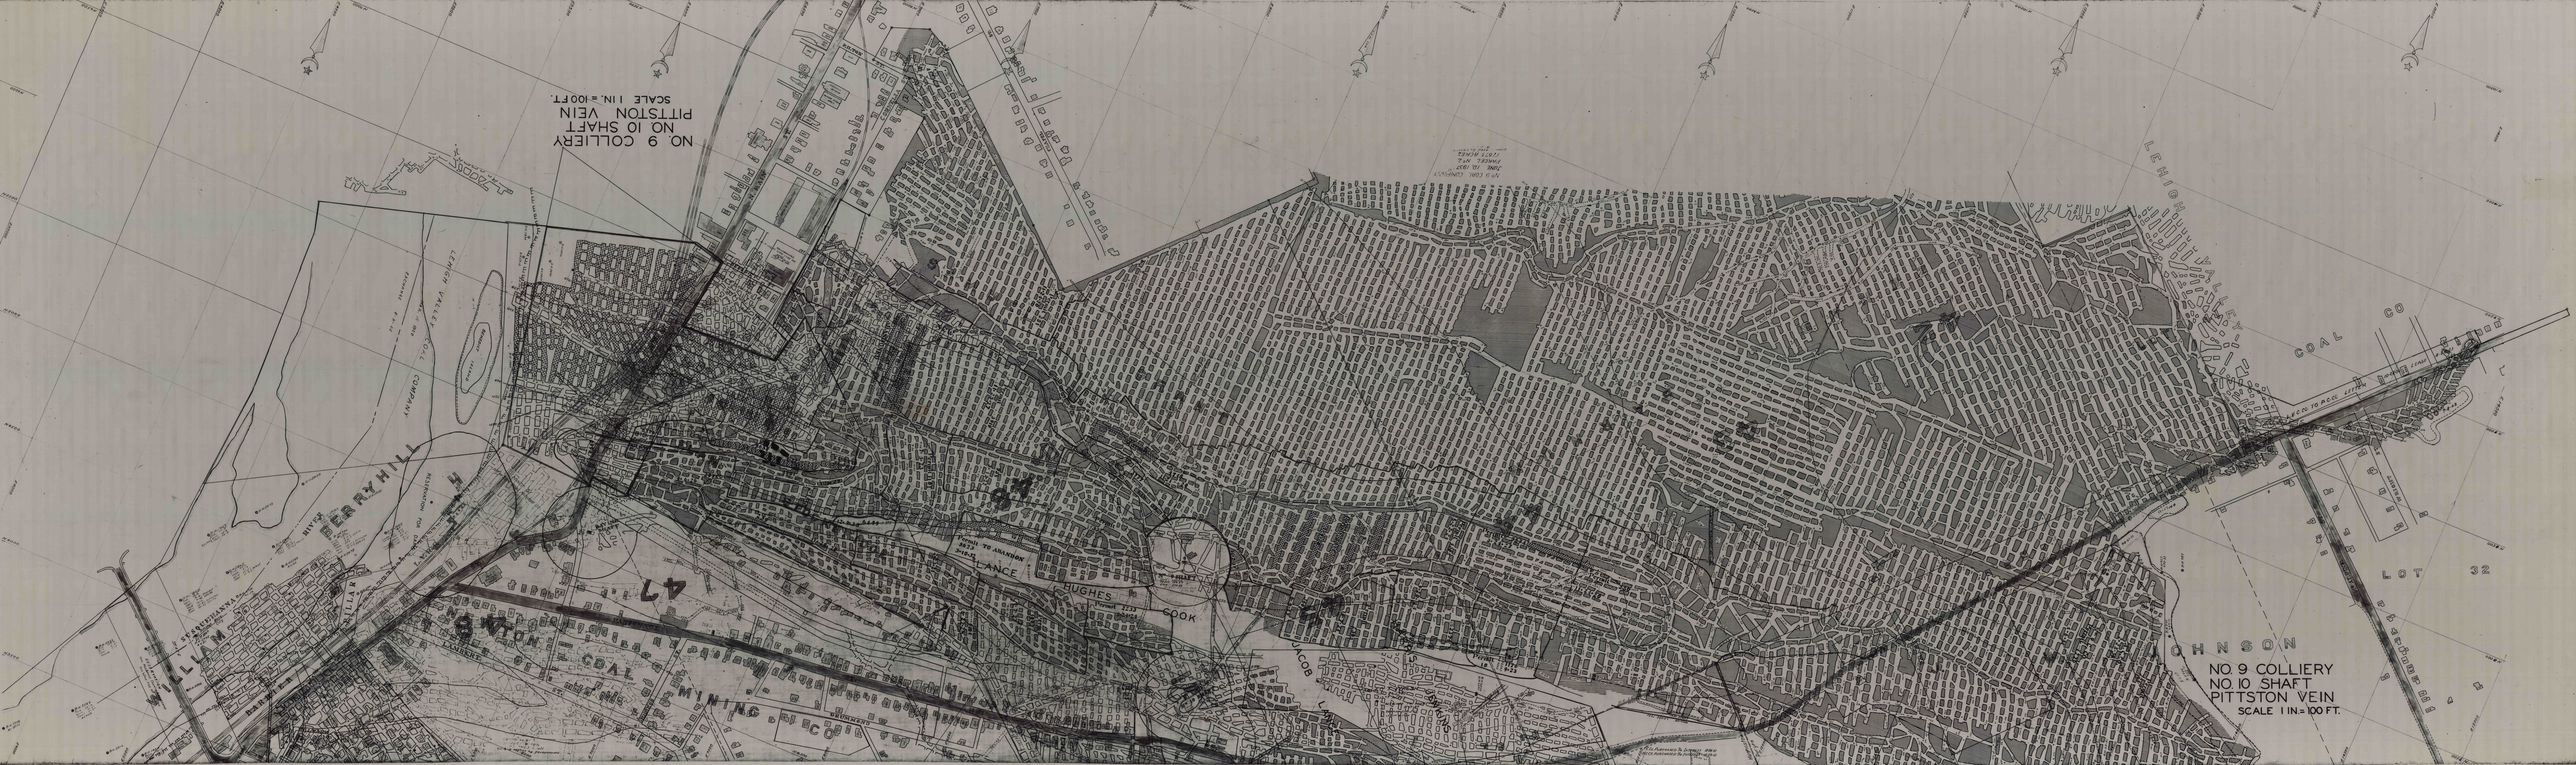
NO 9 COLLIERY
NO 10 SHAFT
PITTSTON VEIN
SCALE 1 IN = 100 FT.
NO. 9 COLLIERY
NO 10 SHAFT
PITTSTON VEIN
SCALE 1 IN. = 100 FT.
LEHIGH VALLEY
COAL CO
LOT 32
JOHNSON
LANCE
HUGHES
COOK
JACOB
FERRY HILL
WILLIAM
PITTSTON COAL MINING CO
47