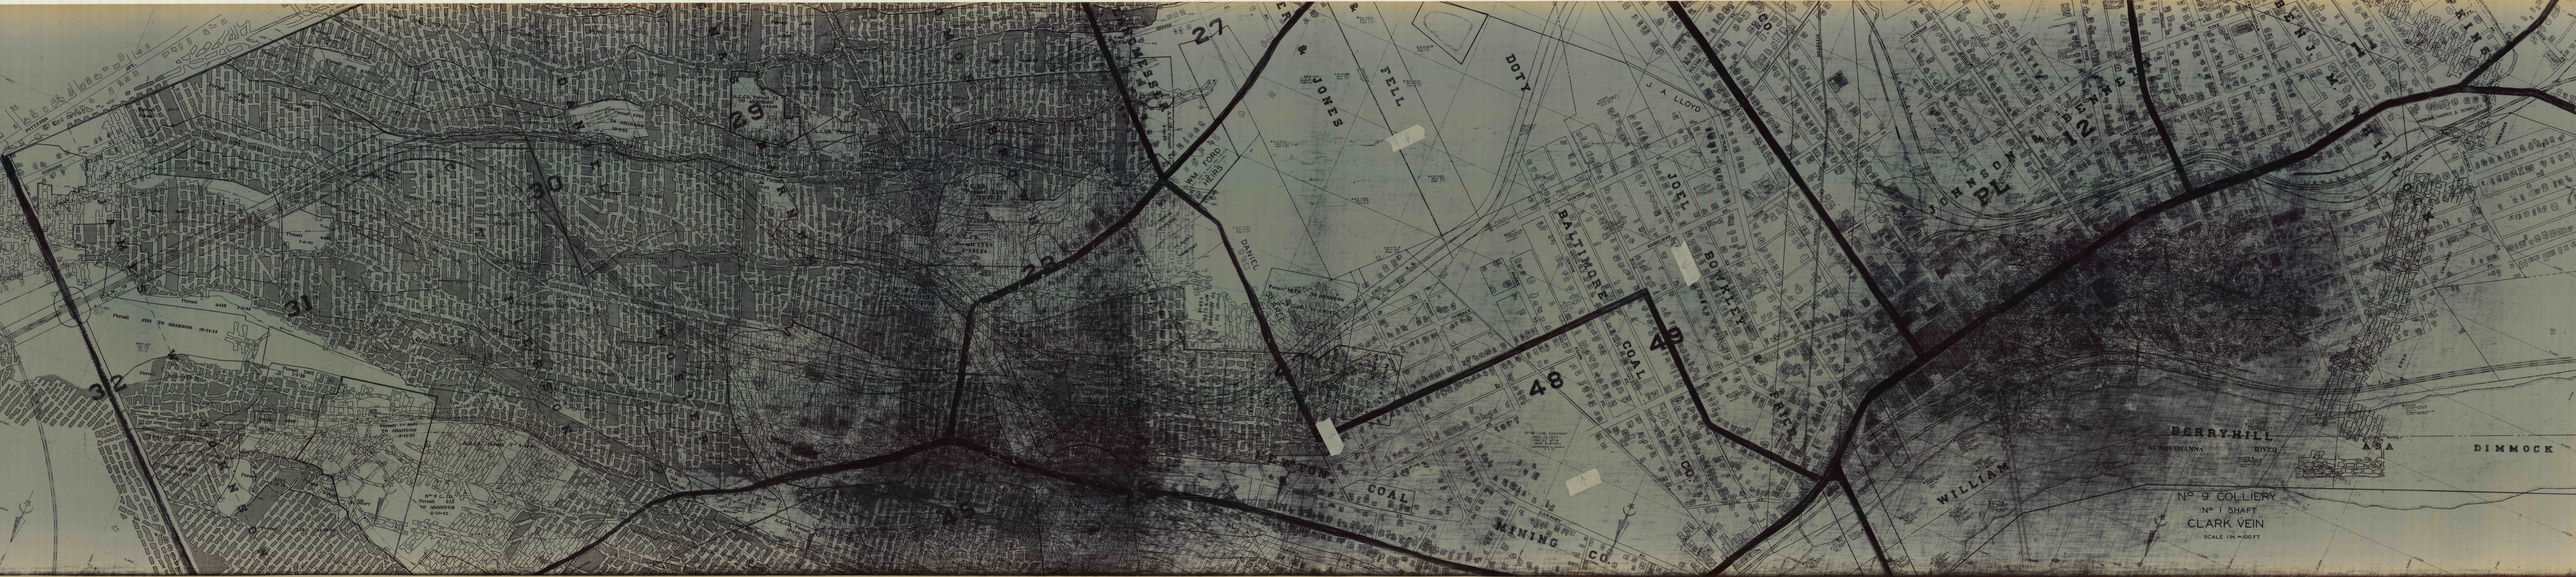
JONES & FELL
DOTY
J. A. LLOYD
JOEL
BALTIMORE COAL CO.
POWELL & BRICE
JOHNSON PL
WILLIAM
DANIEL
WM. P. FORD HEIRS
BERRYHILL
DIMMOCK
No. 9 COLLIERY
No. 1 SHAFT
CLARK VEIN
SCALE 1 IN = 100 FT