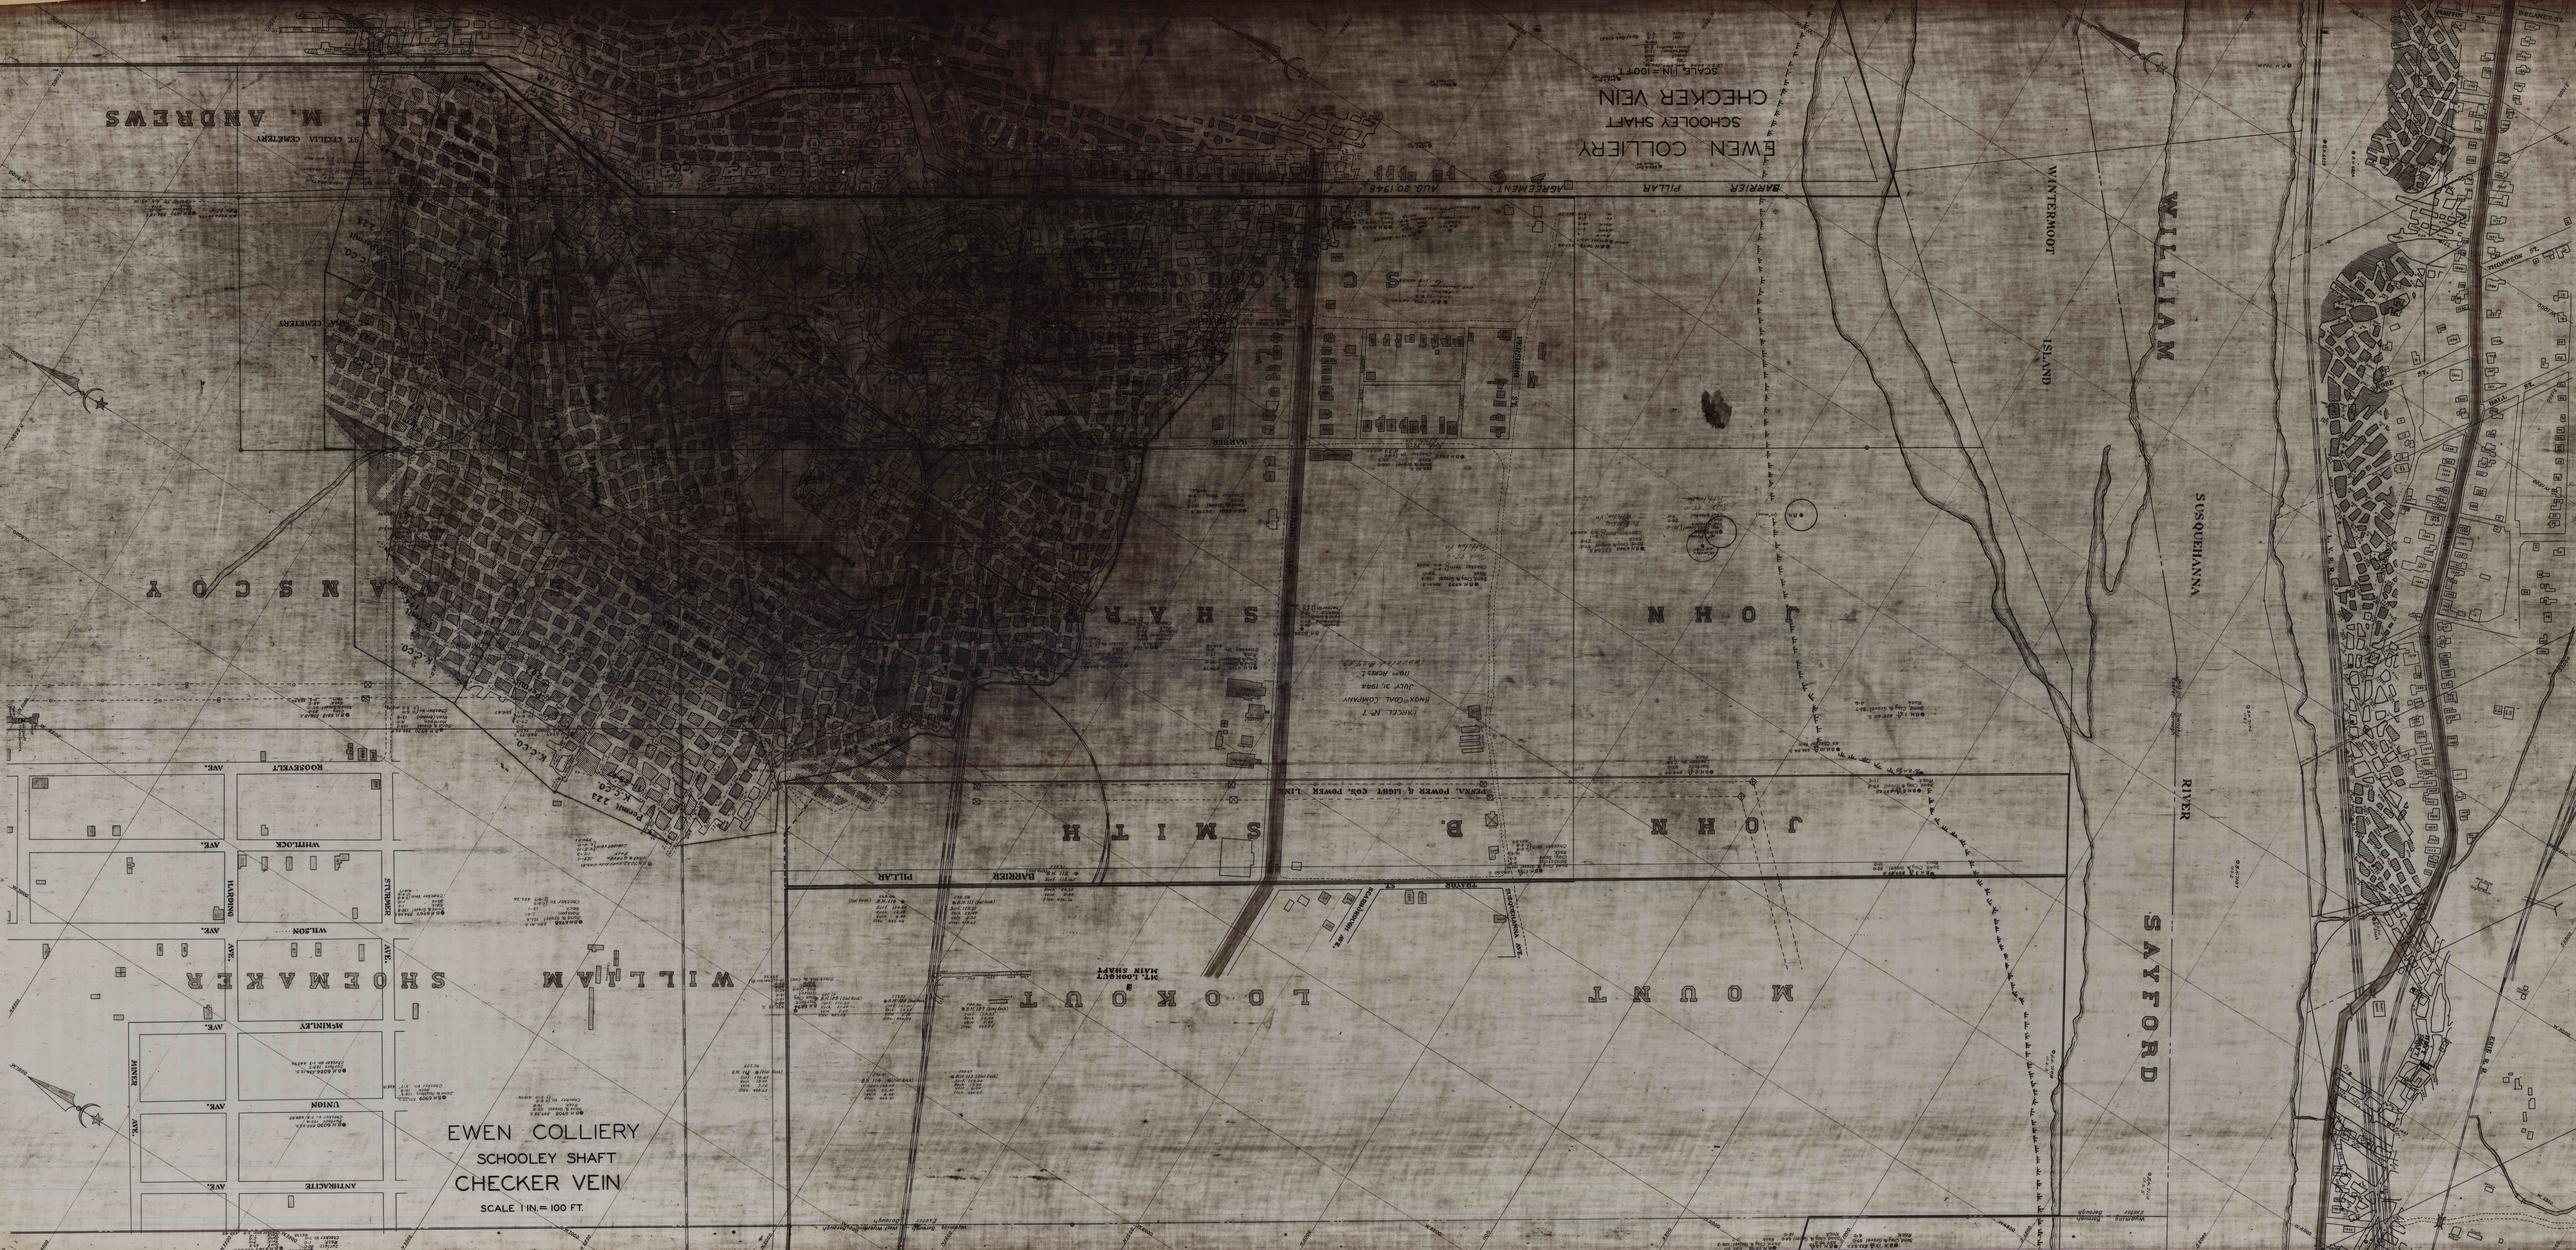
EWEN COLLIERY
SCHOOLEY SHAFT
CHECKER VEIN
SCALE 1 IN. = 100 FT.
WILLIAM SHOEMAKER
JOHN B. SMITH
JOHN SHARP
MOUNT LOOKOUT
WILLIAM SAYFORD
SUSQUEHANNA RIVER
WINTERMOOT ISLAND
BARRIER PILLAR
AGREEMENT AUG 20 1948
ROOSEVELT AVE.
WHITLOCK AVE.
WILSON AVE.
McKINLEY AVE.
UNION AVE.
ANTHRACITE AVE.
MINER AVE.
HARDING AVE.
STURMER AVE.
PENNA. POWER & LIGHT CO'S. POWER LINE
MT. LOOKOUT MAIN SHAFT
K.C.CO.
Permit 223