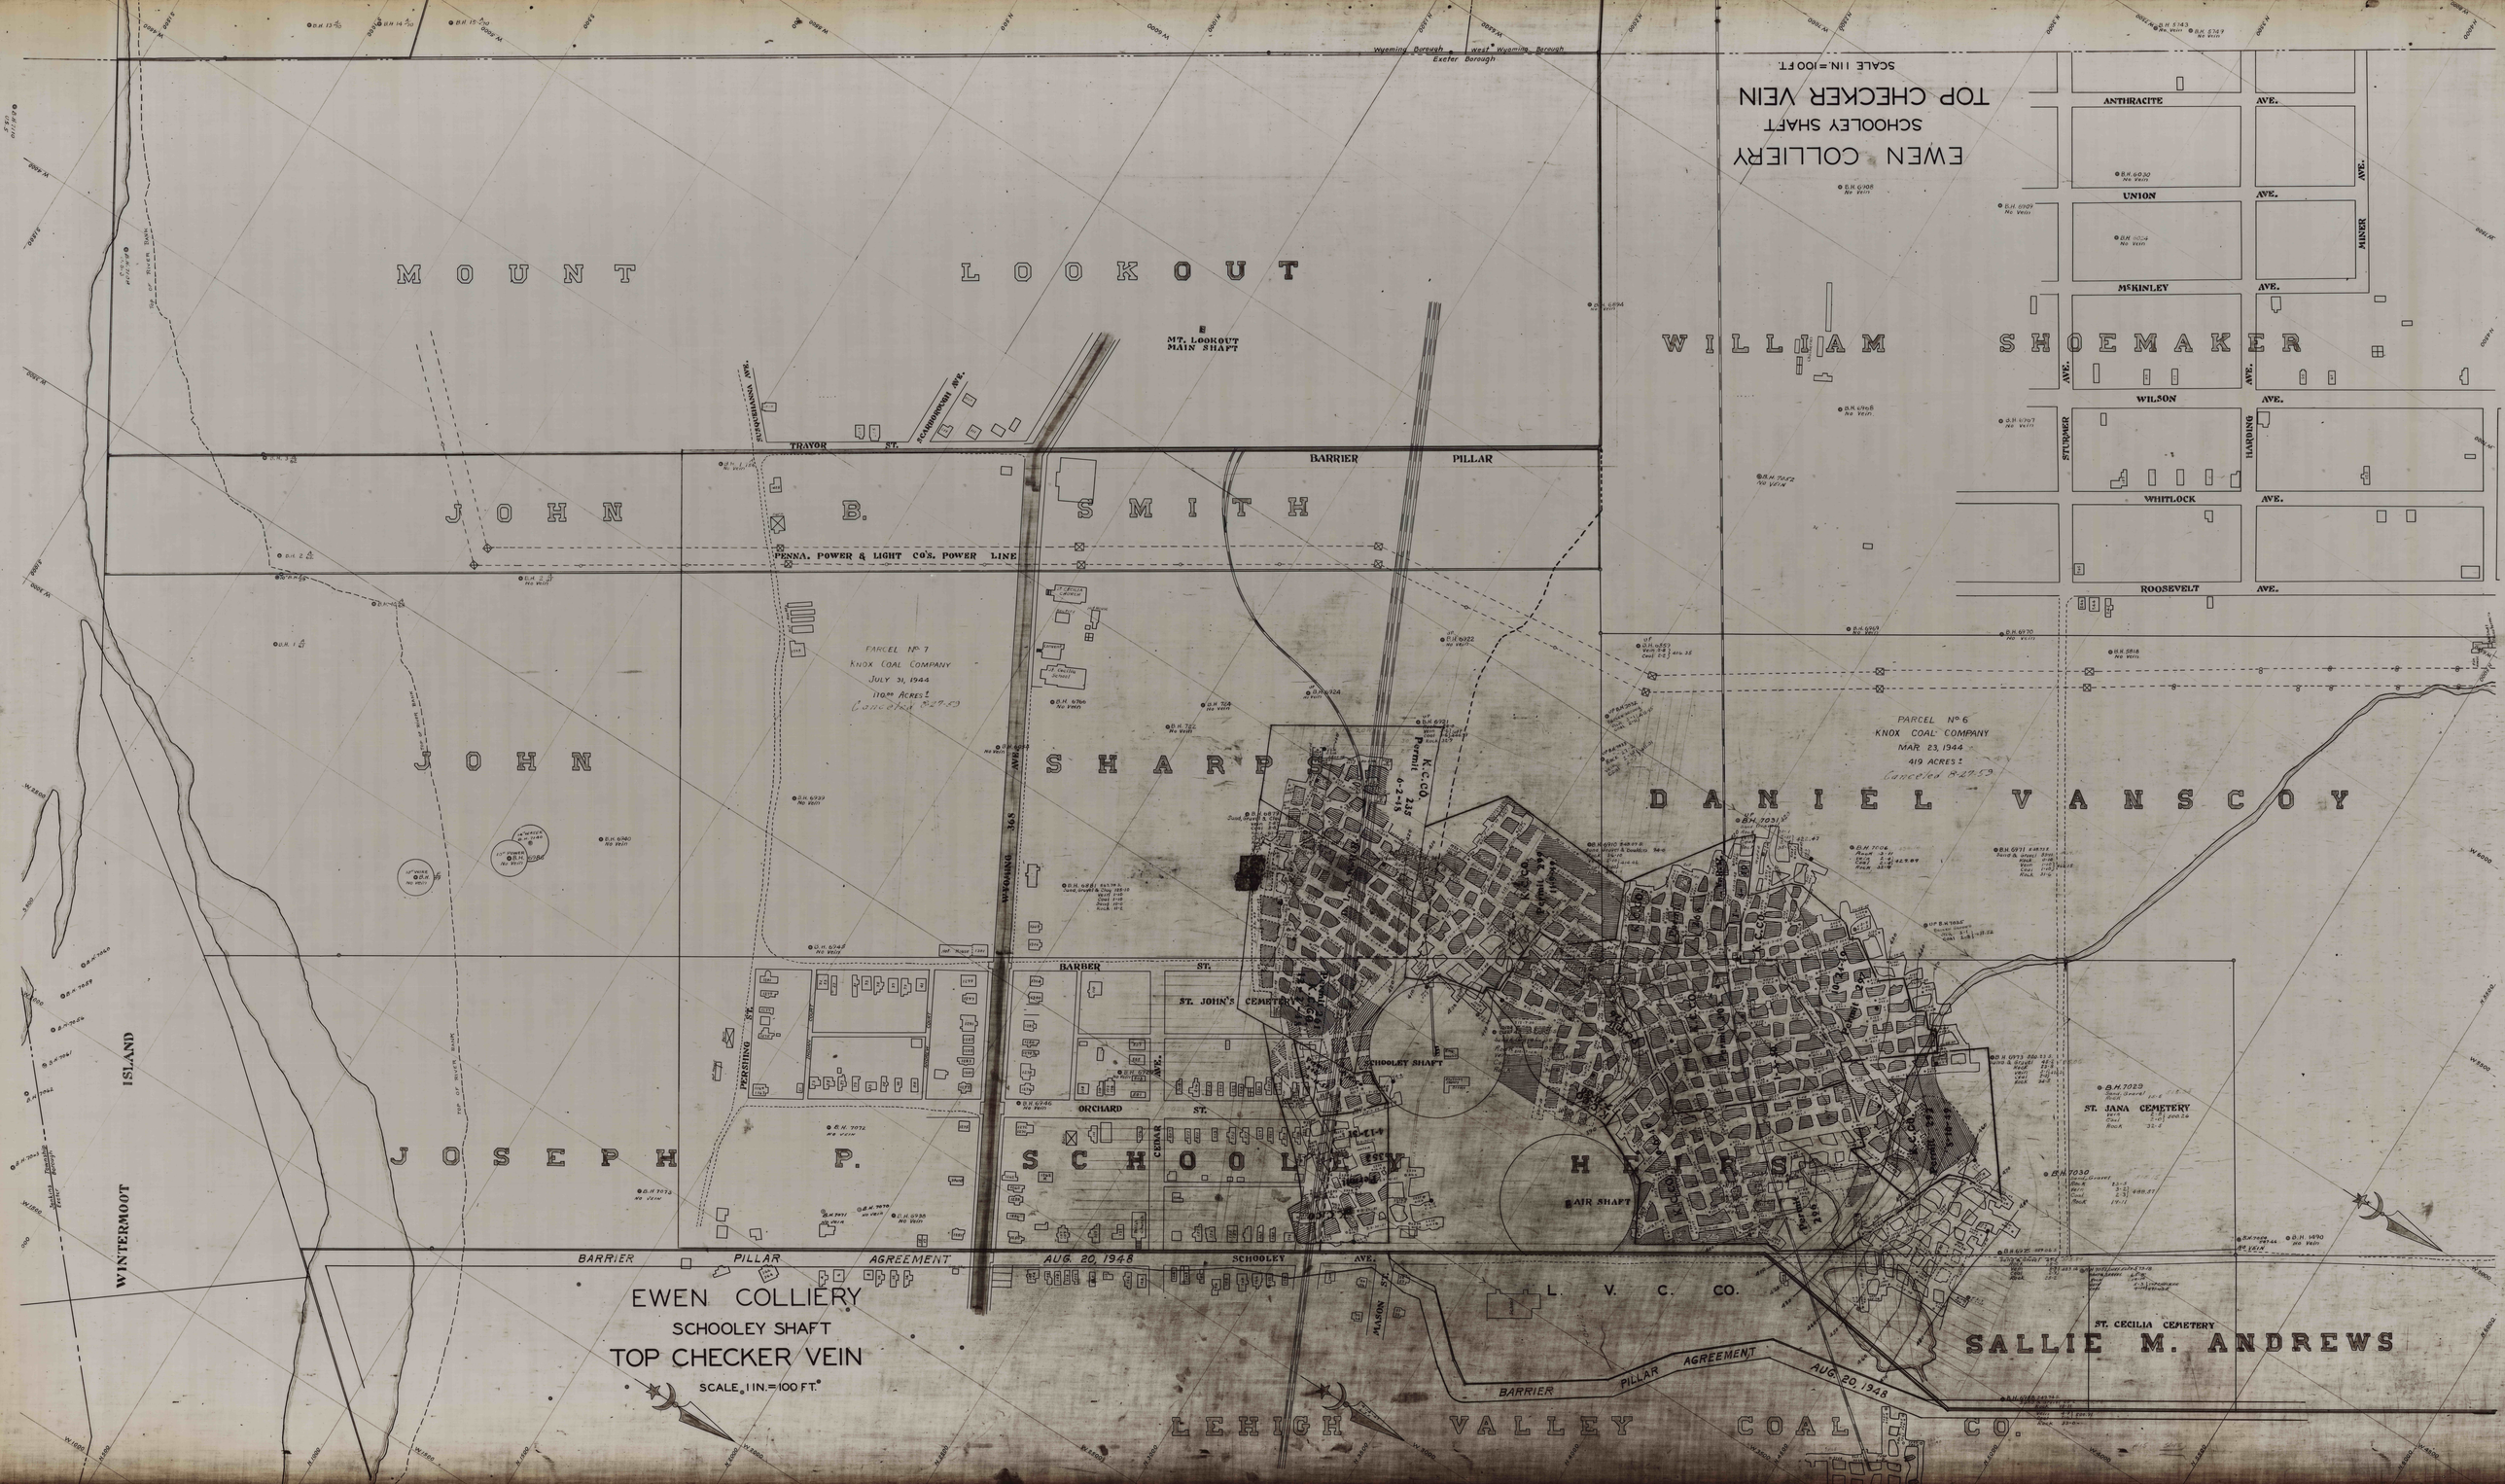
EWEN COLLIERY
SCHOOLEY SHAFT
TOP CHECKER VEIN
SCALE 1 IN. = 100 FT.
MOUNT LOOKOUT
MT. LOOKOUT MAIN SHAFT
JOHN B. SMITH
JOHN SHARPS
JOSEPH P. WINTERMOOT ISLAND
WILLIAM SHOEMAKER
DANIEL VANSCOY
SALLIE M. ANDREWS
PARCEL No 7
KNOX COAL COMPANY
JULY 31, 1944
110.00 ACRES!
Cancelled 8279
PARCEL No 6
KNOX COAL COMPANY
MAR 23, 1944
419 ACRES!
Cancelled 8279
PENNA. POWER & LIGHT CO'S. POWER LINE
BARRIER PILLAR
BARRIER PILLAR AGREEMENT AUG. 20, 1948
SCHOOLEY SHAFT
AIR SHAFT
ST. JOHN'S CEMETERY
ST. JANA CEMETERY
ST. CECILIA CEMETERY
L. V. C. CO.
LEHIGH VALLEY COAL CO.
ANTHRACITE AVE.
UNION AVE.
McKINLEY AVE.
WILSON AVE.
WHITLOCK AVE.
ROOSEVELT AVE.
MINER AVE.
STURGNER AVE.
HARDING AVE.
WYOMING AVE.
PERSHING ST.
BARBER ST.
ORCHARD ST.
SCHOOLEY AVE.
TRAVOR ST.
SCHOOLEY ST.
MASON ST.
CEDAR ST.
Wyoming Borough
West Wyoming Borough
Exeter Borough