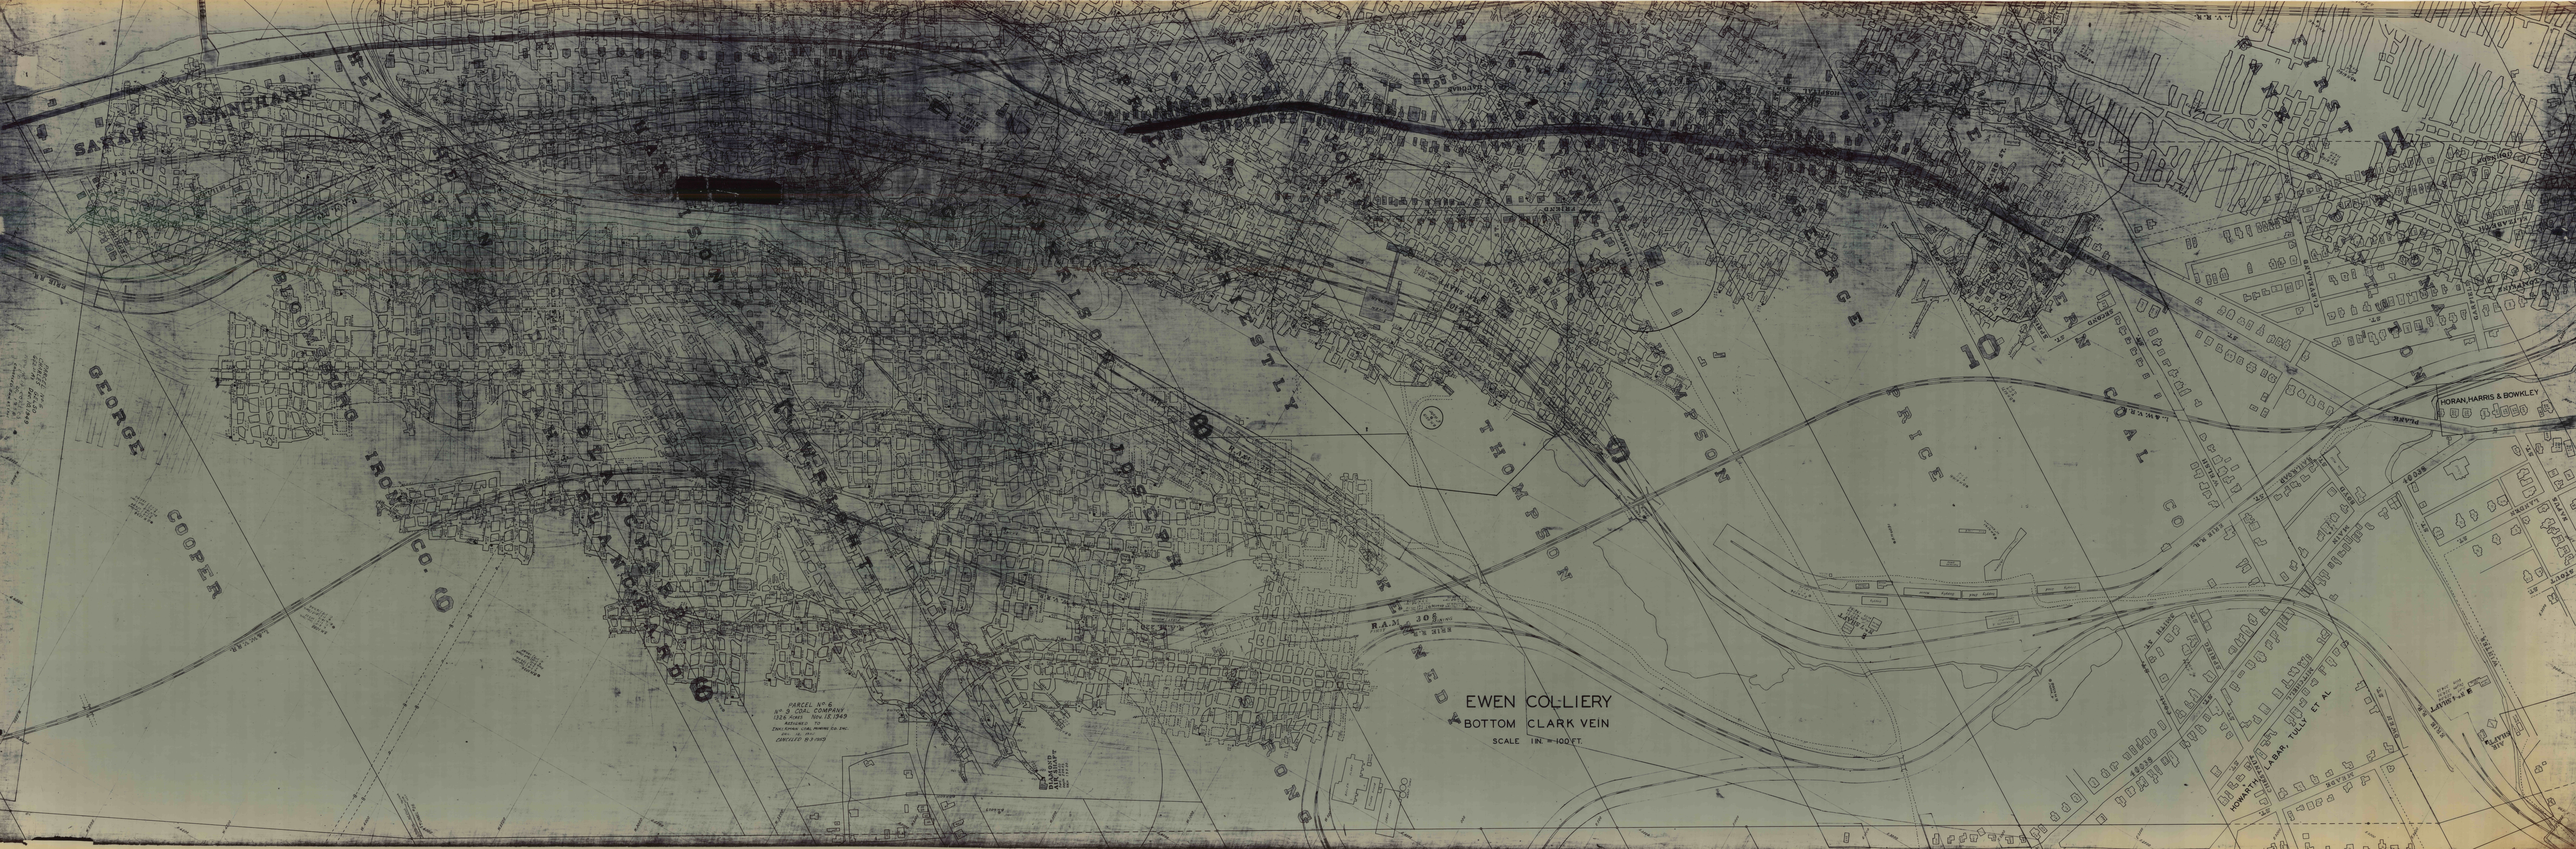
EWEN COLLIERY
BOTTOM CLARK VEIN
SCALE 1IN. = 100 FT.
GEORGE COOPER
IRON CO.
THOMPSON
PRICE
COAL CO
HORAN, HARRIS & BOWKLEY
HOWARTH, LABAR, TULLY ET AL
PARCEL No 6
No 9 COAL COMPANY
1326 ACRES NOV 15 1949
RESERVED TO
ENGLISHTOWN COAL MINING CO. INC.
CANCELLED 8-3-1949
DIAMOND AIR SHAFT
R.A.M. 30