

WILLIAM SHOEMAKER

DANIEL




VANSCOY

SALLIE M.

ANDREWS

SLOCUM ST

SCHOOLLEY AVENUE

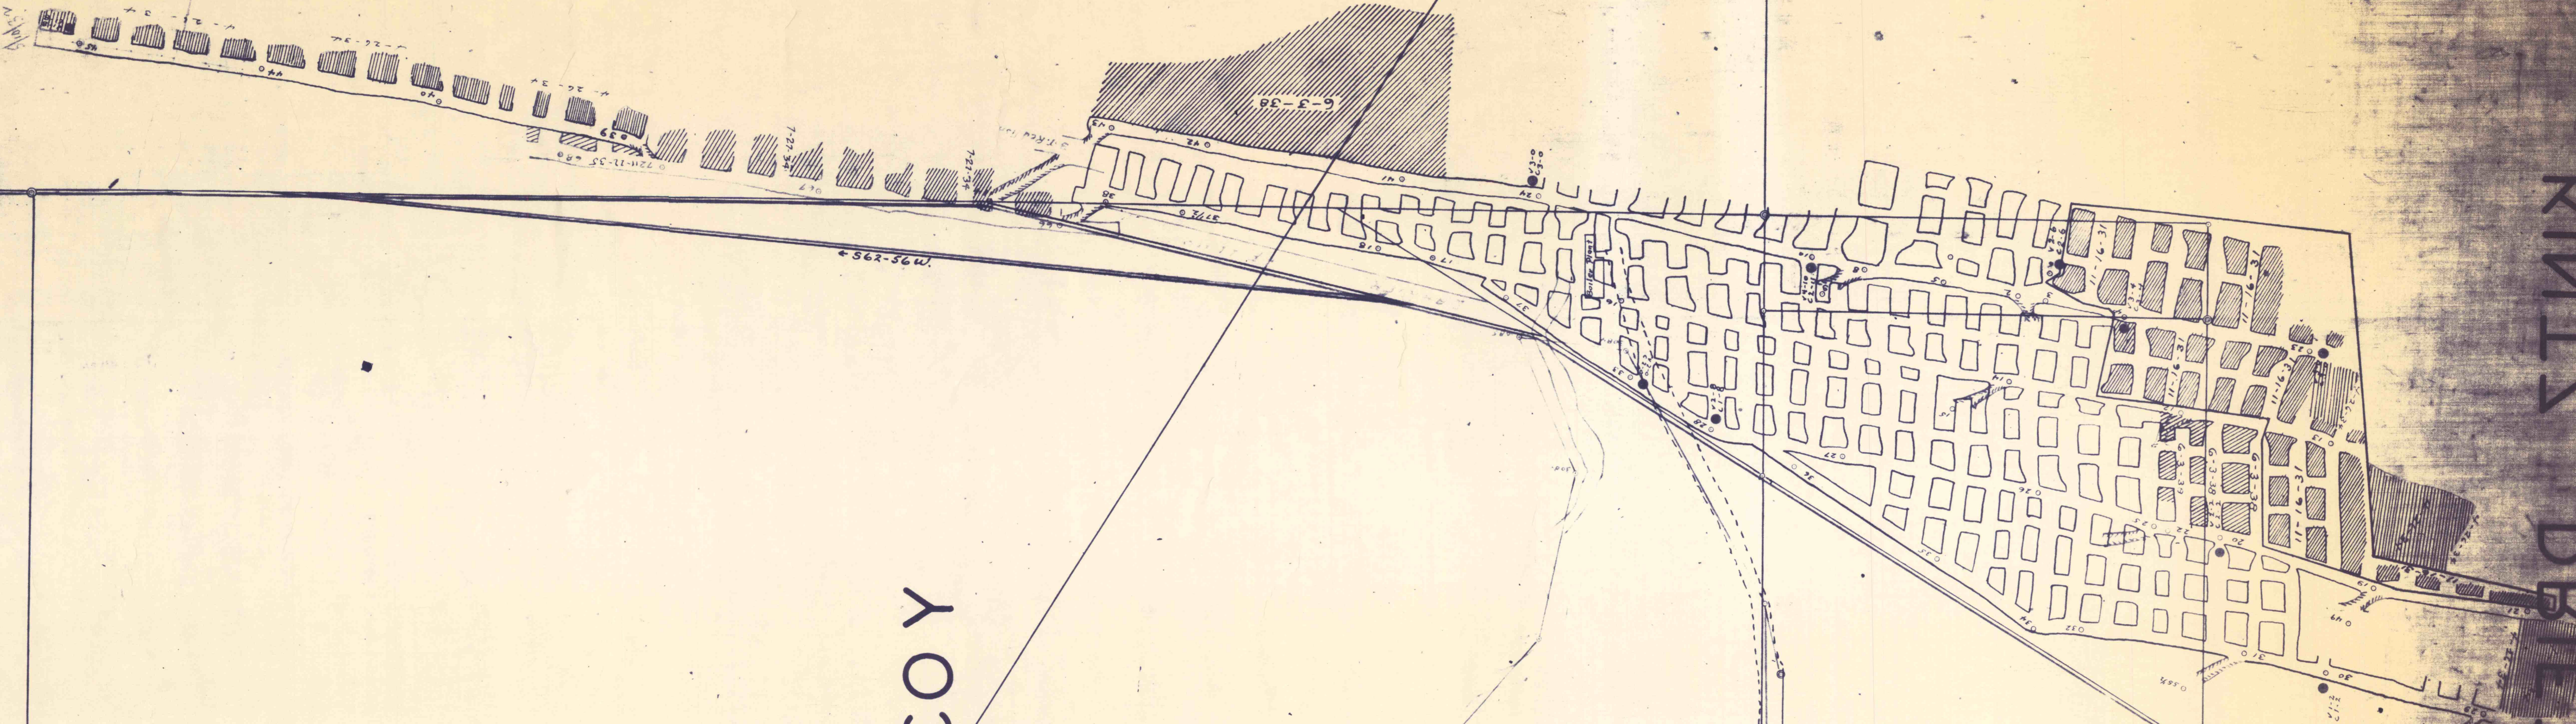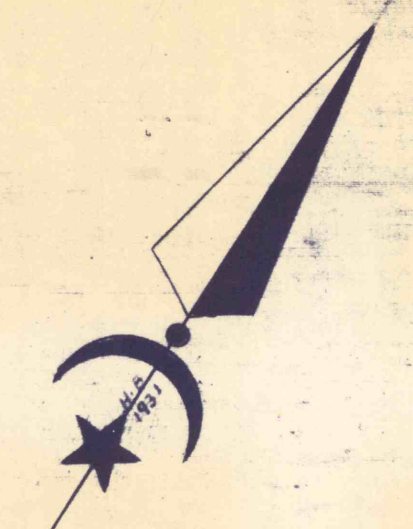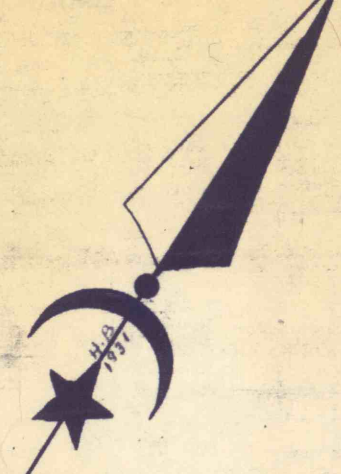

DRY 4
KINLS DRETT
A
NEIN
DRY 4