


CHECKER VEIN
SCALE 1"=100'

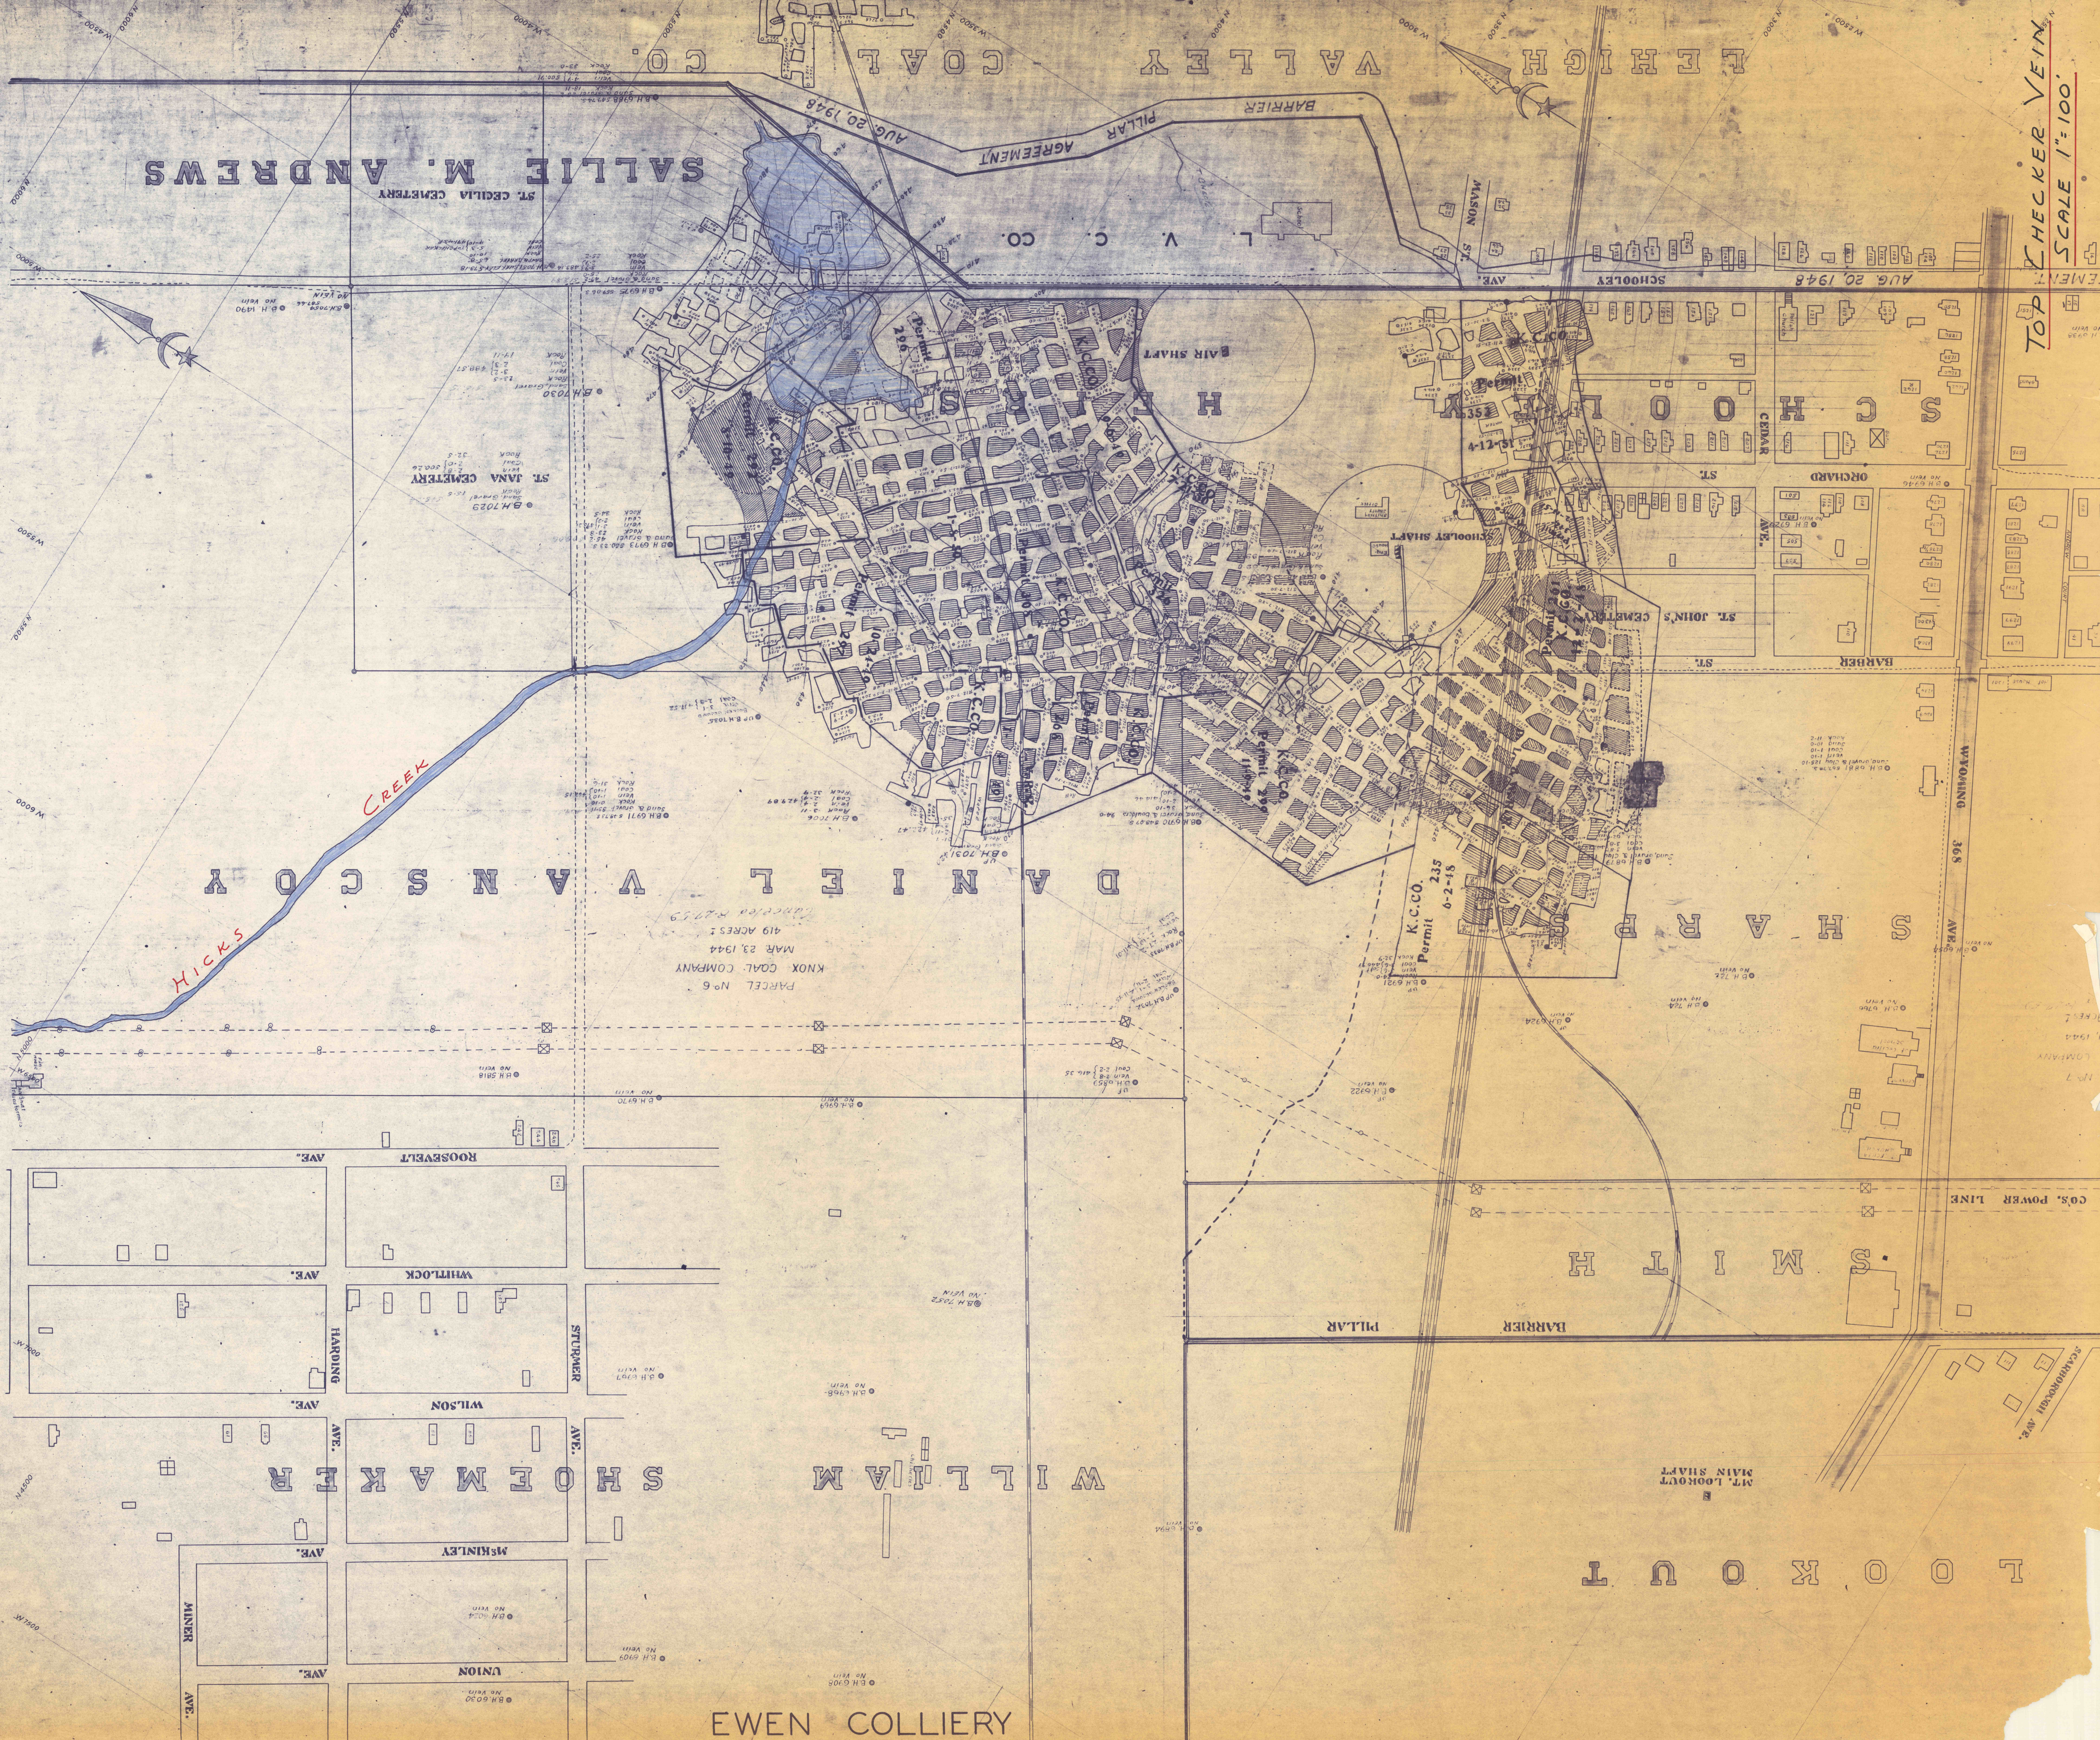

HICK'S CREEK

PARCEL No 6
KNOX COAL COMPANY
MAR 23, 1944
419 ACRES

K.C.C.O.
Permit 235
6-2-15

SALLIE M. ANDREWS

EWEN COLLIERY


LOOKOUT

S. MITH

WILSON

McKINLEY

UNION

ROOSEVELT AVE.

WHITLOCK AVE.

HARDING AVE.

STURPNER AVE.

MINER AVE.

PILLAR BARRIER


ST. JOHNS CEMETERY

SCHOOL SHAF

HAIR SHAF

SCHOOL SHAF

ORCHARD ST.

BARBER ST.

WYOMING AVE.

COS. POWER LINE

SCHANDOROCK AVE.

COAL CO.

PILLAR BARRIER

L. E. HIGGH

VALLEY

ST. CECILIA CEMETERY

CO. V. C.

SCHOOLS

AUG 20, 1948

AUG 20, 1948

TOP