


SALLIE M. ANDREWS

DANIEL VANSCOV

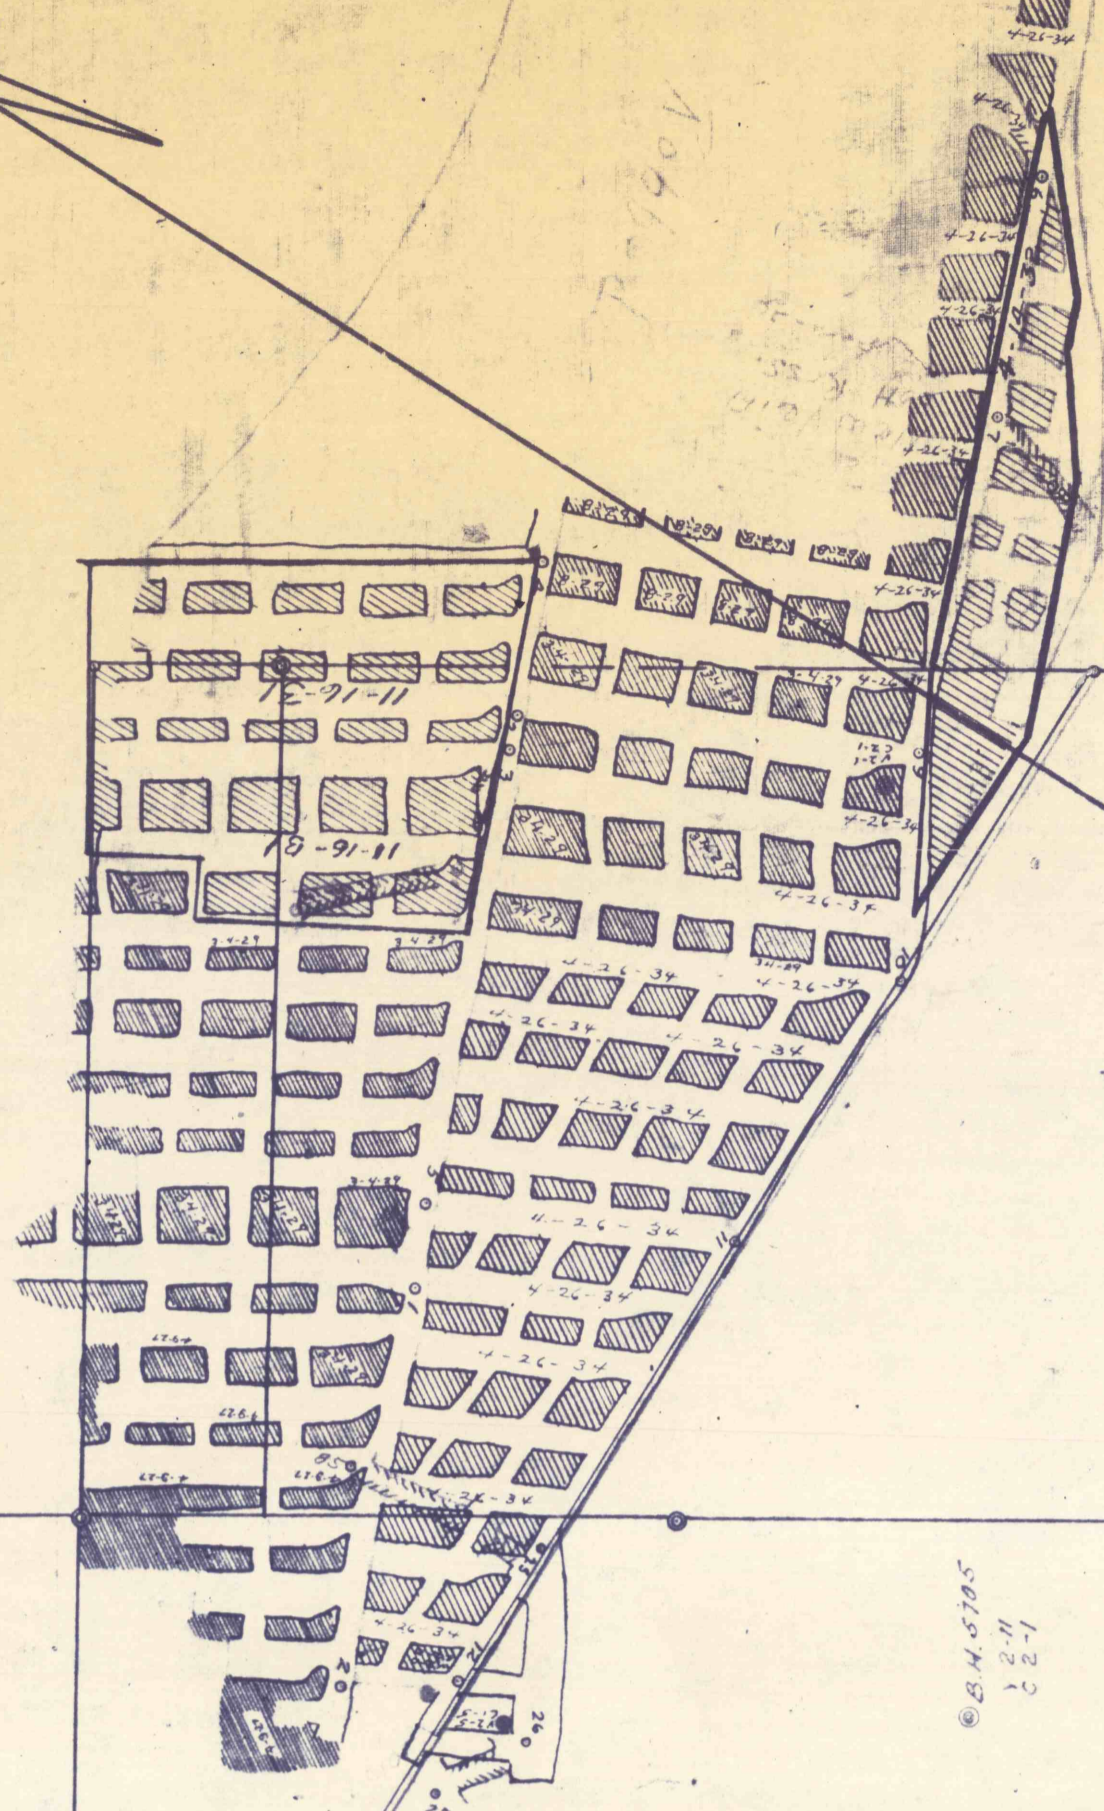

© B.H. 5672
K.O.S.
C.O.O.

© B.H. 5671
K.O.S.
C.O.O.

© B.H. 5665
K.O.S.
C.O.O.

N. 59-20 E. 827.67
S 63-54 W
1200.96



© N. 29-20 E. 234.5

© B.H. 5665
K.O.S.
C.O.O.