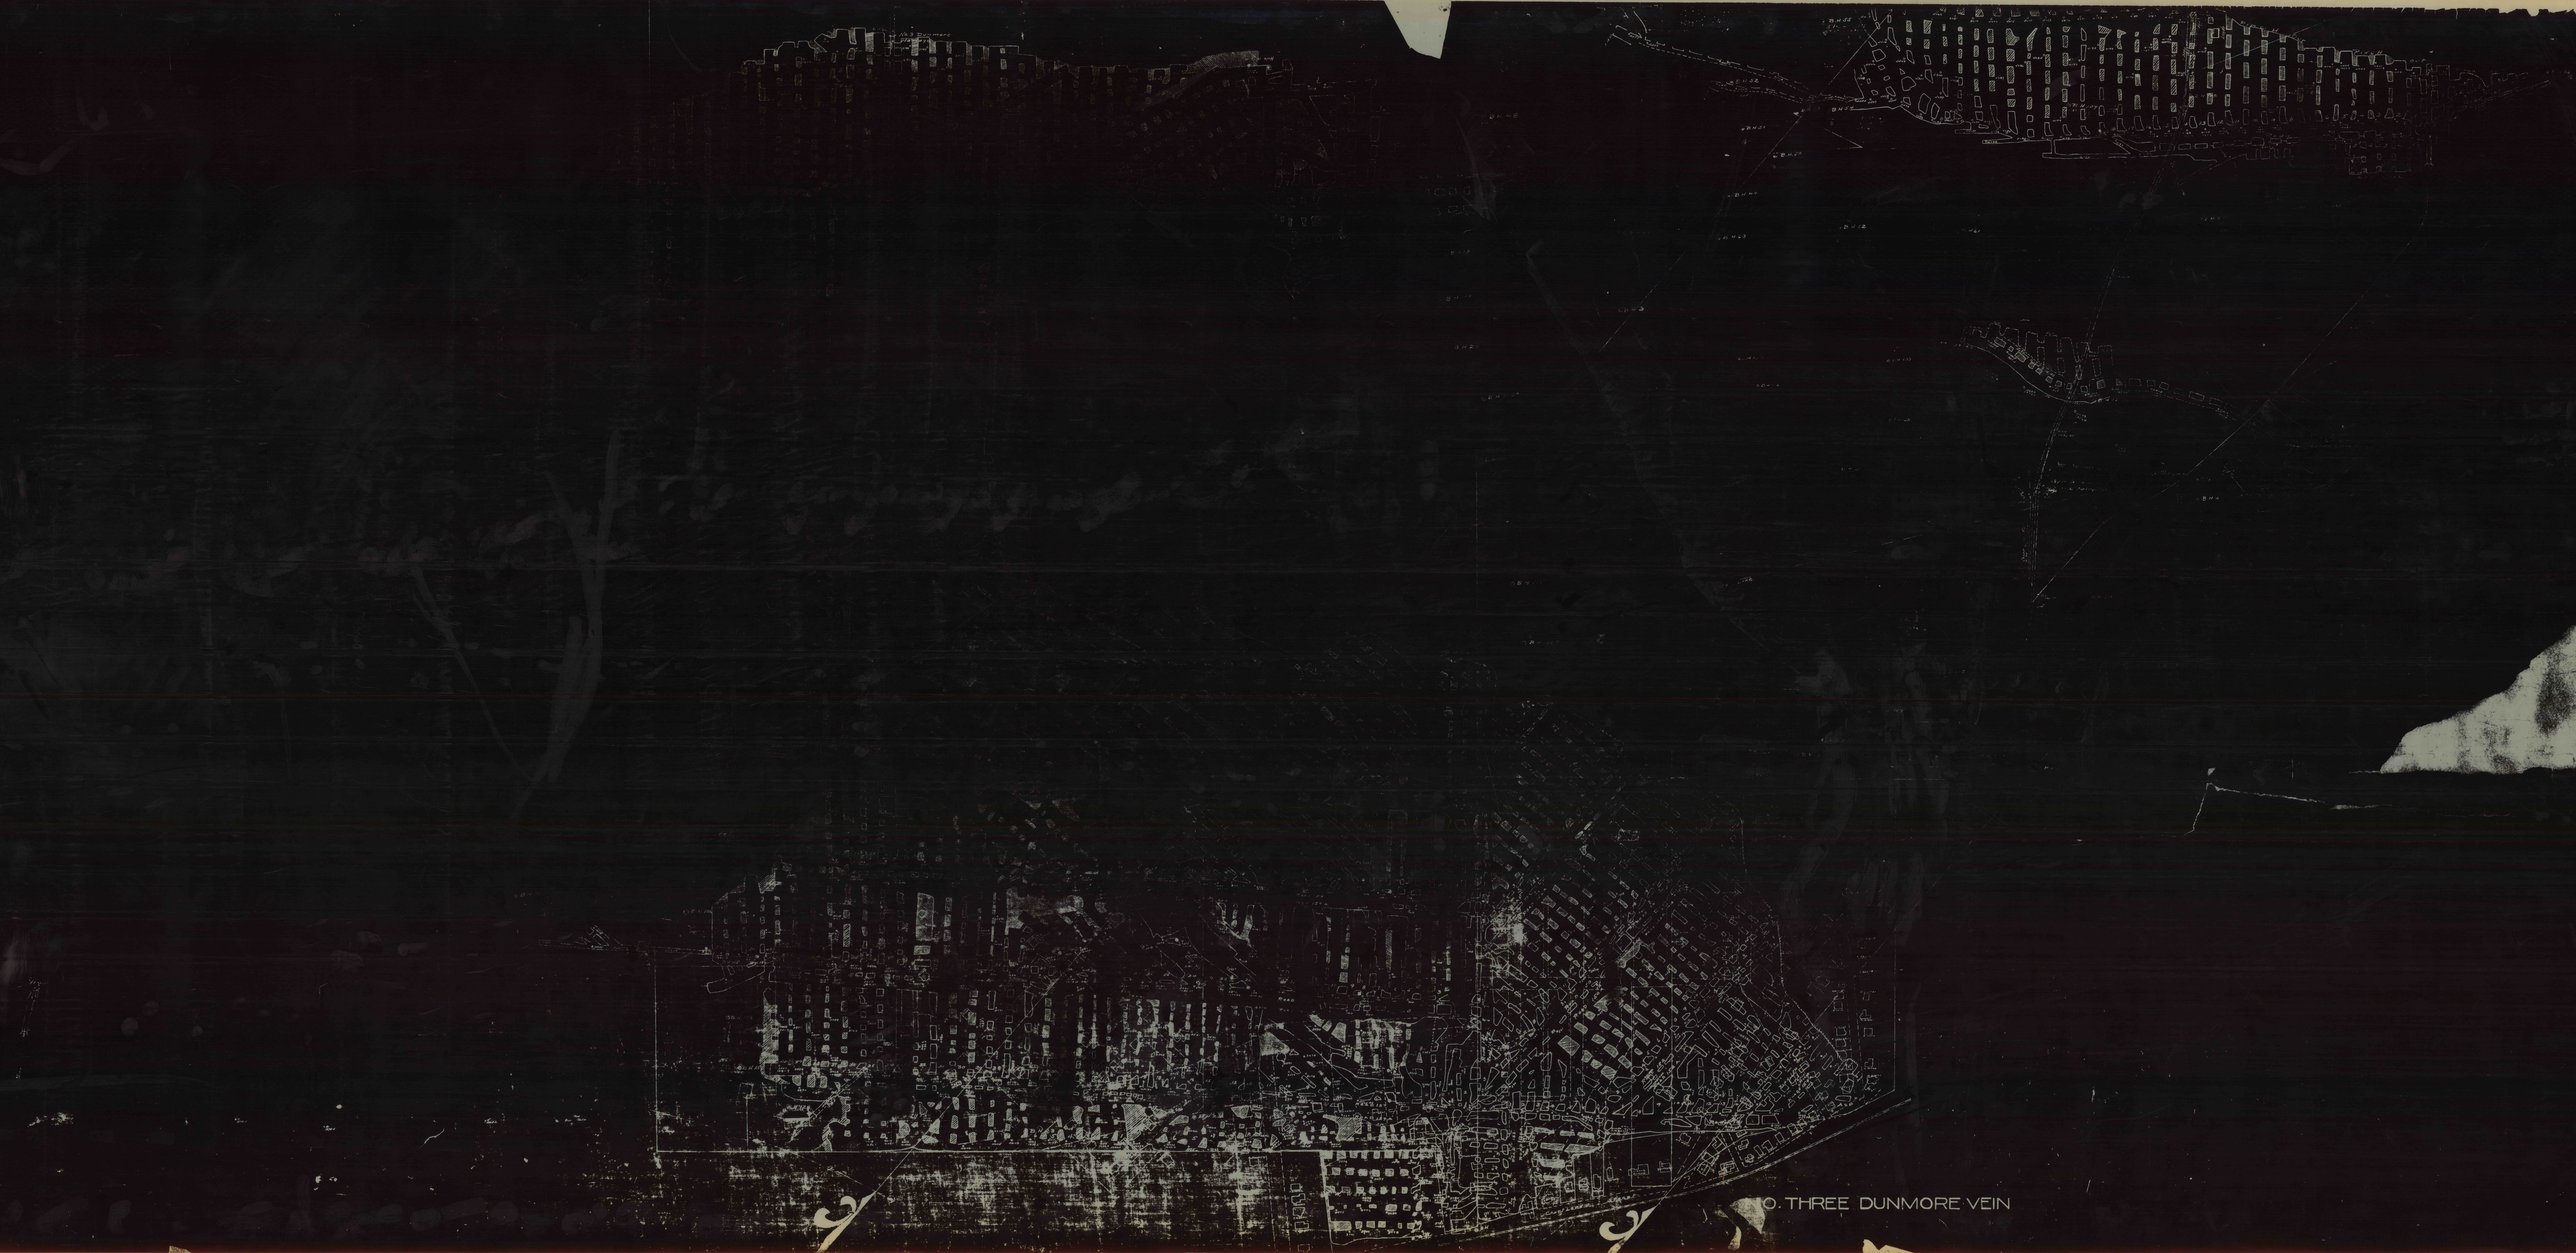
O. THREE DUNMORE VEIN