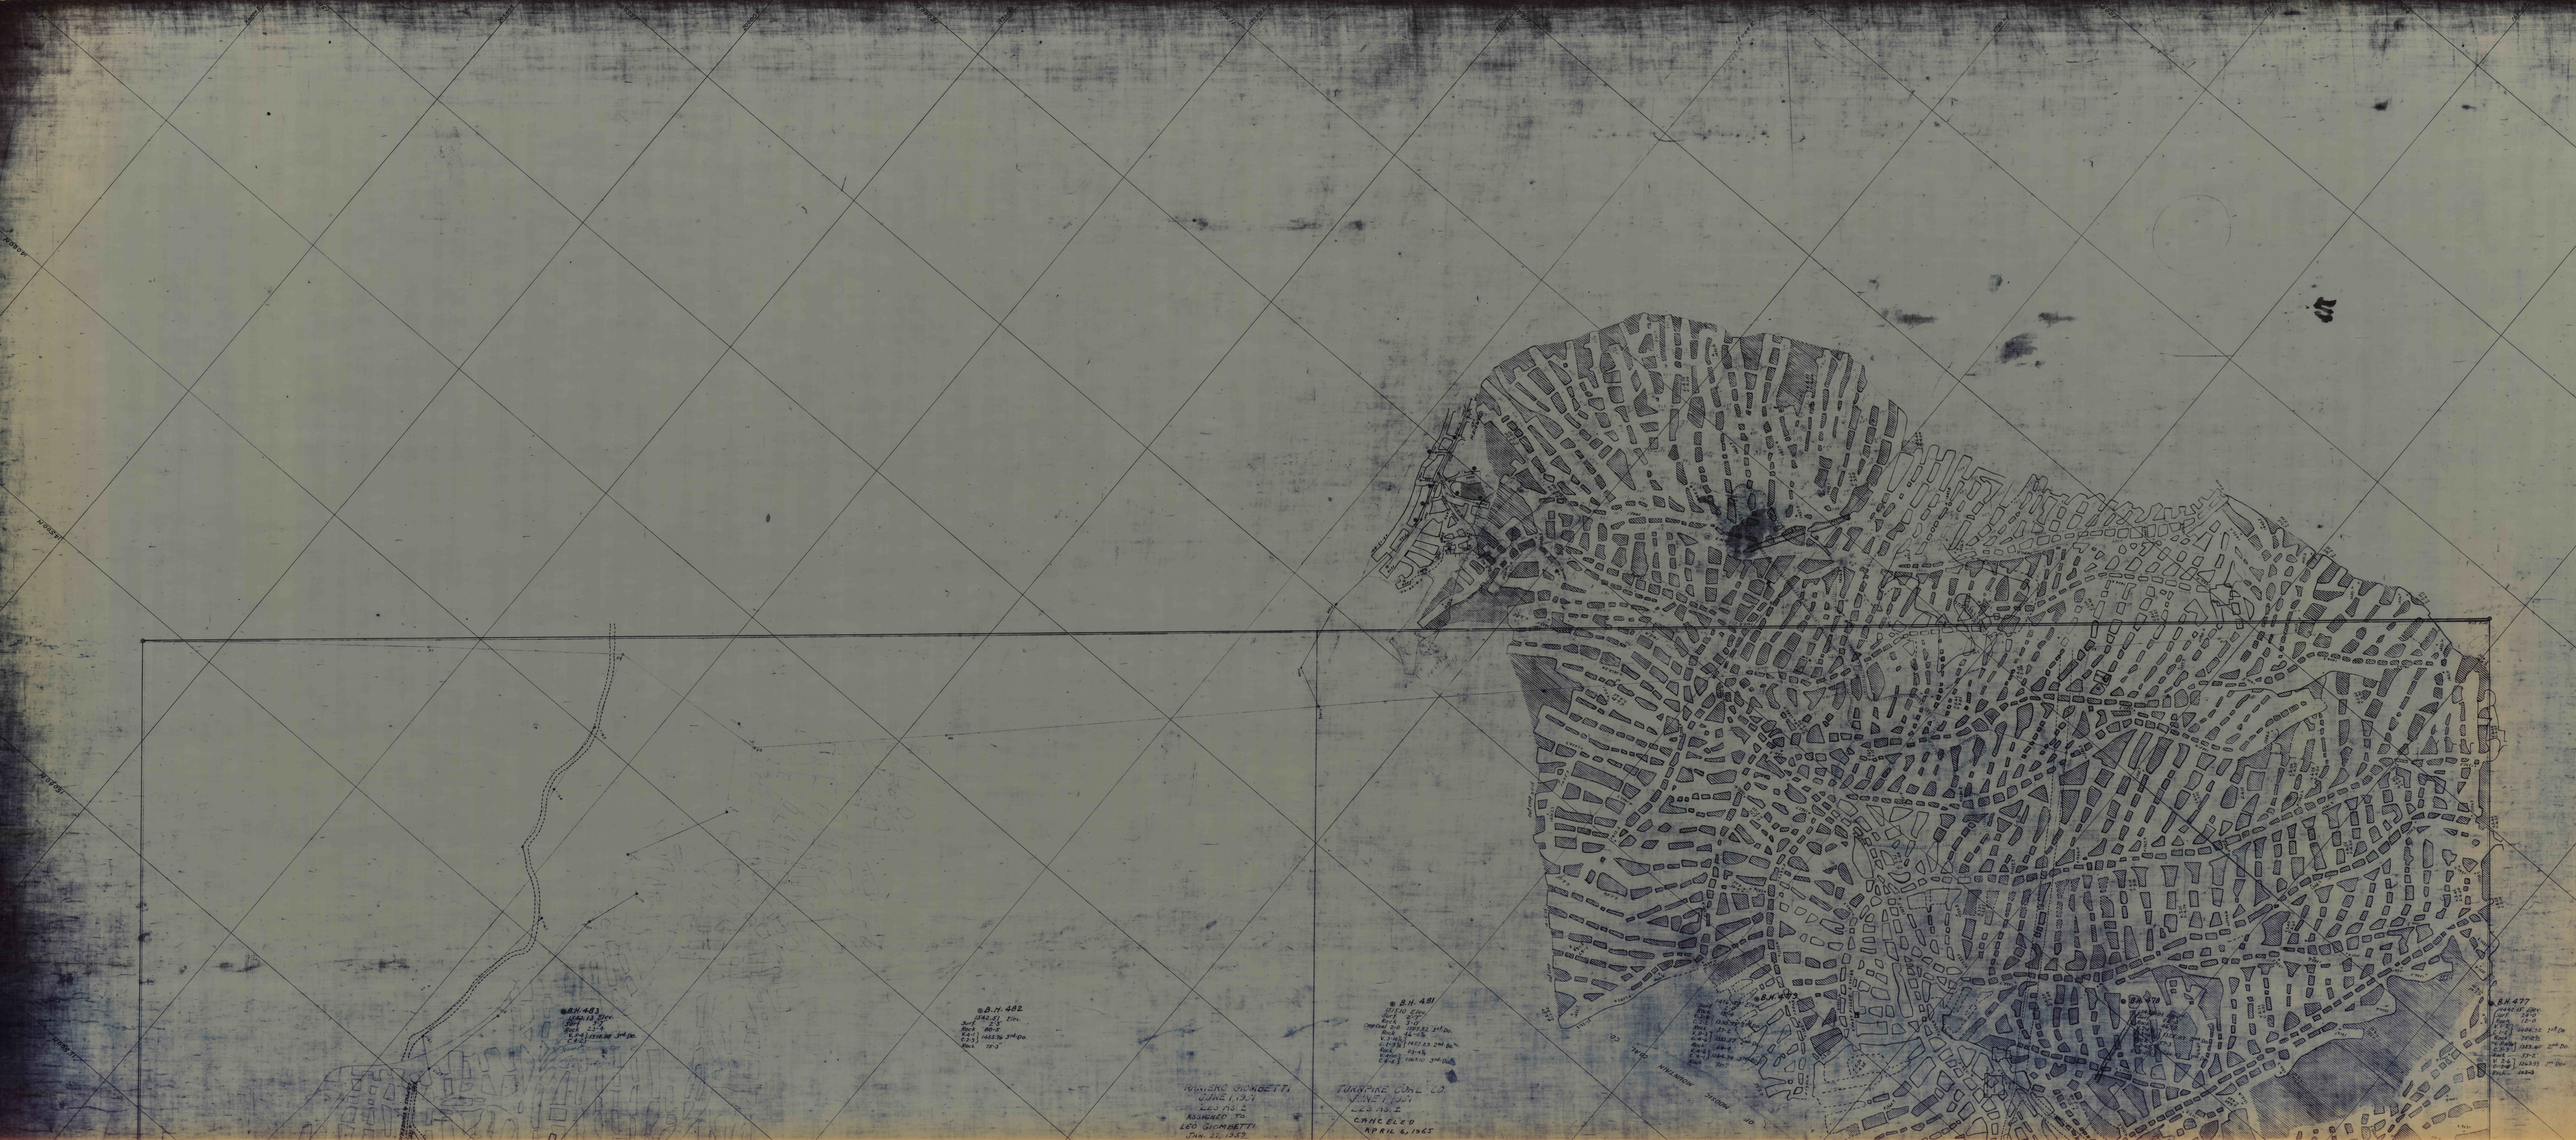
B.H. 482
B.H. 481
B.H. 477
RINALDO GIOMBETTI
JUNE 1, 1951
LEO 19-2
ASSIGNED TO
LEO GIOMBETTI
JAN. 22, 1952
TURNPIKE COAL CO
JUNE 1, 1951
LEO 19-2
CANCELED
APRIL 6, 1965