


15047

No 2 DUNMORE VEIN
HUMBERT COAL CO. JESSUP PA.
SCALE 100 FT. = 1 IN.

15047

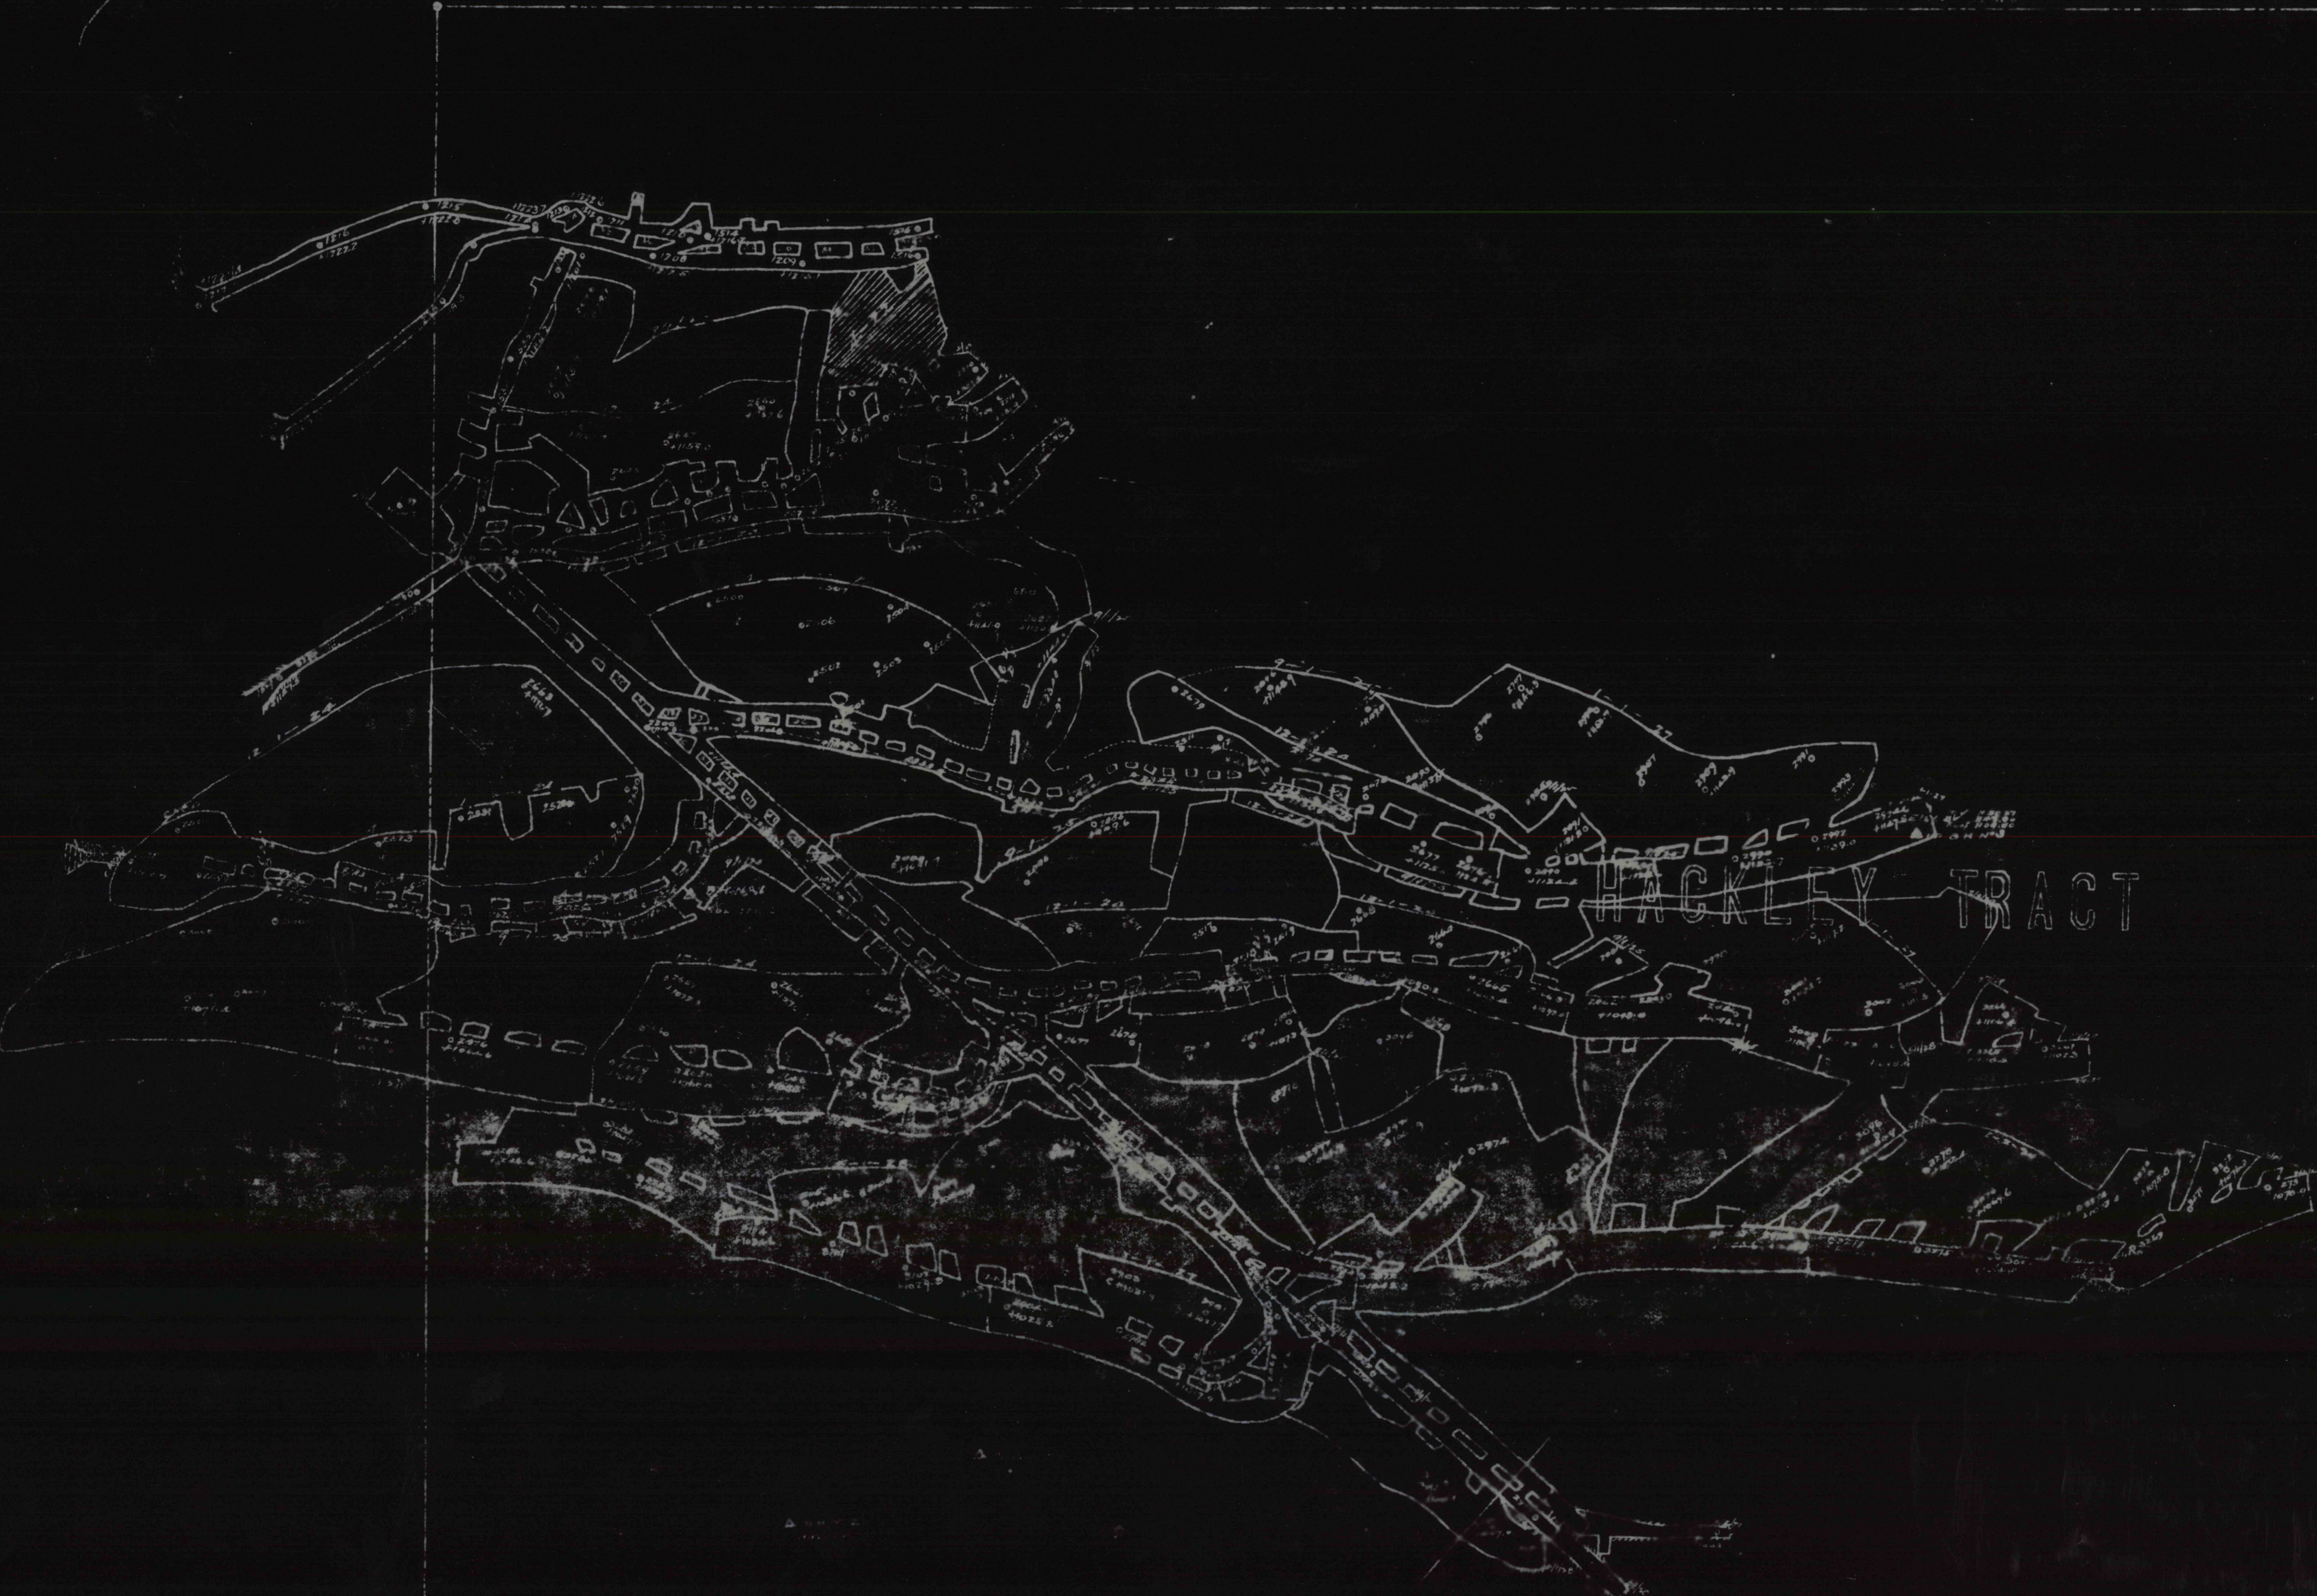

HACKLEY TRACT

15047

15047

