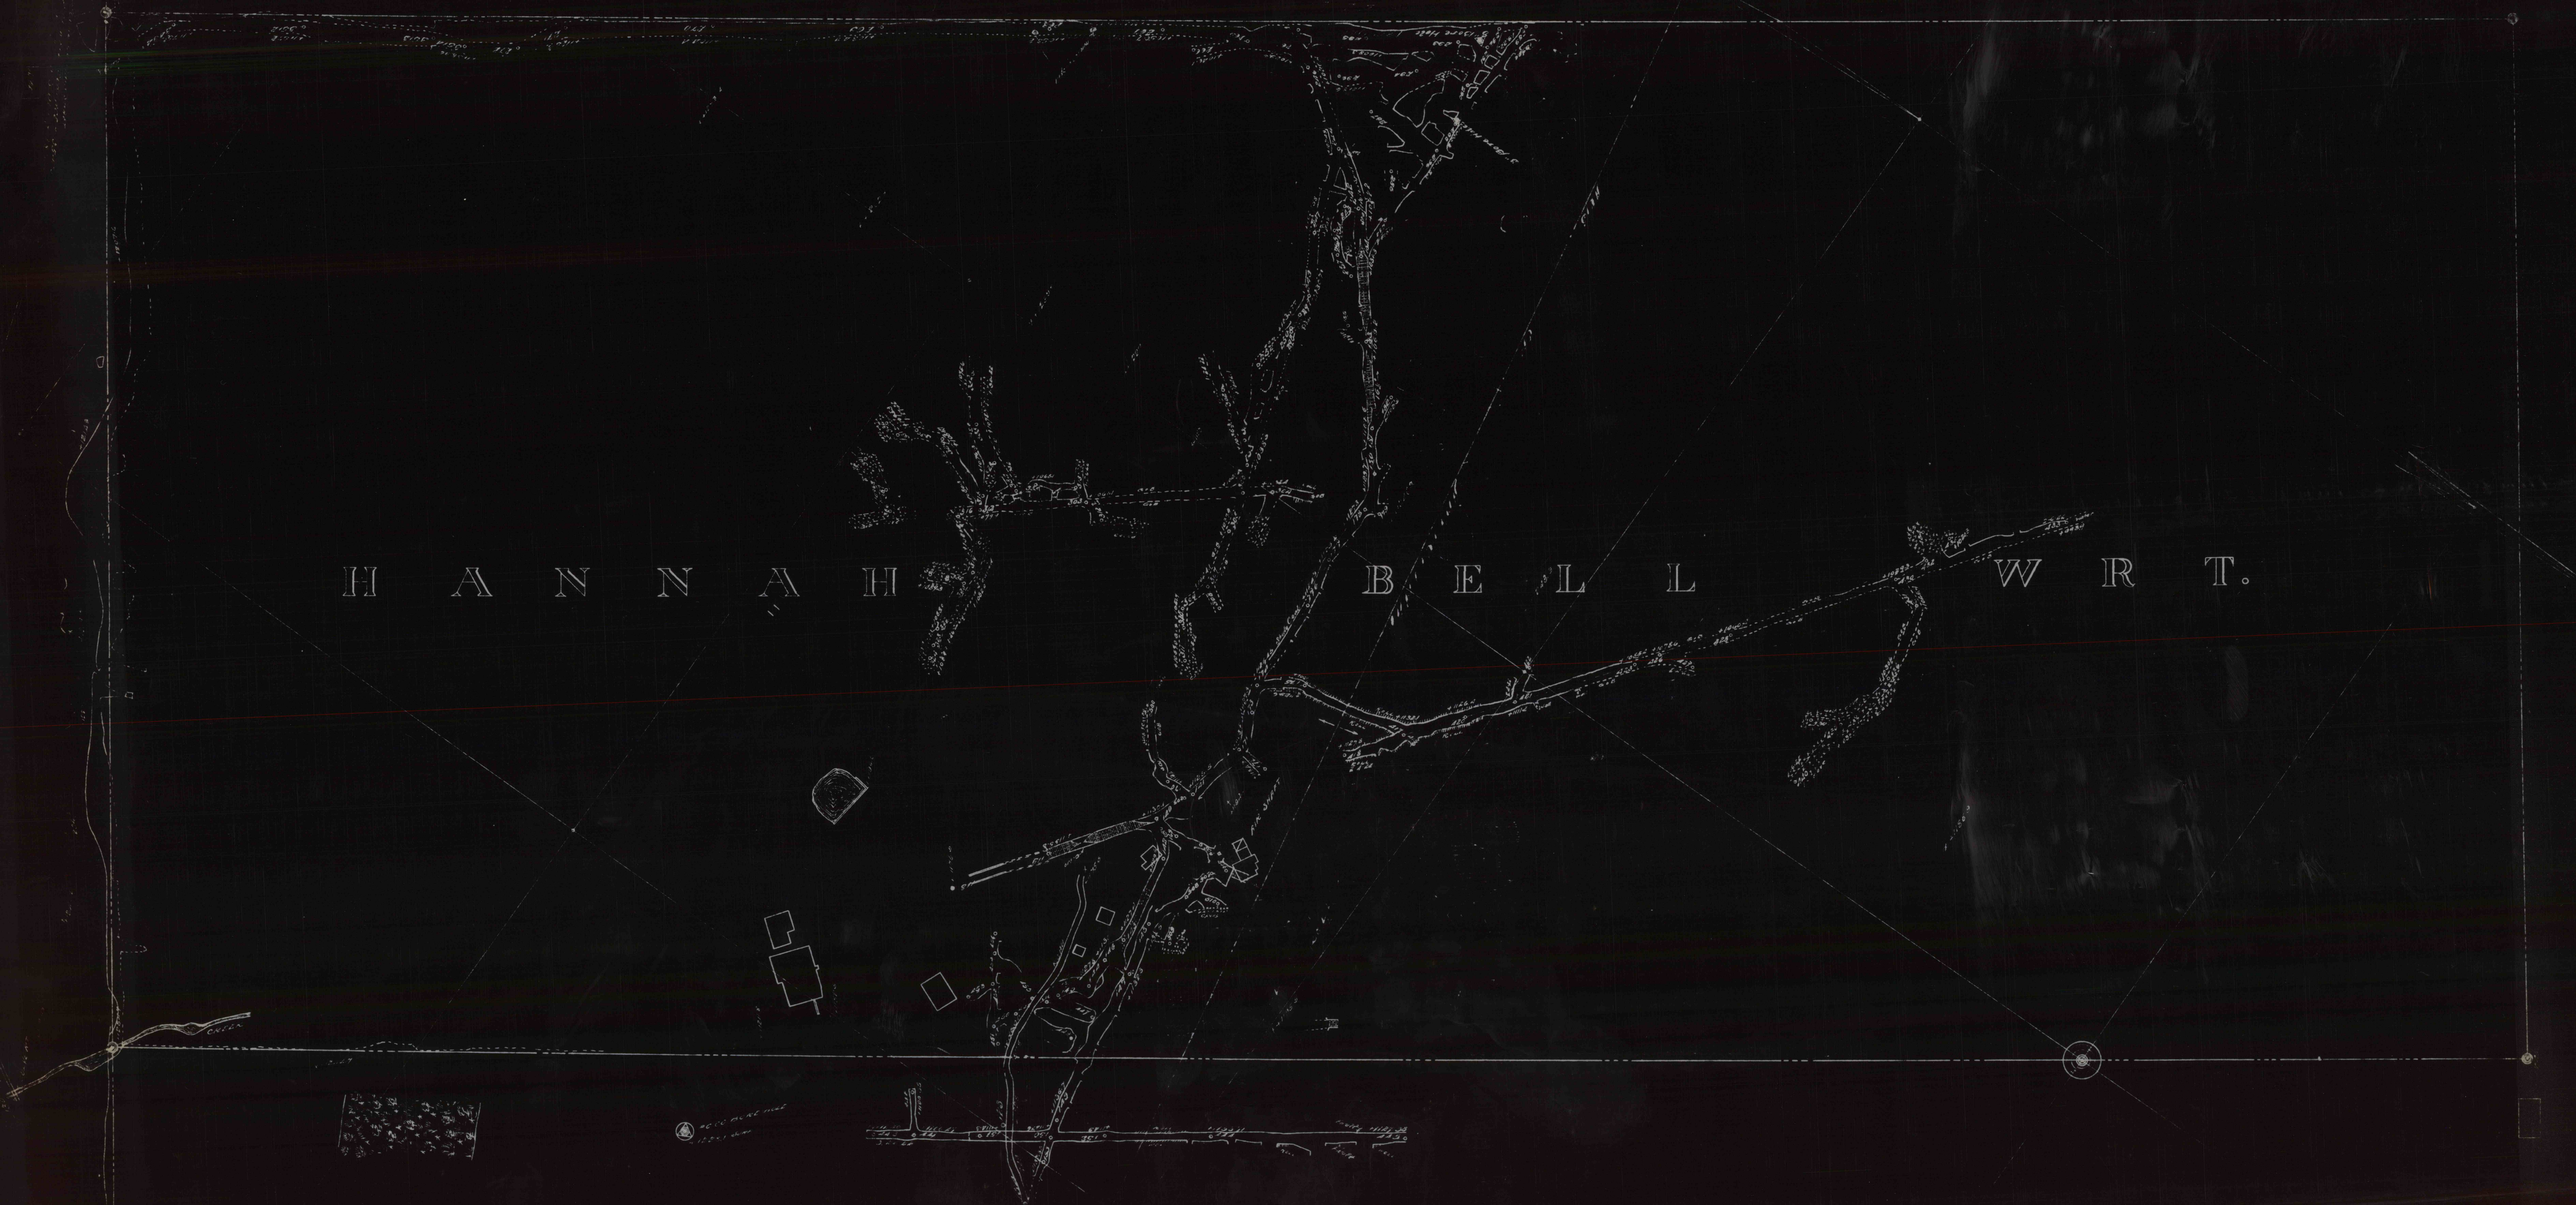
HANNAH BELL WRT.