


51-3  
5

JULY 1909  
JAN 1910  
JULY 1911  
AUG 1911  
MAY 1912

HANNAH BELL SLOPE WORKINGS  
DOLPH COAL CO  
WINTON, PA  
H.S. REETS ENGR  
WILKES-BARRE

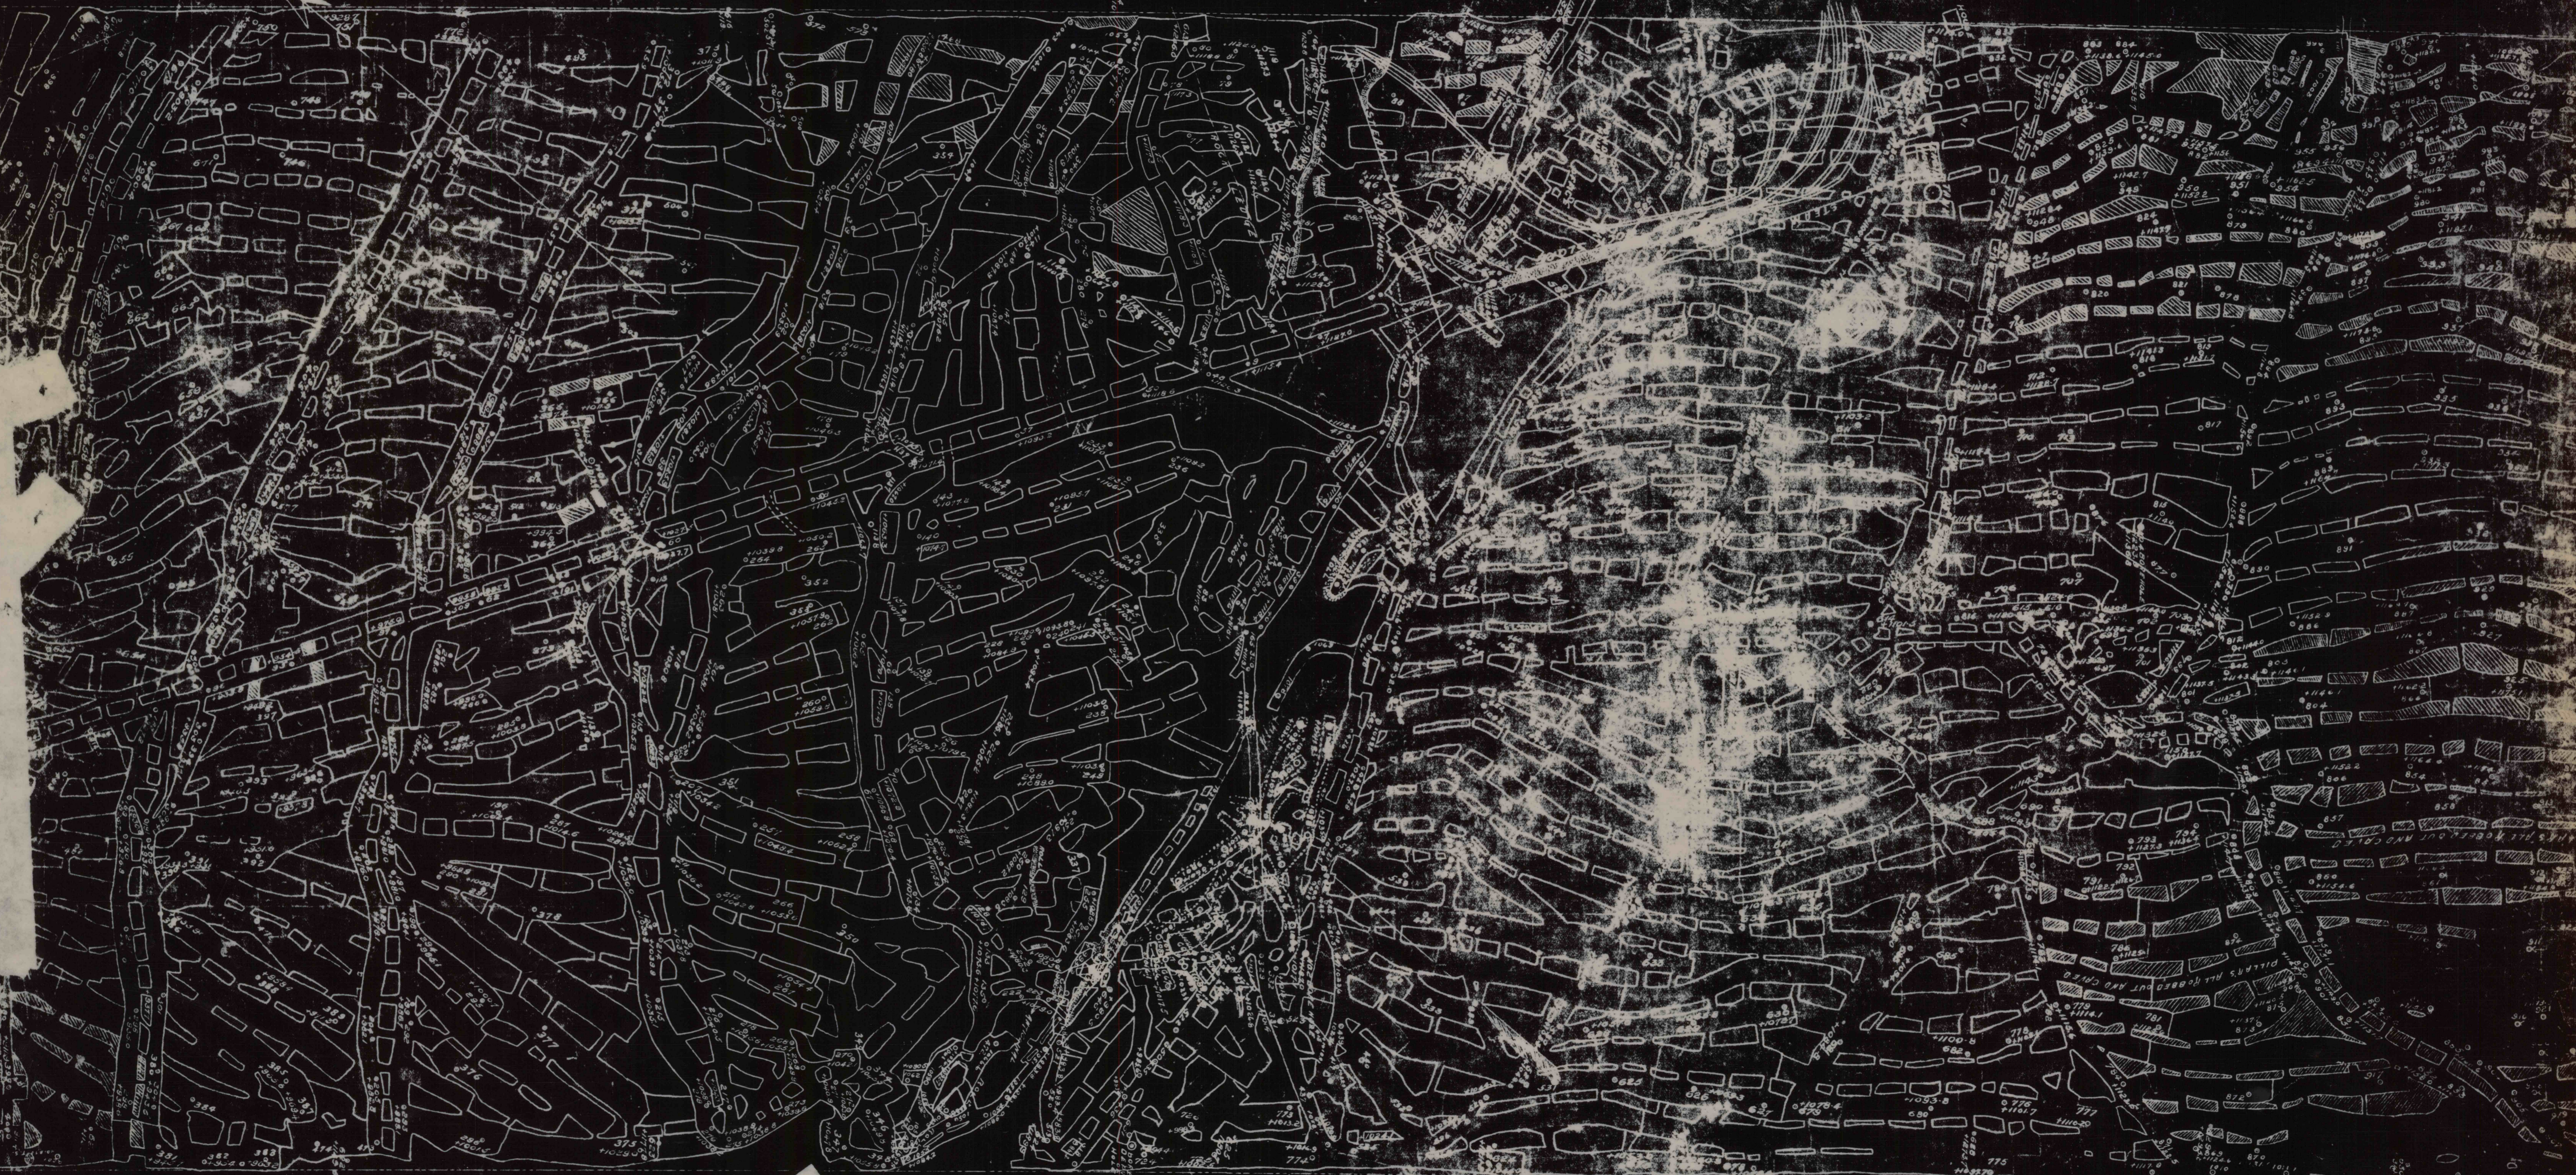

DILLON'S ALL ROBBED OUT AND CAGED  
DILLON'S ALL ROBBED OUT AND CAGED