

MAP


Showing Workings

IN
MILLS VEIN
 North West
 Coal Co.

CARBONDALE PA
 SCALE 400' = 1" IN.
 MAR. 1906

Date of posting


Dec.	1906
Oct.	1907
June	1908
Jan.	1909
Sept.	1910
April	1910
Nov.	1910
June	1911
Feb.	1912
Nov.	1916 Abandoned

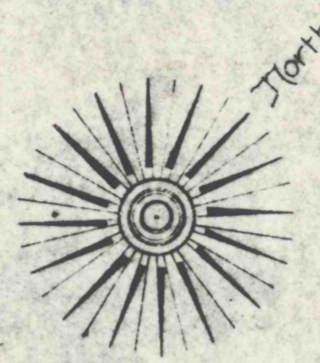

HUDSON
 DELAWARE

DELAWARE

HUDSON

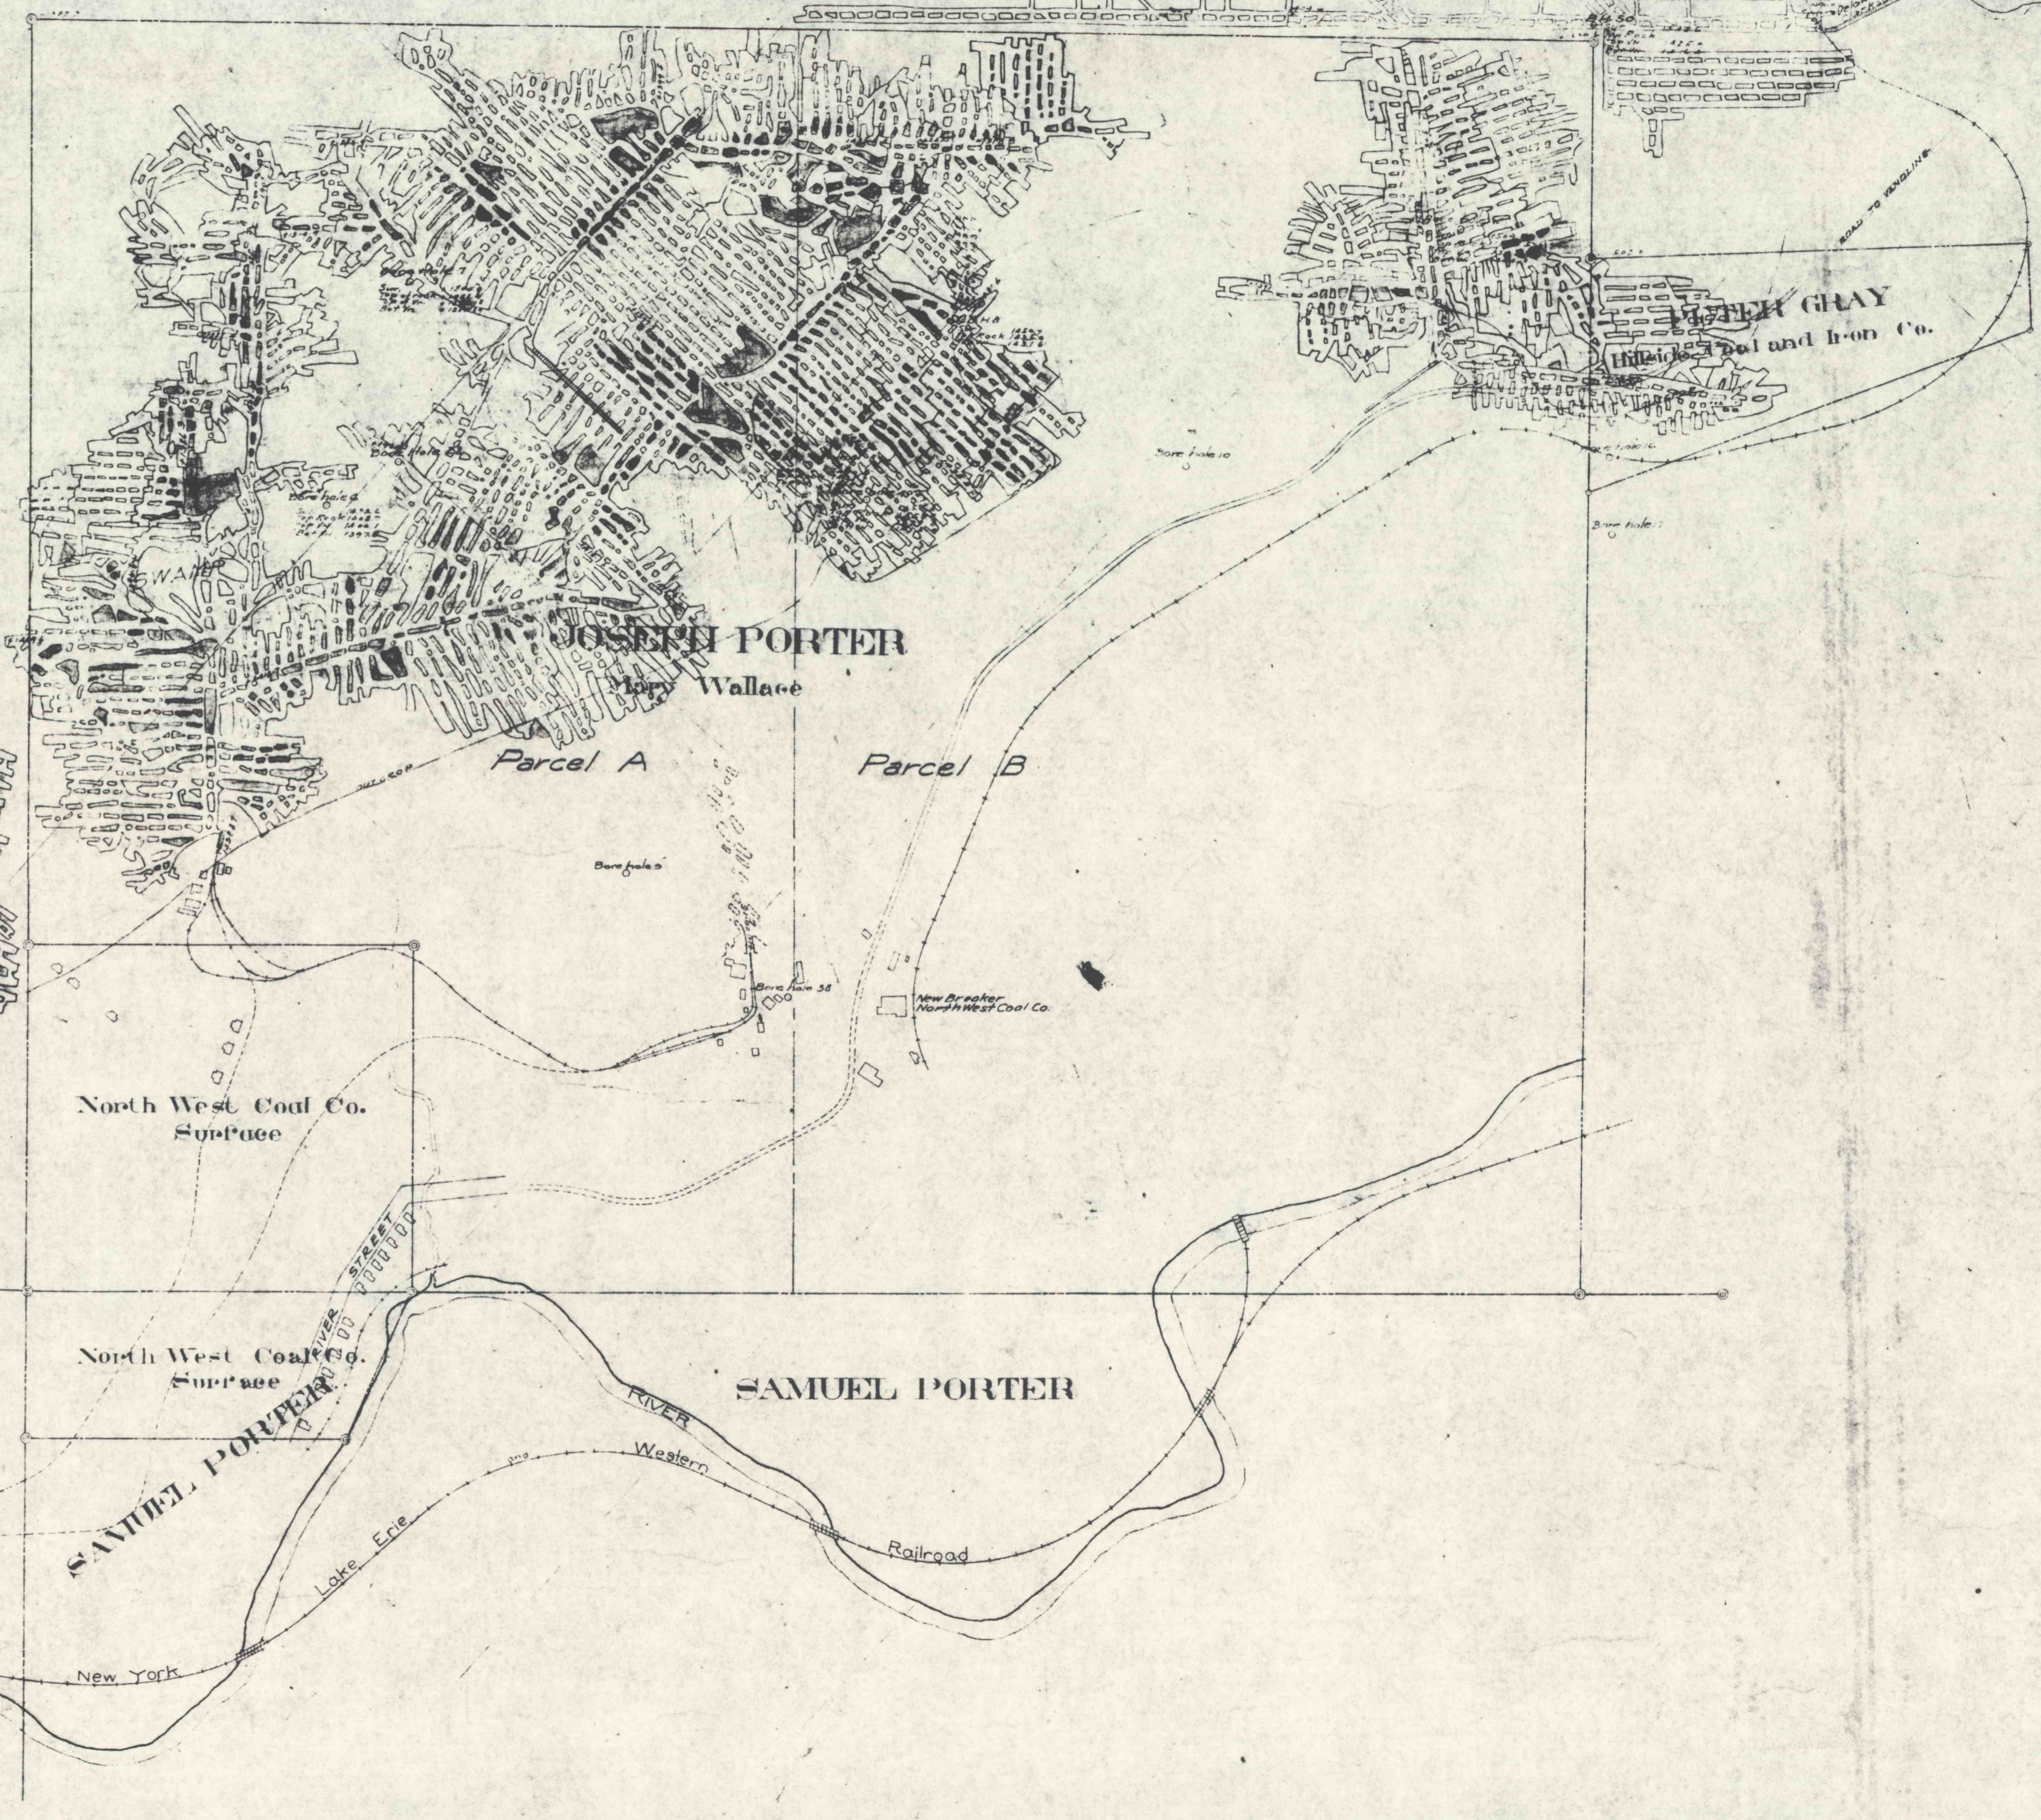

DELAWARE & HUDSON MORSE HILL COAL CO.

