


WALTER PORTER WARRANT  
MORRSE EST.

FREDRICK PORTER WARRANT.  
D. & H. CO.

Posted to Oct 1-98  
Feb. 25-99  
Aug. 11-99  
Sept 1-99  
Feb 1-00

Last pillar No. = 26612  
X 2 = 26614  
X 3 = 26594  
X 4 = 26588

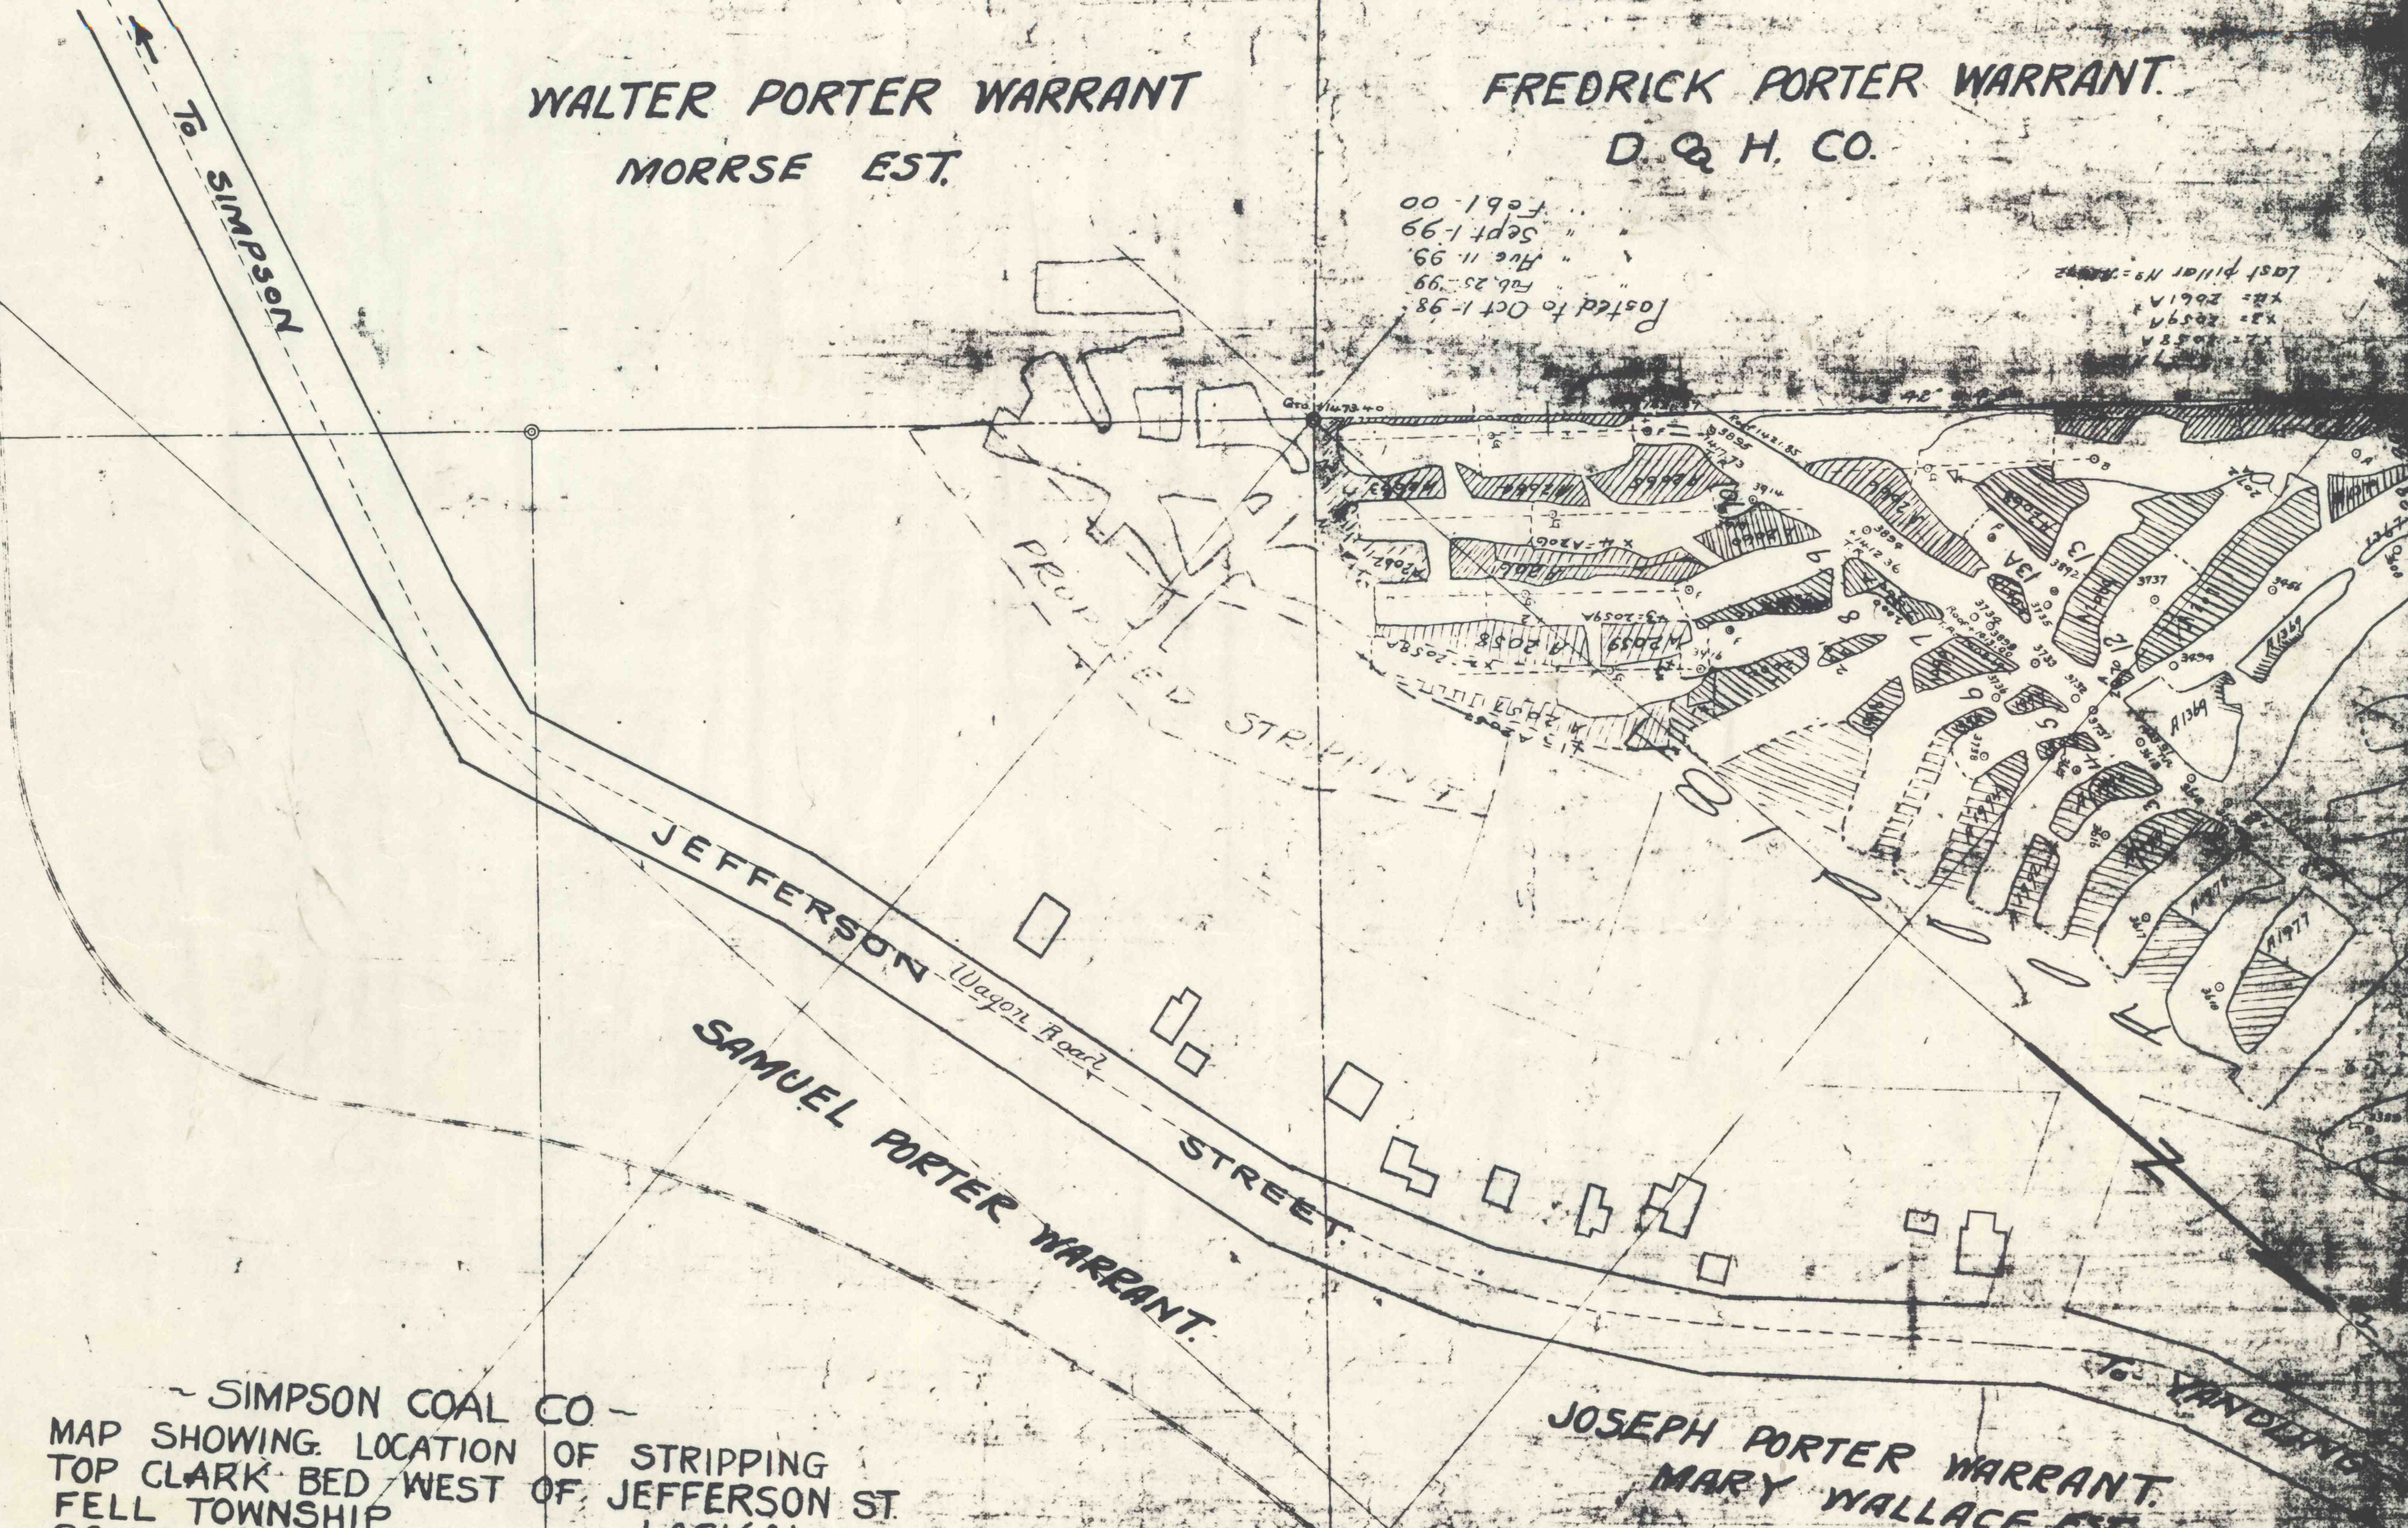

SIMPSON COAL CO.  
MAP SHOWING LOCATION OF STRIPPING  
TOP CLARK BED WEST OF JEFFERSON ST.  
FELL TOWNSHIP LACKA' CO.  
SCALE 1"=100'  
8-8-1947

JOSEPH PORTER WARRANT.  
MARY WALLACE EST.