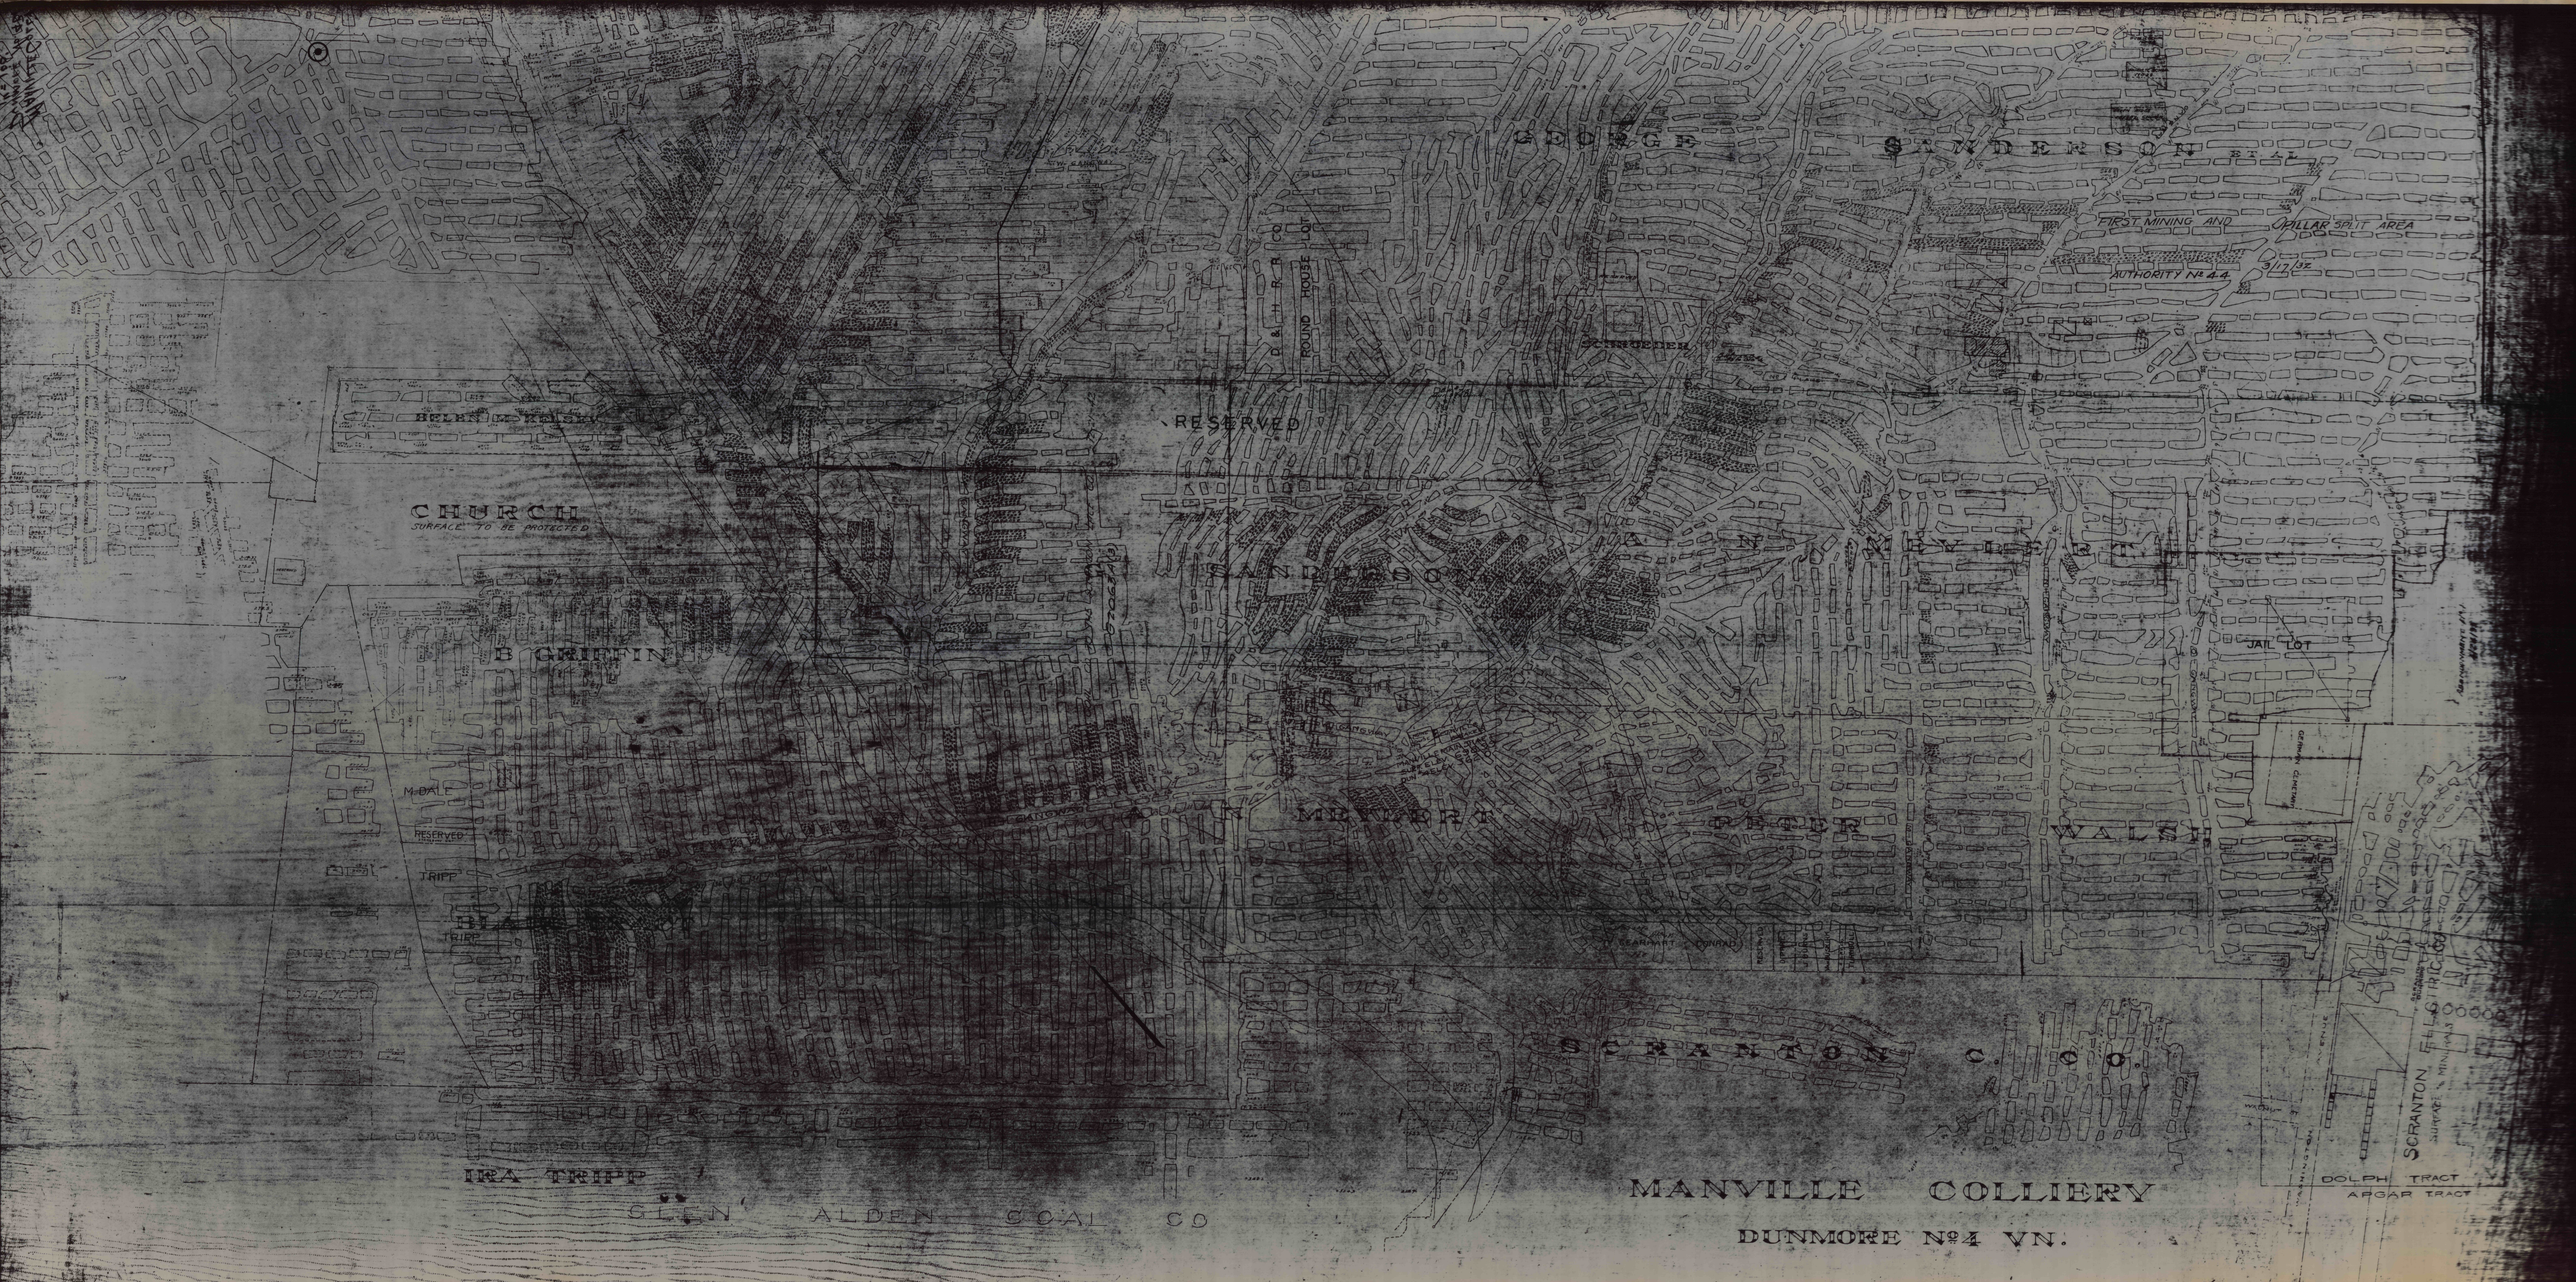
GEORGE SANDERSON ESTATE
FIRST MINING AND PILLAR SPLIT AREA
AUTHORITY No 44
3 1/2 OZ
SCHUETER
D & H R R CO
ROUND HOUSE LOT
RESERVED
CHURCH
SURFACE TO BE PROTECTED
BELIN
B GRIFFIN
SANDERSON
A N D R E W
JAIL LOT
M-DALE
RESERVED
TRIPP
BLAKE
TRIPP
MEYLERT
PETER WALSH
SCRANTON C. C. CO.
IRA TRIPP
GLEN ALDEN COAL CO
MANVILLE COLLIERY
DUNMORE No 4 VN.
SCRANTON FUEL & MFG CO
DOLPH TRACT
ARGAR TRACT