
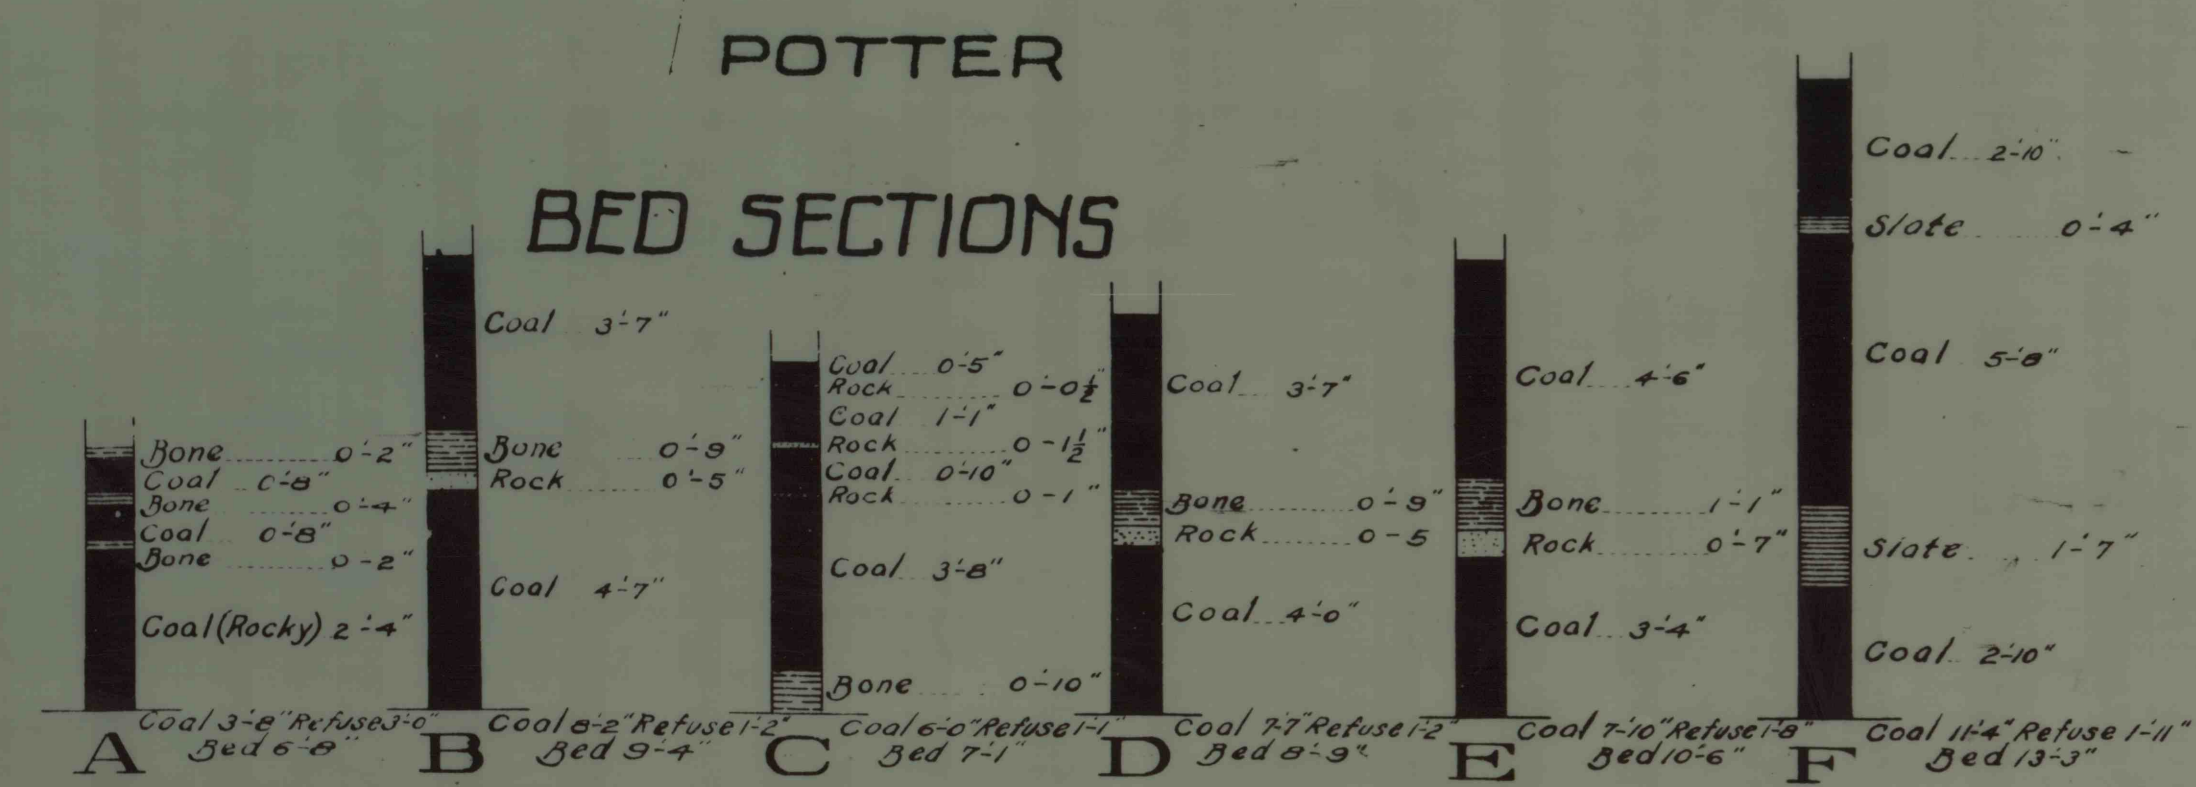


31310

 

THE HUDSON COAL CO.
PROVIDENCE DIVISION
 (MARVINS-DICKSON-MANVILLE COLLIERIES)
 WORKINGS IN THE
14-FOOT-BED
 Scale: 1" = 400'

Note: Adjoining Workings are transferred from Maps of various Coal Cos.
 Office of Forecast Department
 Scranton, Pa.
 May, 1920